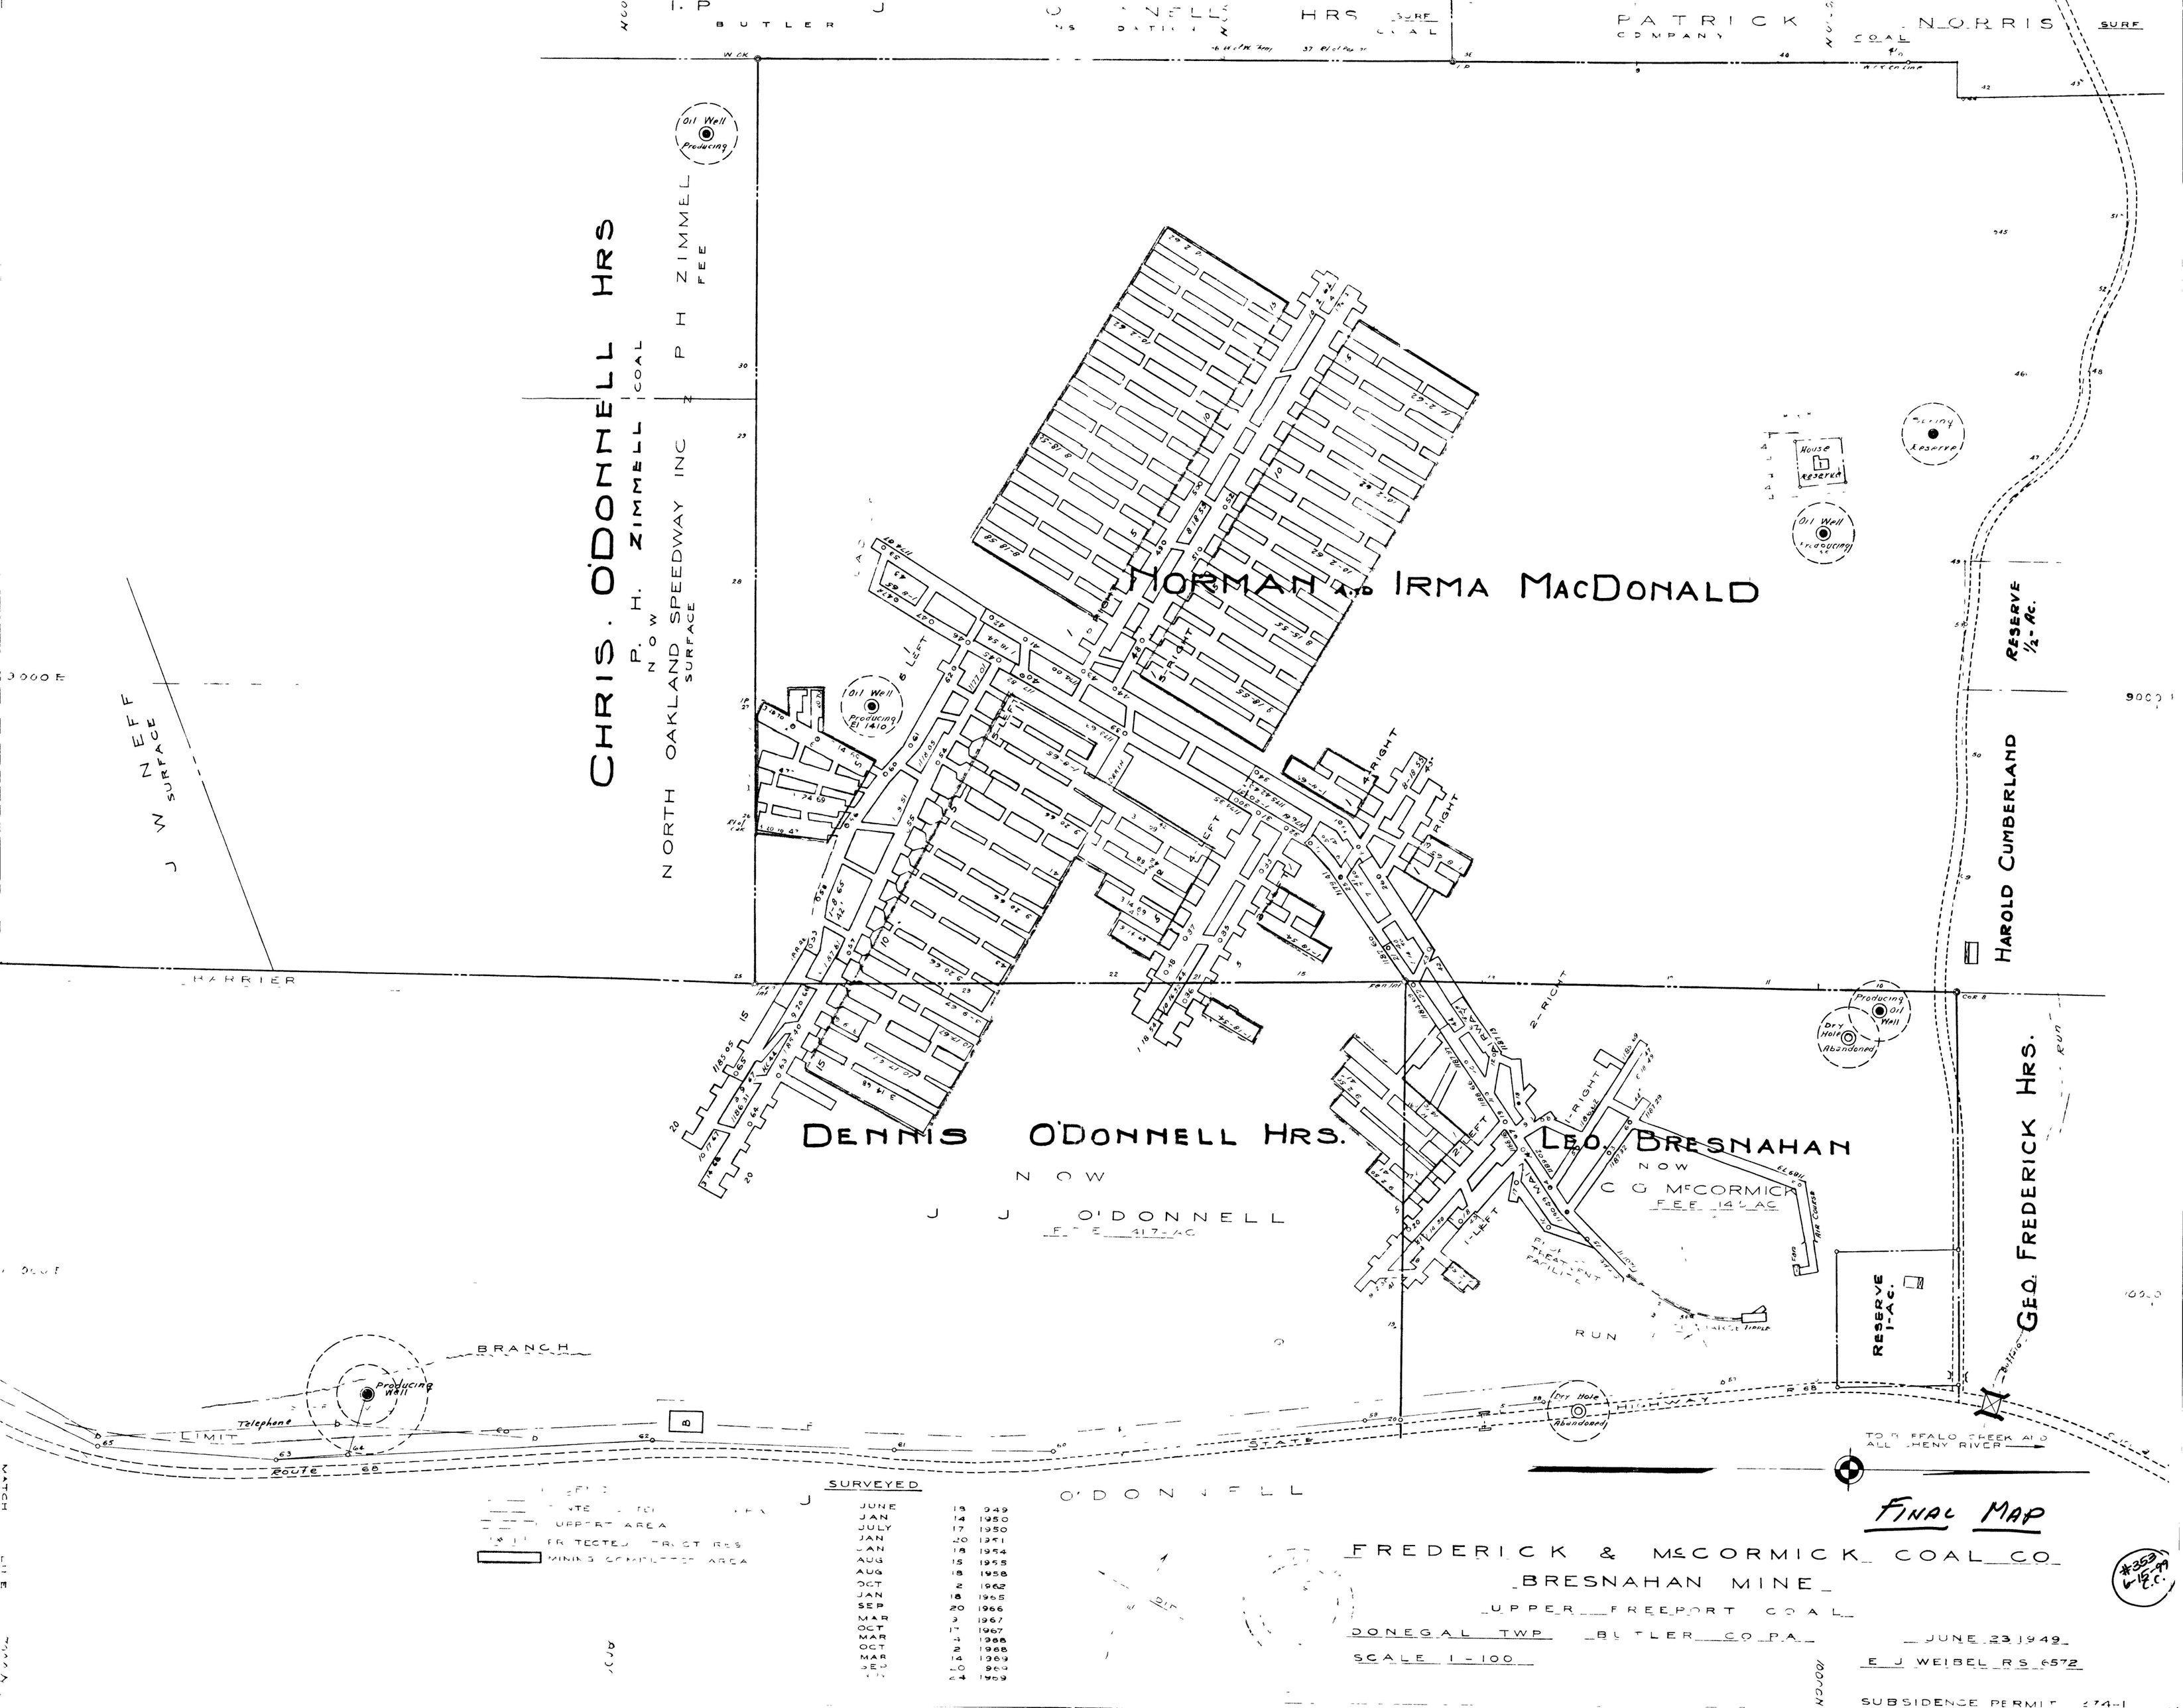
BUTLER
PATRICK COMPANY
NORRIS
CHRIS. O'DONNELL HRS
P. H. ZIMMELL
NOW
NORTH OAKLAND SPEEDWAY INC
SURFACE
P H ZIMMELL
FEE
HORMAN AND IRMA MACDONALD
J W NEFF
SURFACE
HARRIER
DENNIS O'DONNELL HRS.
NOW
J J O'DONNELL
FEE 417 AC
LEO. BRESNAHAN
NOW
C G McCORMICK
FEE 14 AC
HAROLD CUMBERLAND
GEO. FREDERICK HRS.
RESERVE 1/2 AC.
RESERVE 1 AC.
BRANCH
RUN
STATE HIGHWAY
ROUTE 68
LIMIT
Telephone
Producing Well
Dry Hole Abandoned
Oil Well Producing
House Reserve
Spring Reserve
TO BUFFALO CREEK AND ALLEGHENY RIVER
SURVEYED
JUNE 19 1949
JAN 14 1950
JULY 17 1950
JAN 20 1951
JAN 18 1954
AUG 15 1955
AUG 18 1958
OCT 2 1962
JAN 18 1965
SEP 20 1966
MAR 3 1967
OCT 17 1967
MAR 4 1968
OCT 2 1968
MAR 14 1969
SEP 10 1969
24 1969
UPPER AREA
MINING COMPLETED AREA
FINAL MAP
FREDERICK & McCORMICK COAL CO.
BRESNAHAN MINE
UPPER FREEPORT COAL
DONEGAL TWP BUTLER CO PA
JUNE 23 1949
SCALE 1-100
E J WEIBEL RS 6572
SUBSIDENCE PERMIT 274-1
#353 V-12-77 C.C.