


P. J. O'DONNELL HRS
BUTLER CONSOLIDATED COAL
PATRICK NORRIS

N 0000

N 0000


N 0000

N 0000

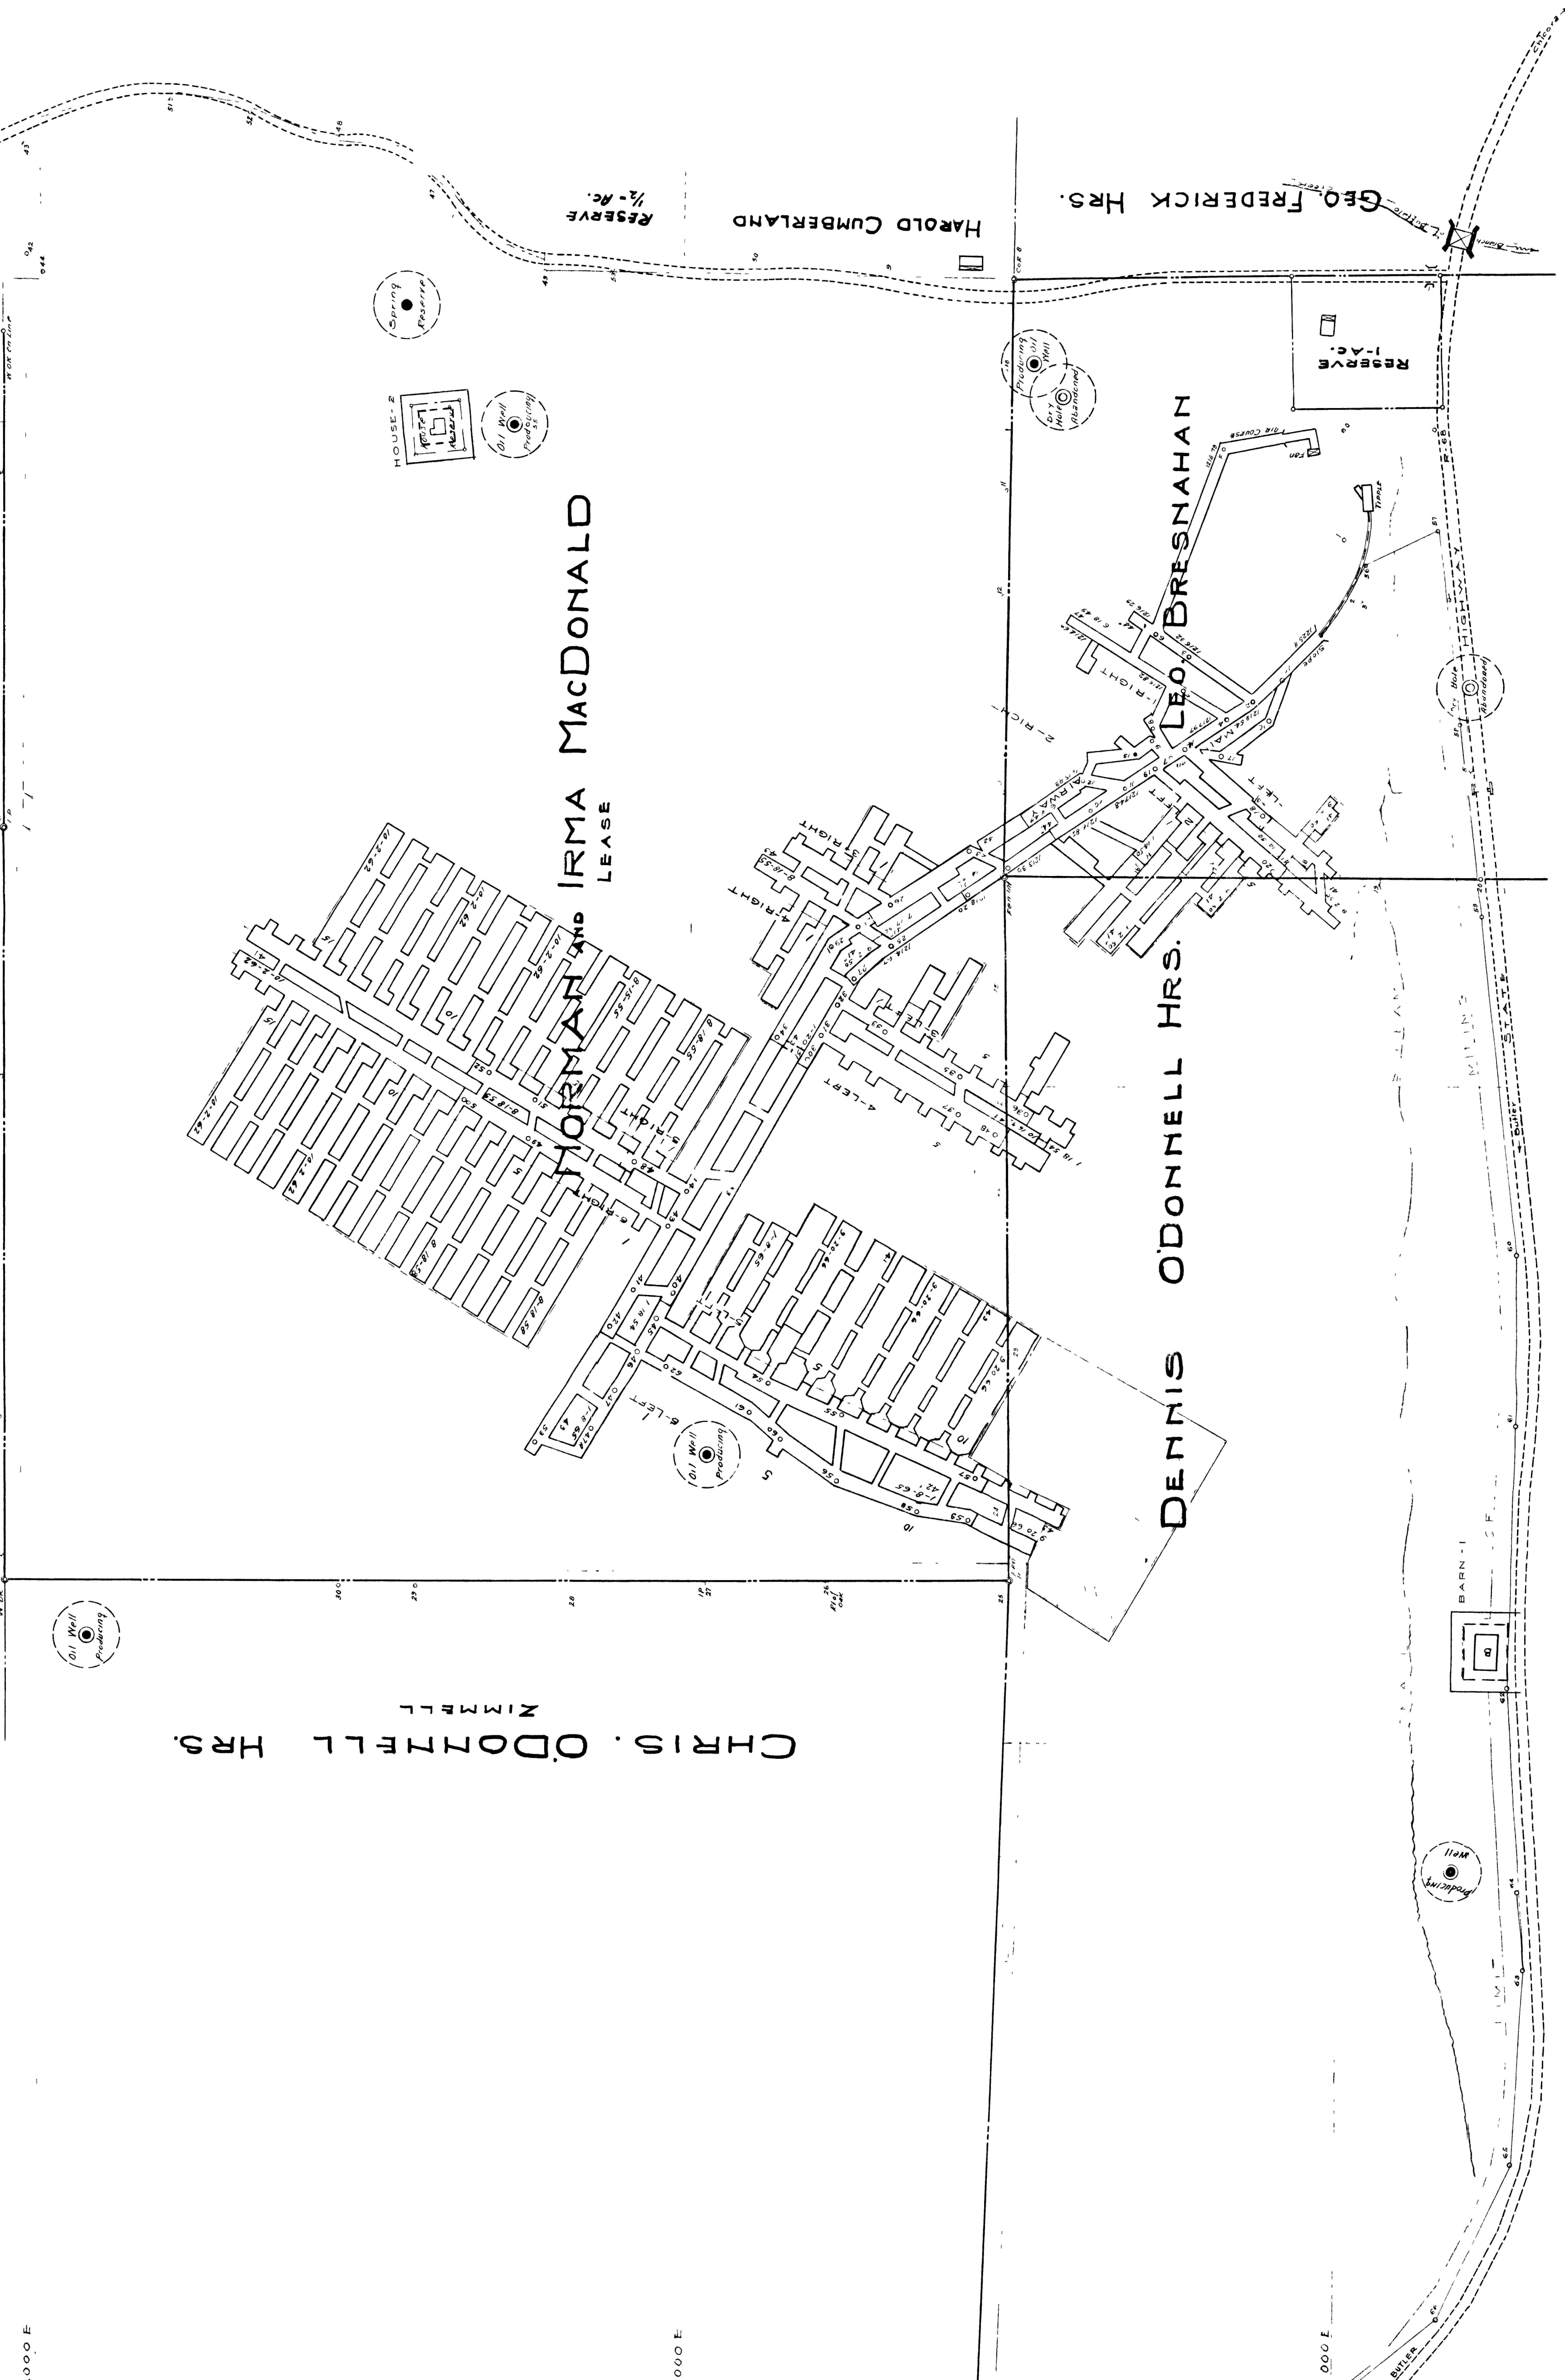


LEGEND
BOUNDARY LINES
COVERED MINING 2500 2500
BUILDING SUPPLY RT

FEB - 4 - 1947

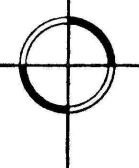

SURVEY MAP

Note -
Surveyed
Proposed Development

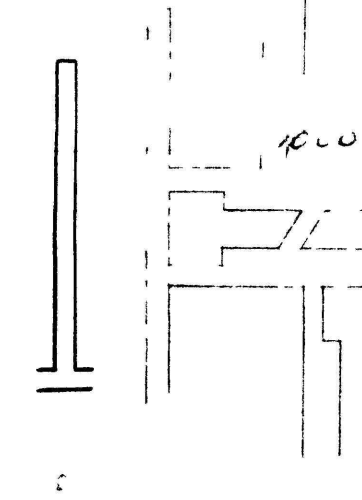

FREDERICK & McCORMICK COAL CO.
UPPER FREEDOM VEIN
DOWNEY TWP. BUTLER CO. PA
Scale 1"=100'
BRESNAHAN MINE
June 21/1949