


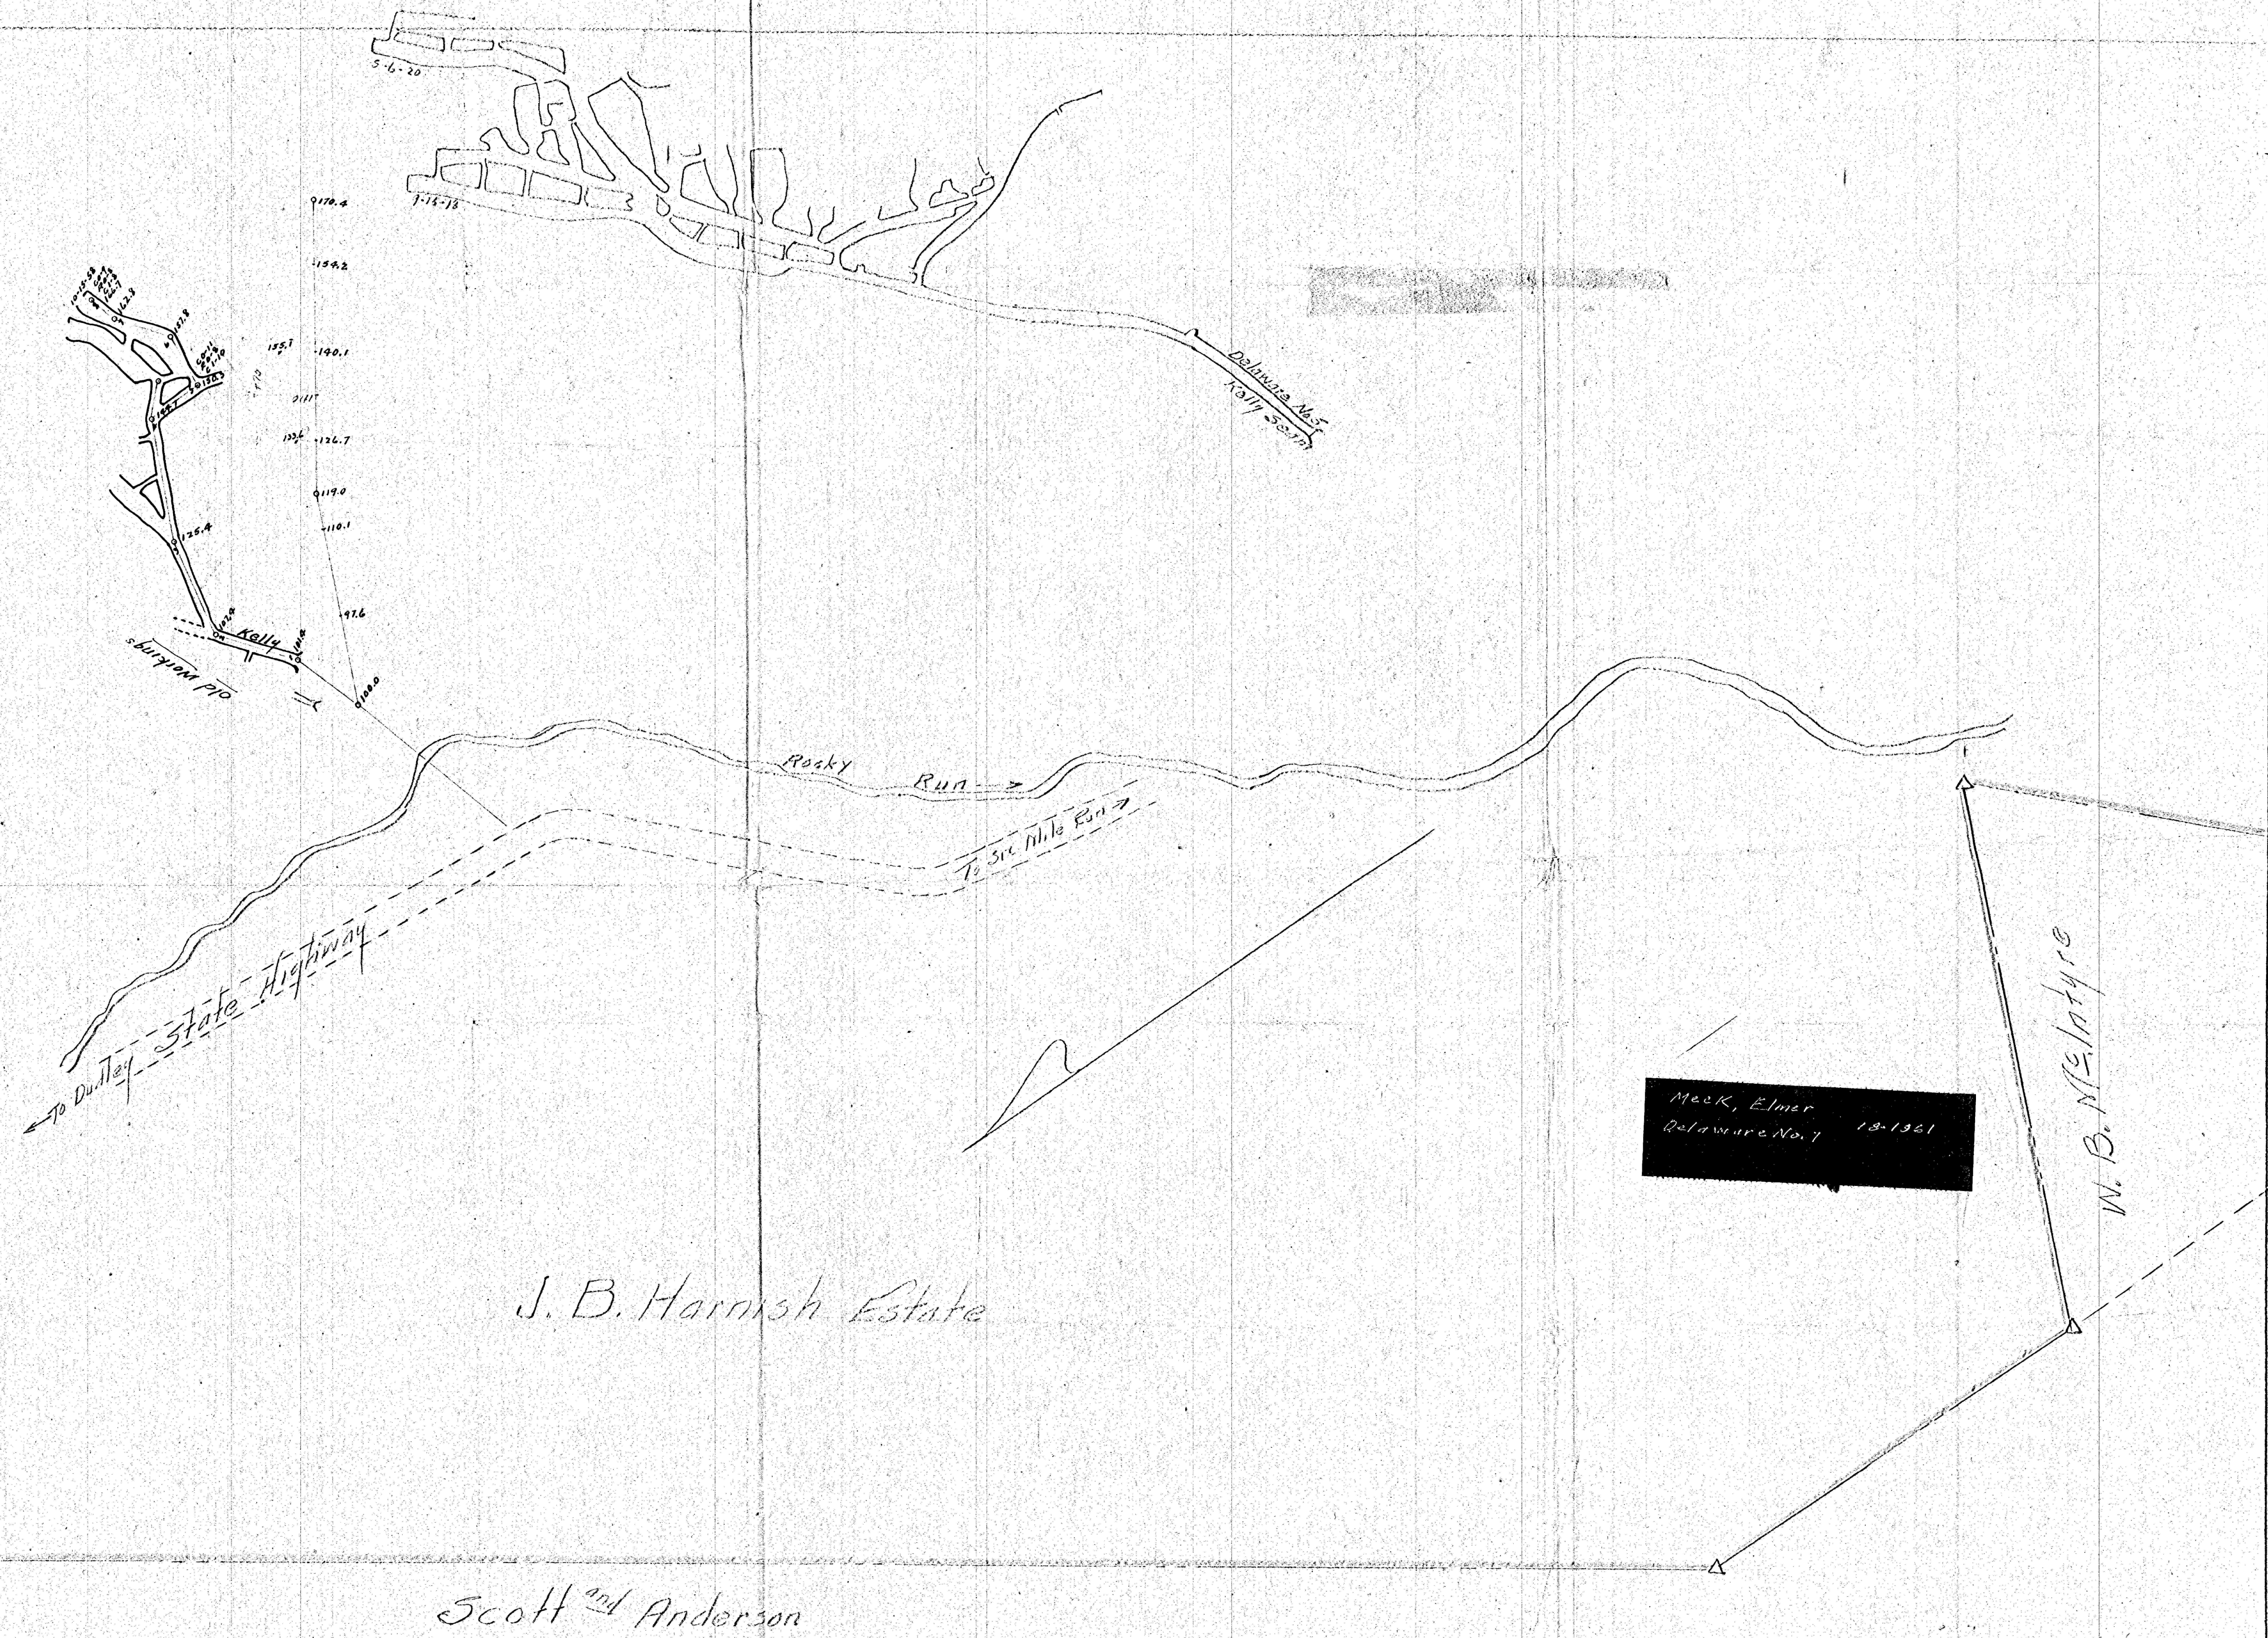

Map Showing Mine Workings of Elmer Meek on The Harnish Property Situated in Broad Top Twp Bedford Co. Penna. Oct. 1958 1"=100' E. Garrie Engr.