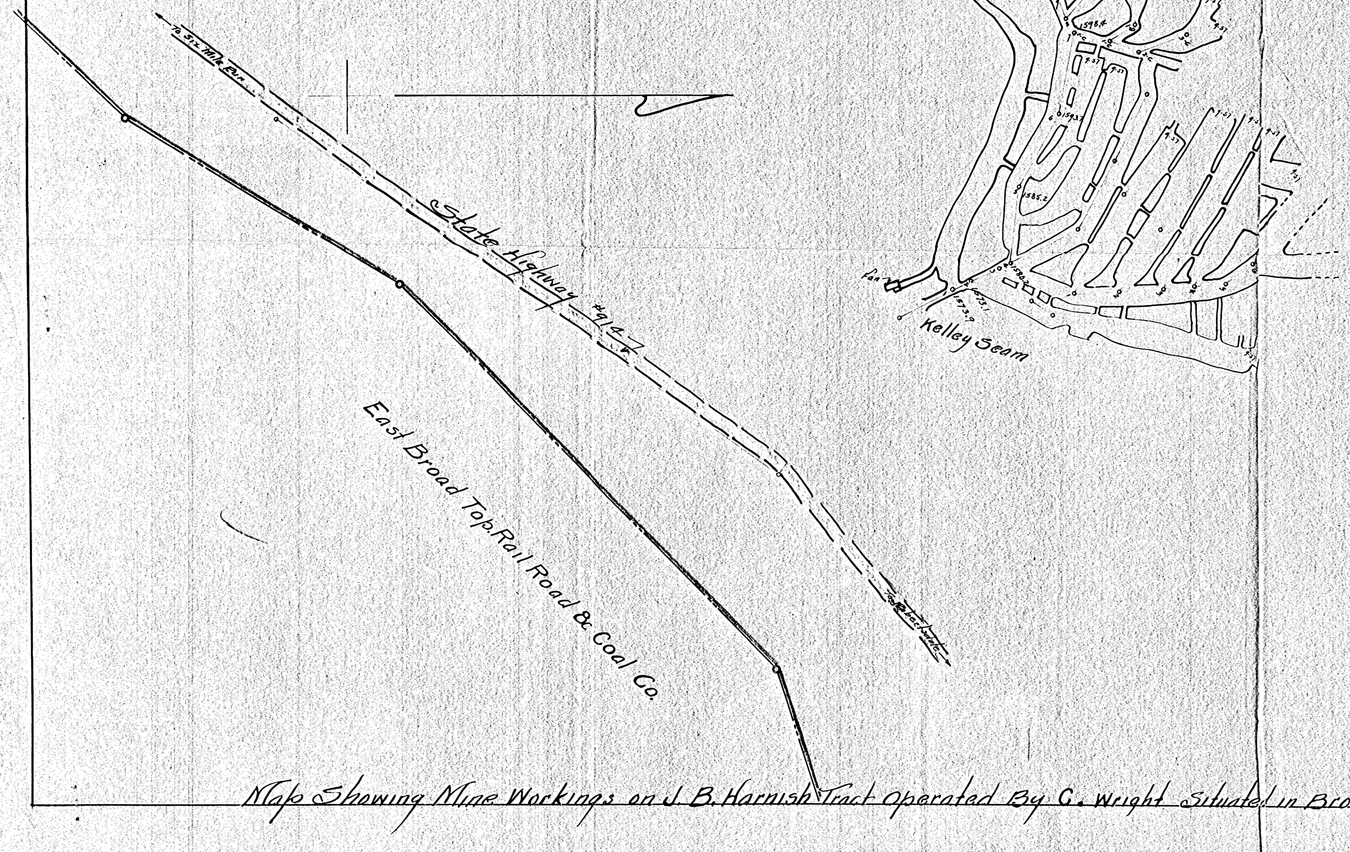

J. B. Harnish Tract

Hinish & Keitman
Wright 18-1961

Map Showing Mine Workings on J. B. Harnish Tract Operated By C. Wright Situated in Broad Top Twp. Bedford County Pennsylvania, 1"=100' Sept. 1927 E. Corrie Engr. Robertsdale Pa.