


Baldwin Estate Coal Co.
B & N
Winslow Twp.
Jefferson County
12-1956

HENRY NORRIS

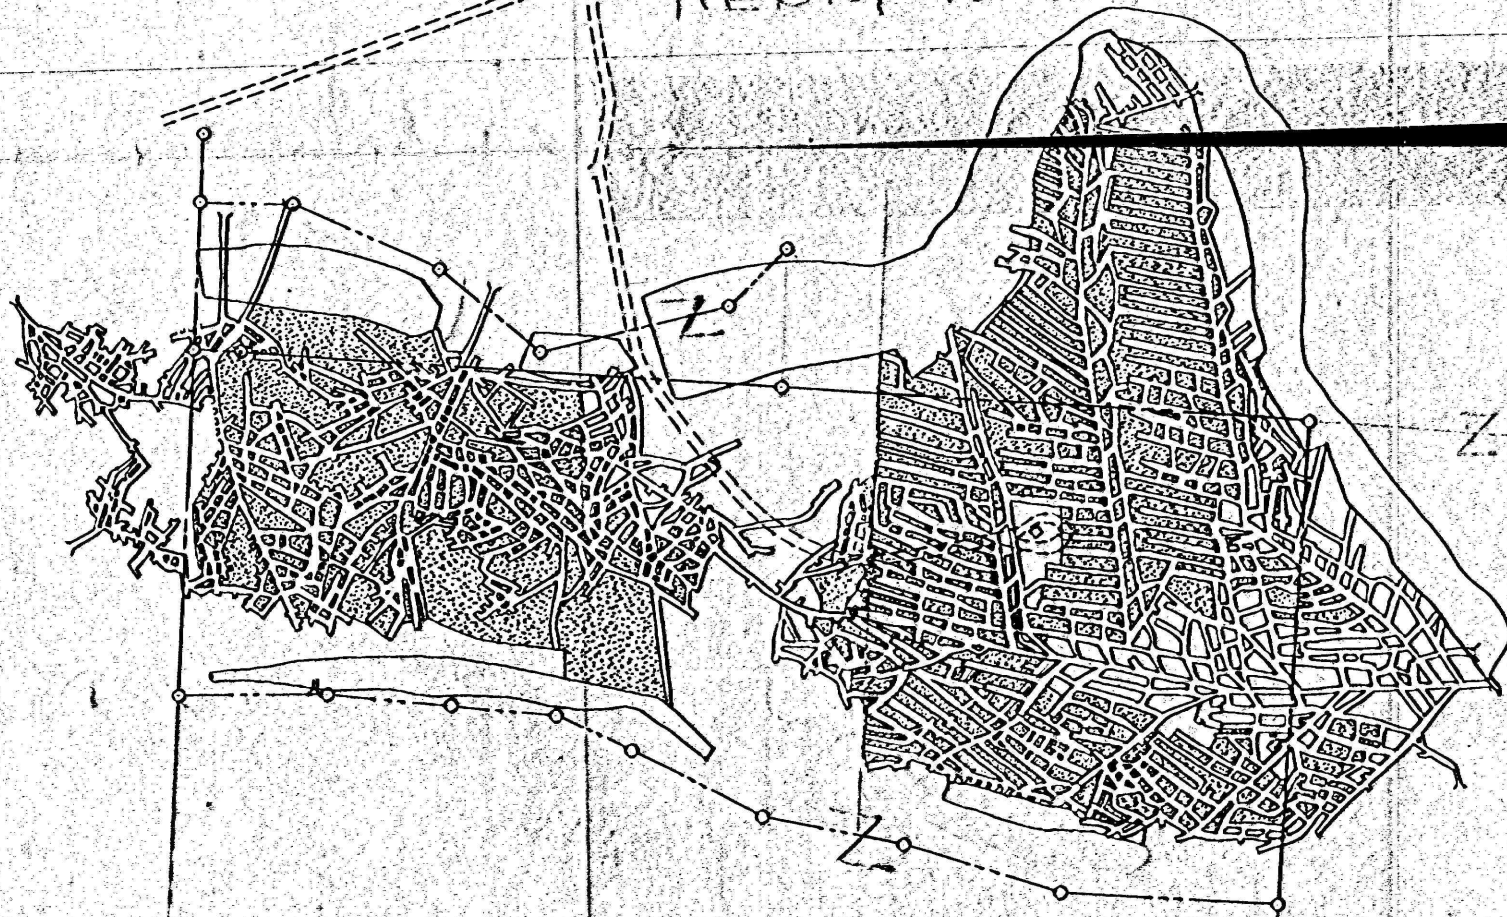

H. G. TENGARDEN & E. C. COCHRAN