


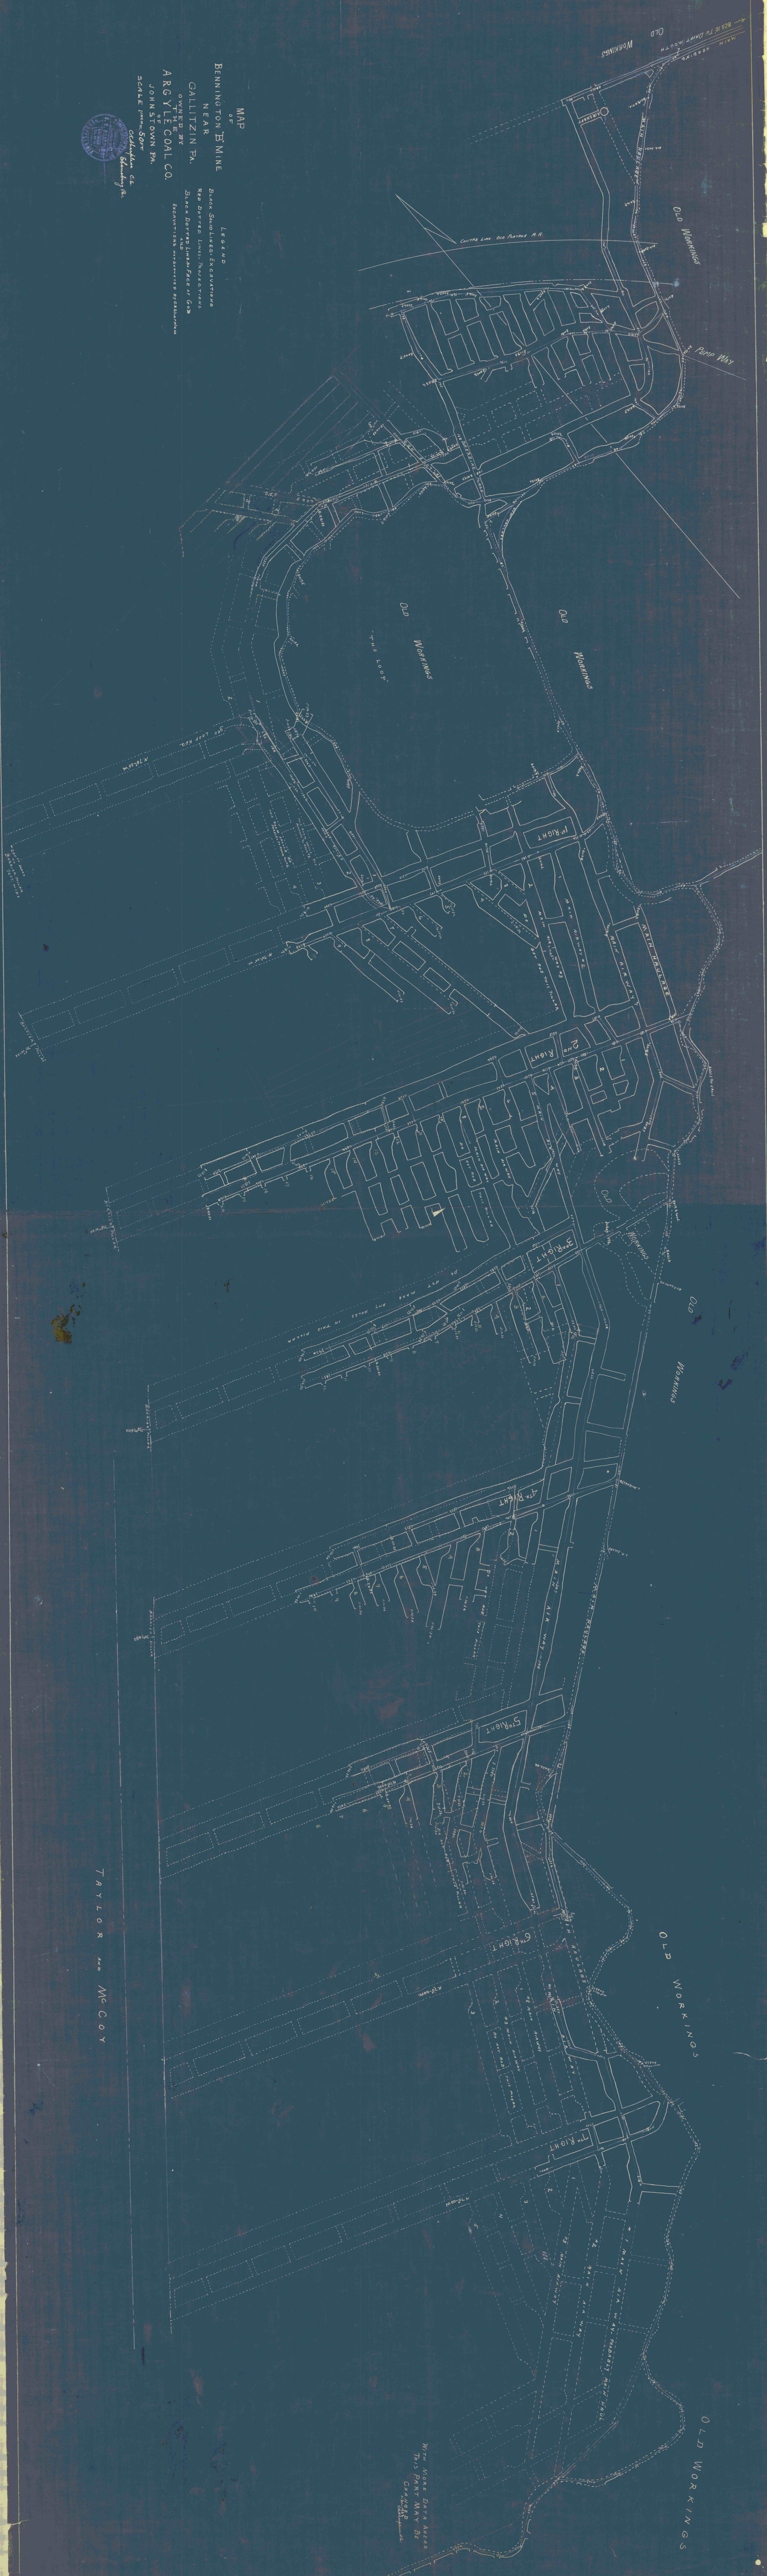

MAP
OF
BENNINGTON B.MINE
NEAR
GALLITZIN PA.
OWNED BY
THE
ARGYLE COAL CO.
JOHNSTOWN PA.
SCALE 1 inch = 500 feet

LEGEND
Black Solid Lines - EXCAVATIONS



TAYLOR AND McCOY

With more data added
this part may be
changed.