


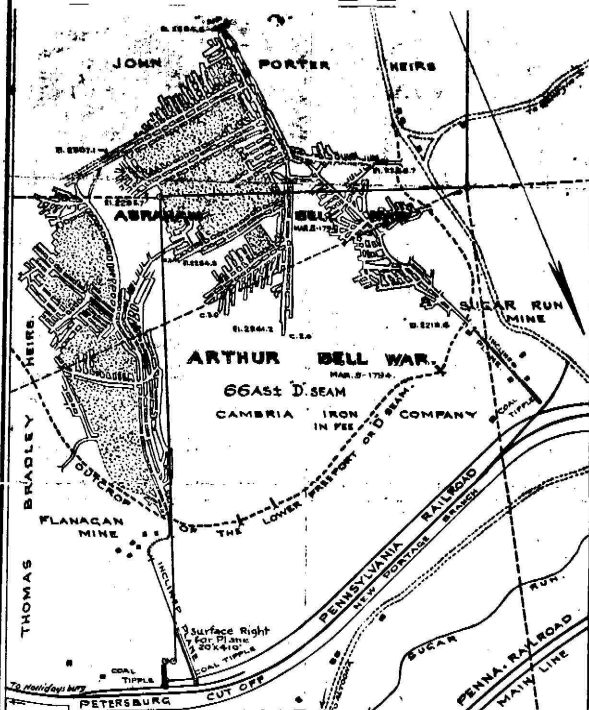

## MAP

LOWER FREEPORT OR BED 'D' SEAM OF COAL  
situate in

ALLEGHENY TOWNSHIP, BLAIR COUNTY, PA.

—LEASED TO—  
WILLIAM BURKE

bL

**BETHLEHEM STEEL PRODUCTS CO.**

AGREEMENT DATED: APRIL 15, 1968

1932

SCALE 1" = 500

**J-20-1926**