


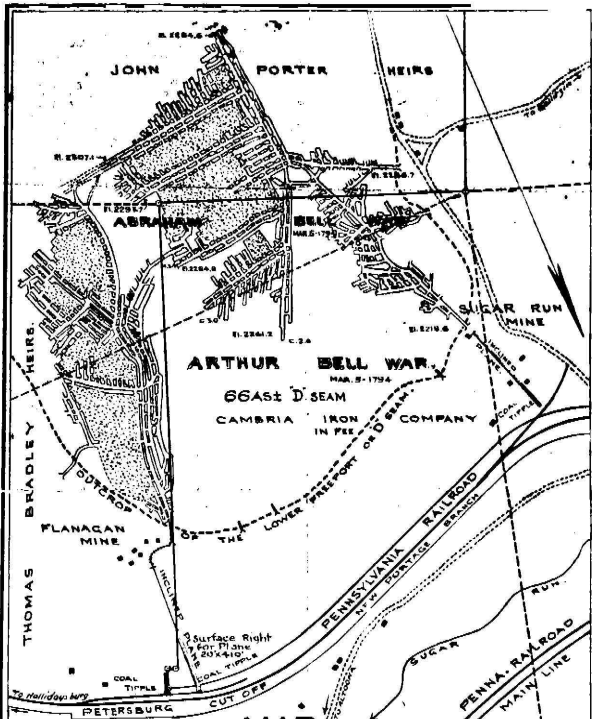

OF —
 LOWER FREEPORT OR BED D SEAM OF COAL
 Situate in
 ALLEGHENY TOWNSHIP, BLAIR COUNTY, PA.
 — LEASED TO —
WILLIAM BURKE

by
BETHLEHEM STEEL PRODUCTS CO.
 AGREEMENT DATED April 10, 1932
 1932

SCALE - 1" = 500'

8-28-1916