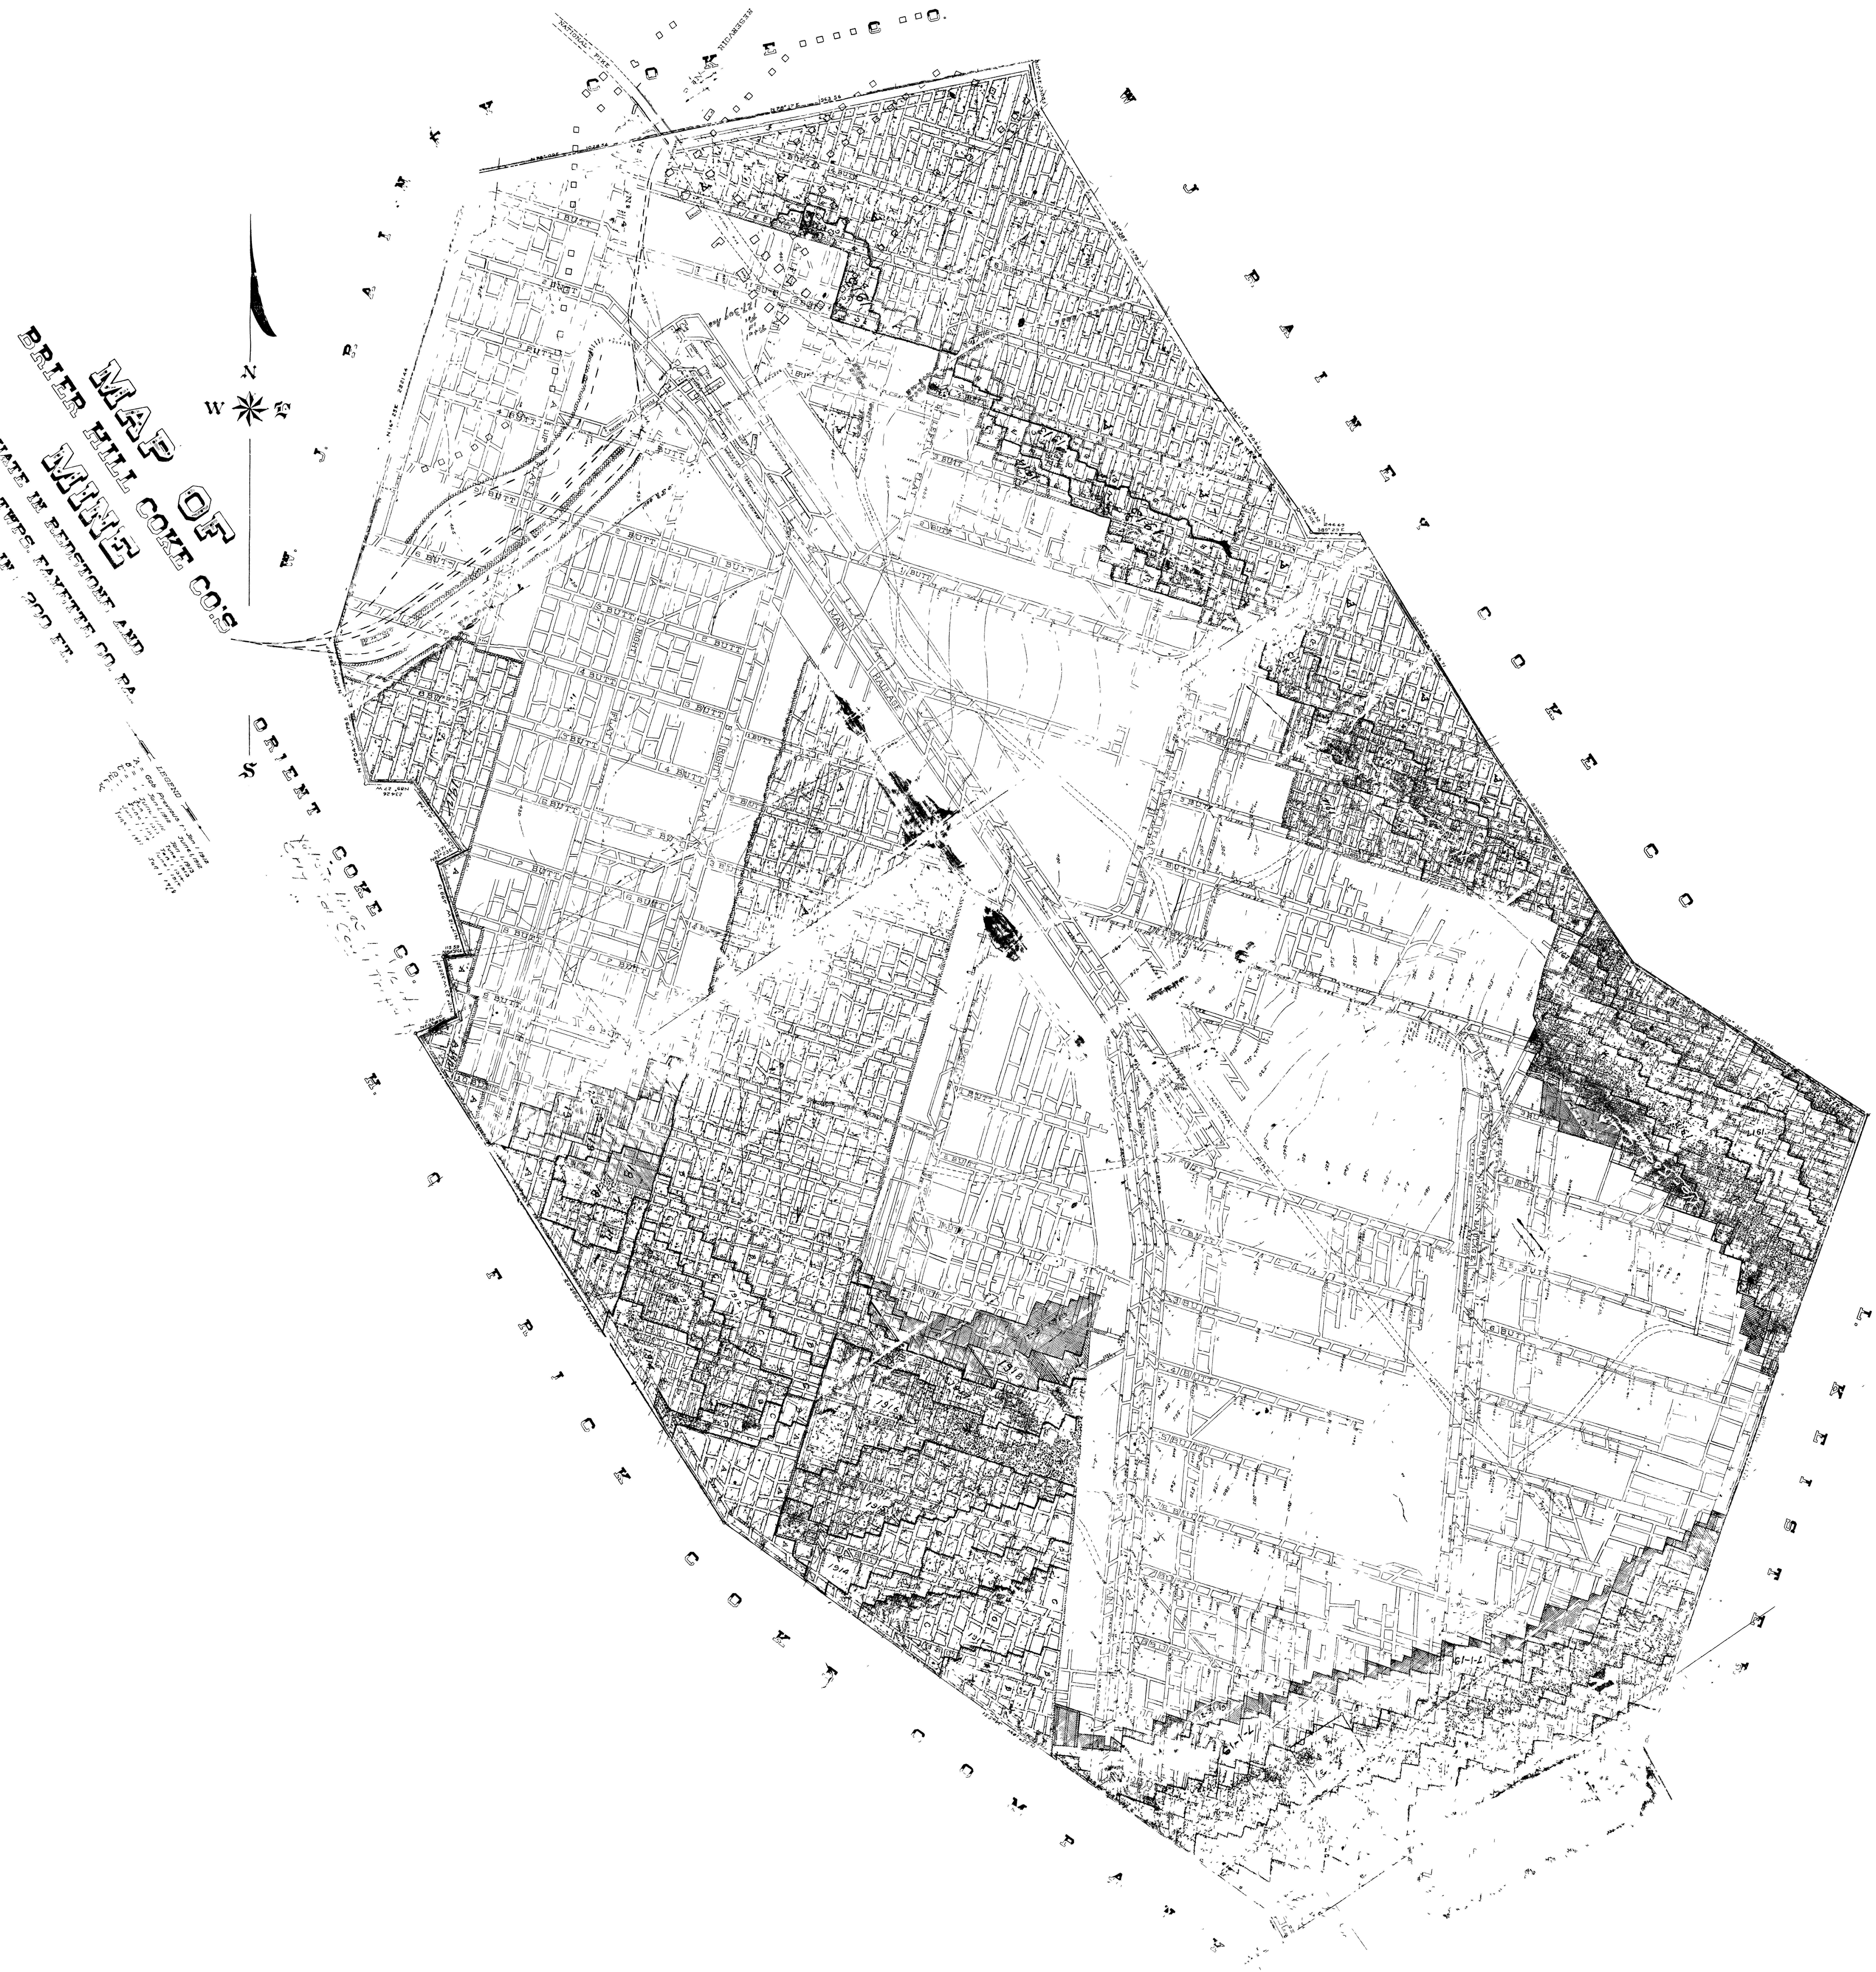
MAP OF
BRIER HILL COKE CO'S
MINE
SITUATE IN REDSTONE AND
MENALLEN TWPS. FAYETTE CO. PA.
SCALE 1 IN. = 200 FT.
N
W
E
S
LEGEND
ORIENT COKE CO.
H. C. FRICK COKE COMPANY
W. J. RAINEY COKE CO.
A. L. KEISTER
MAIN HAULAGE
UPPER MAIN HAULAGE
NATIONAL PIKE
RESERVOIR
1 BUTT
2 BUTT
3 BUTT
4 BUTT
5 BUTT
6 BUTT
7 BUTT
8 BUTT
9 BUTT
10 BUTT
LEFT FLAT
RIGHT FLAT
1912
1913
1914
1915
1916
1917
1918