


Glenn Strouse

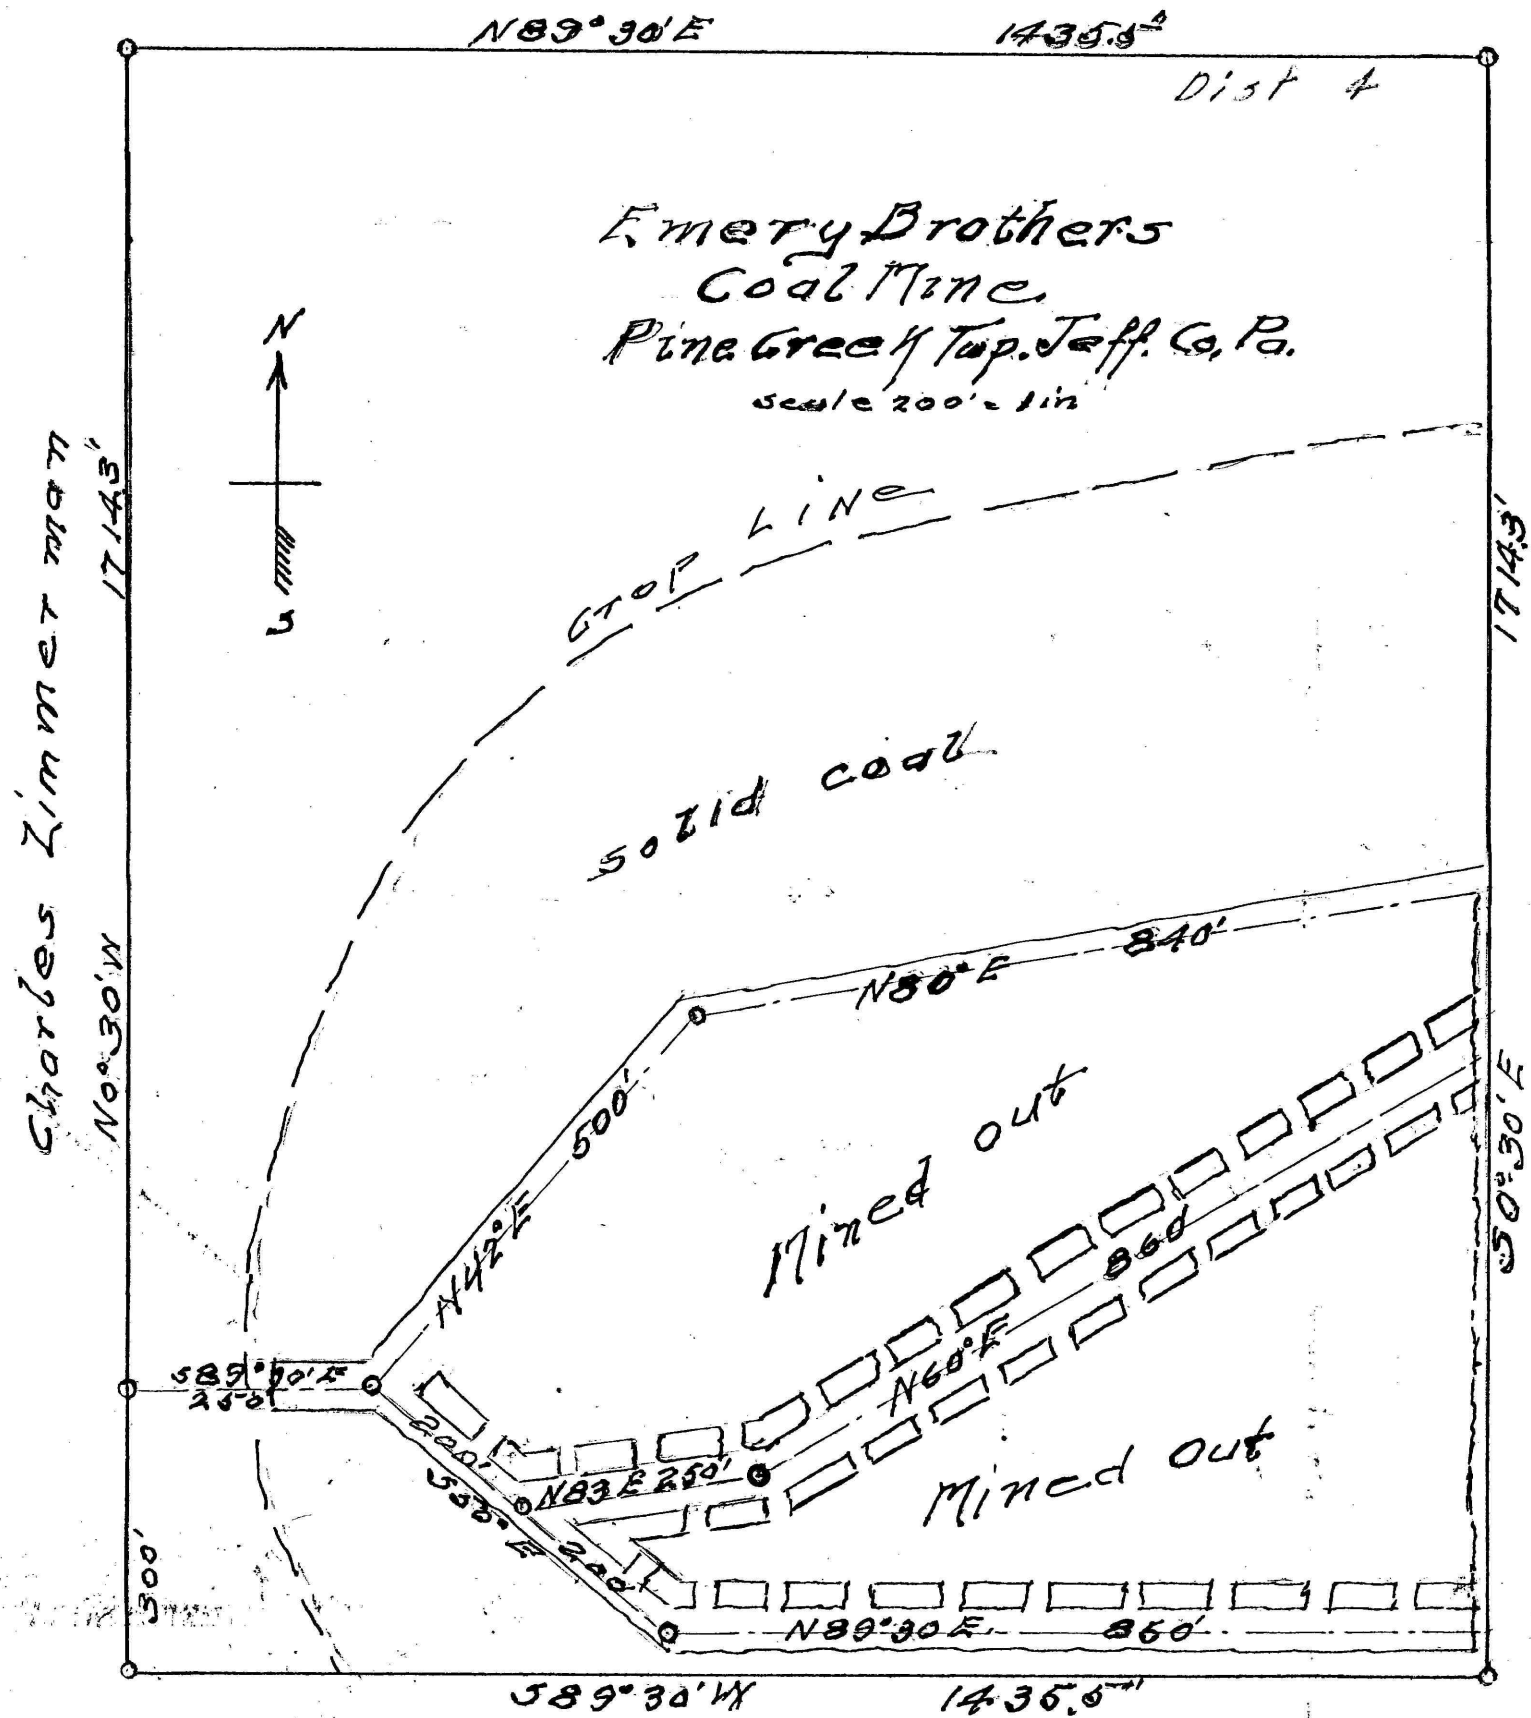

G.O. Schuchers