


COURTNEY COAL CO.

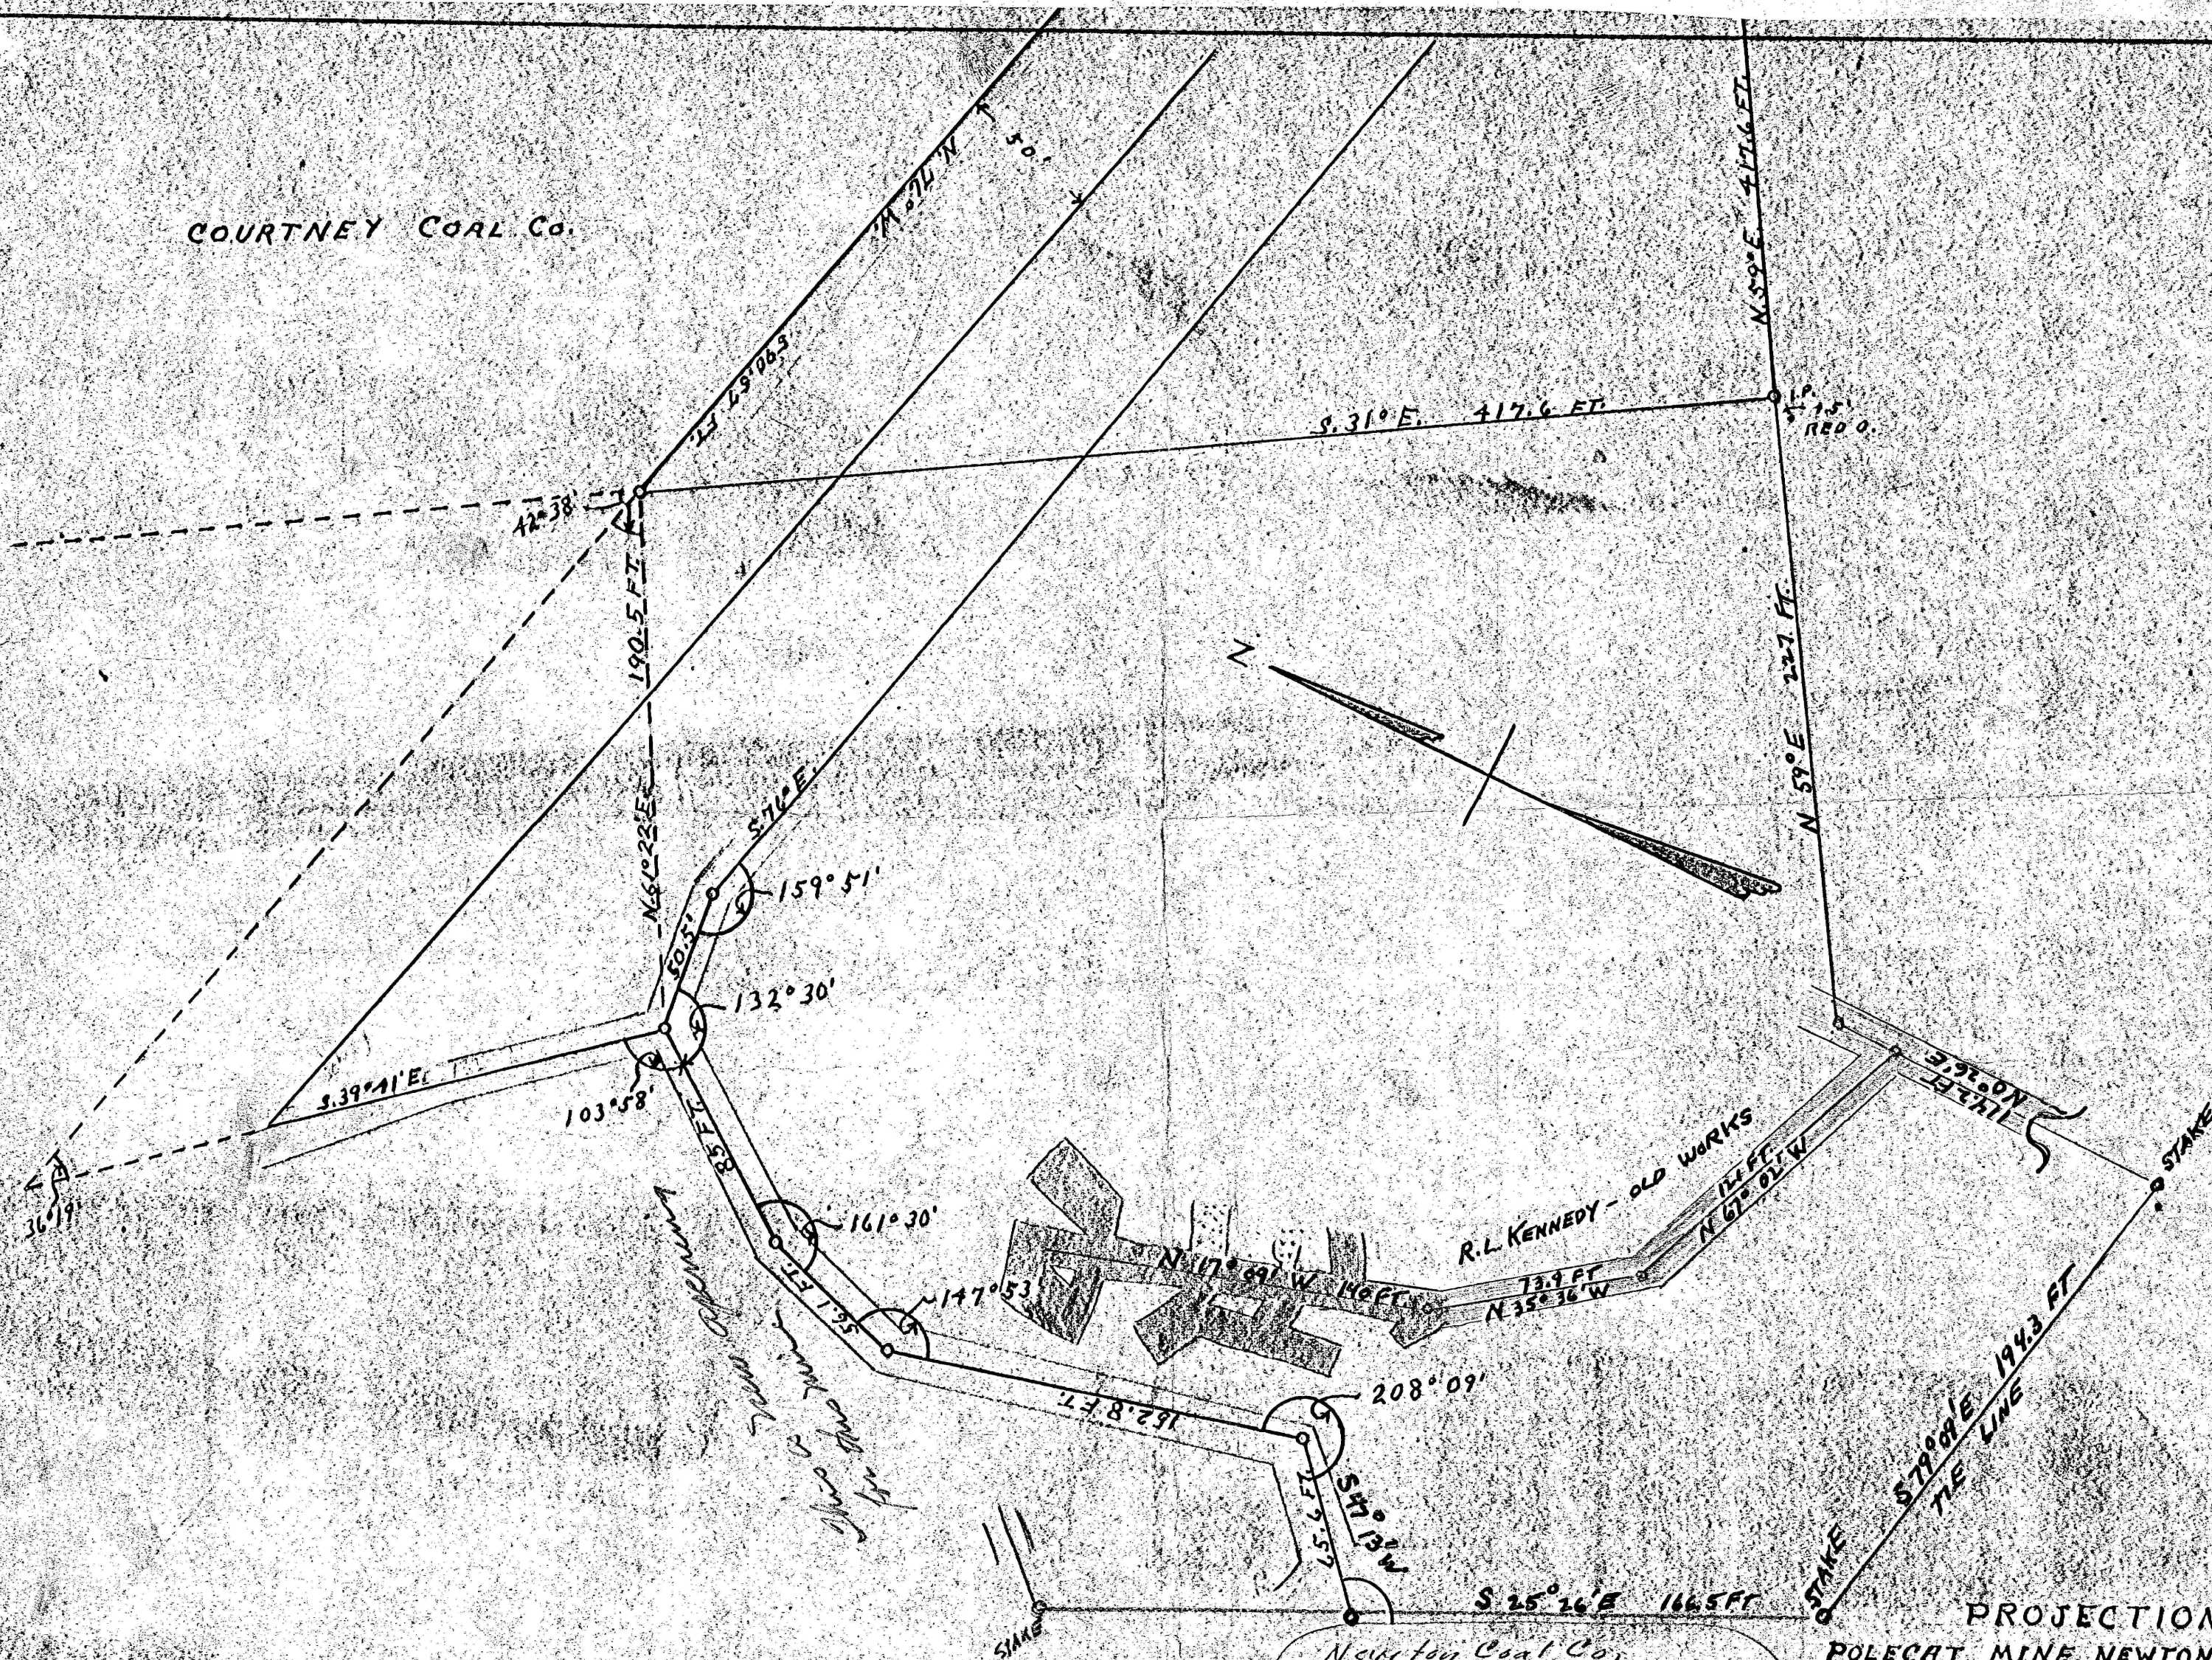

Newton Coal Co.
Kennedy
Beaver County District 17
1956 Annual

PROJECTION
POLECAT MINE, NEWTON COAL CO.
SITUATED IN
GREENE TWP., BEAVER CO., PA.
SCALE: 1 IN. = 50 FT. DEC. 17, 1953.
W. CAIN