


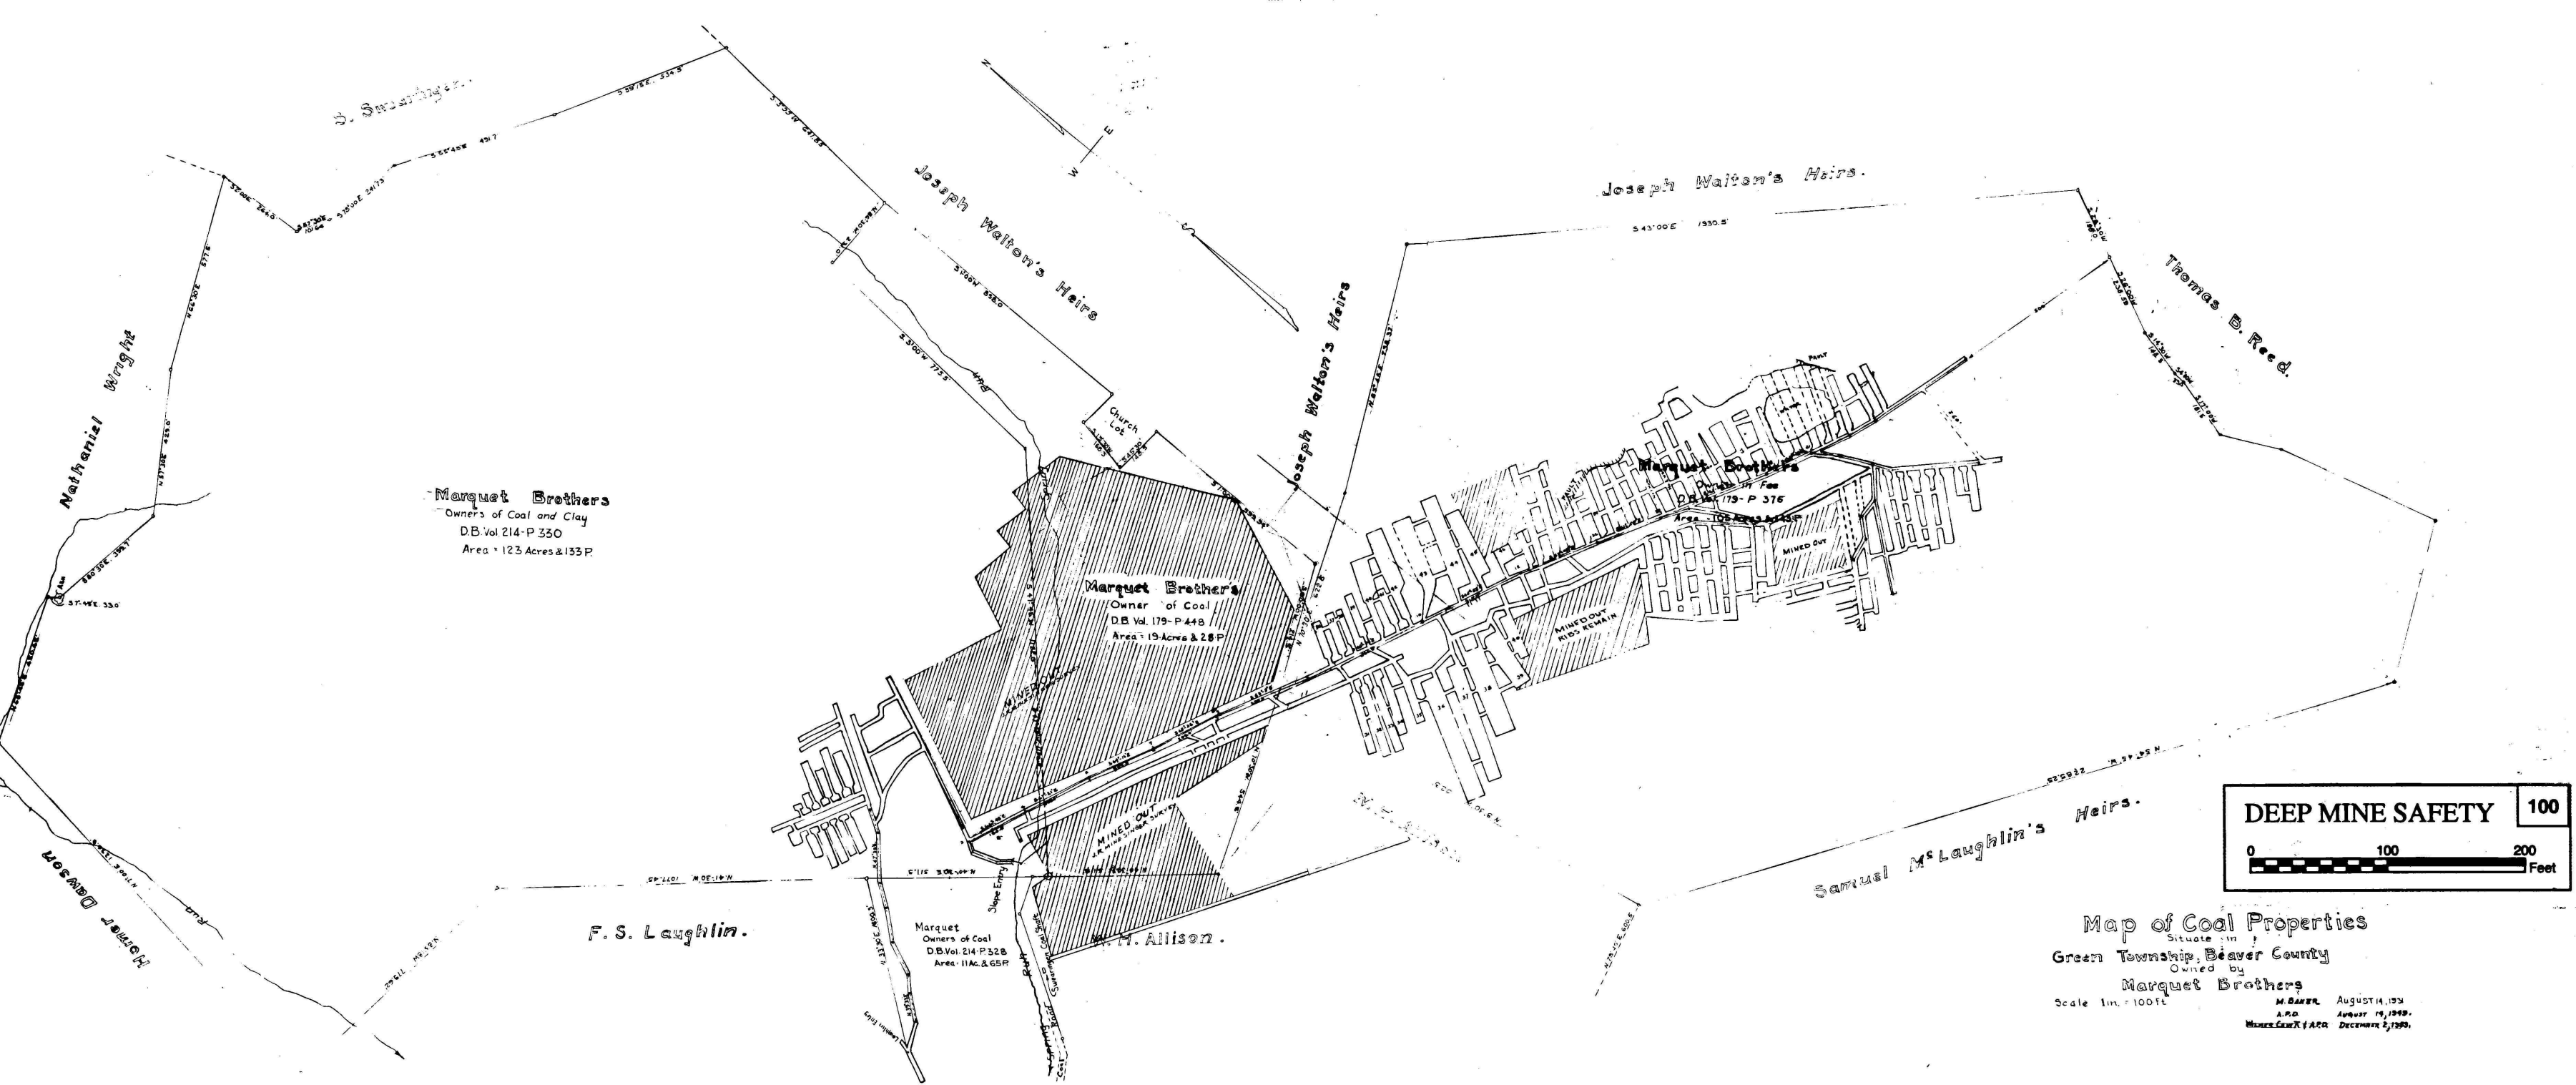

DOW-LIN COAL CO
HOOKSTOWN PA