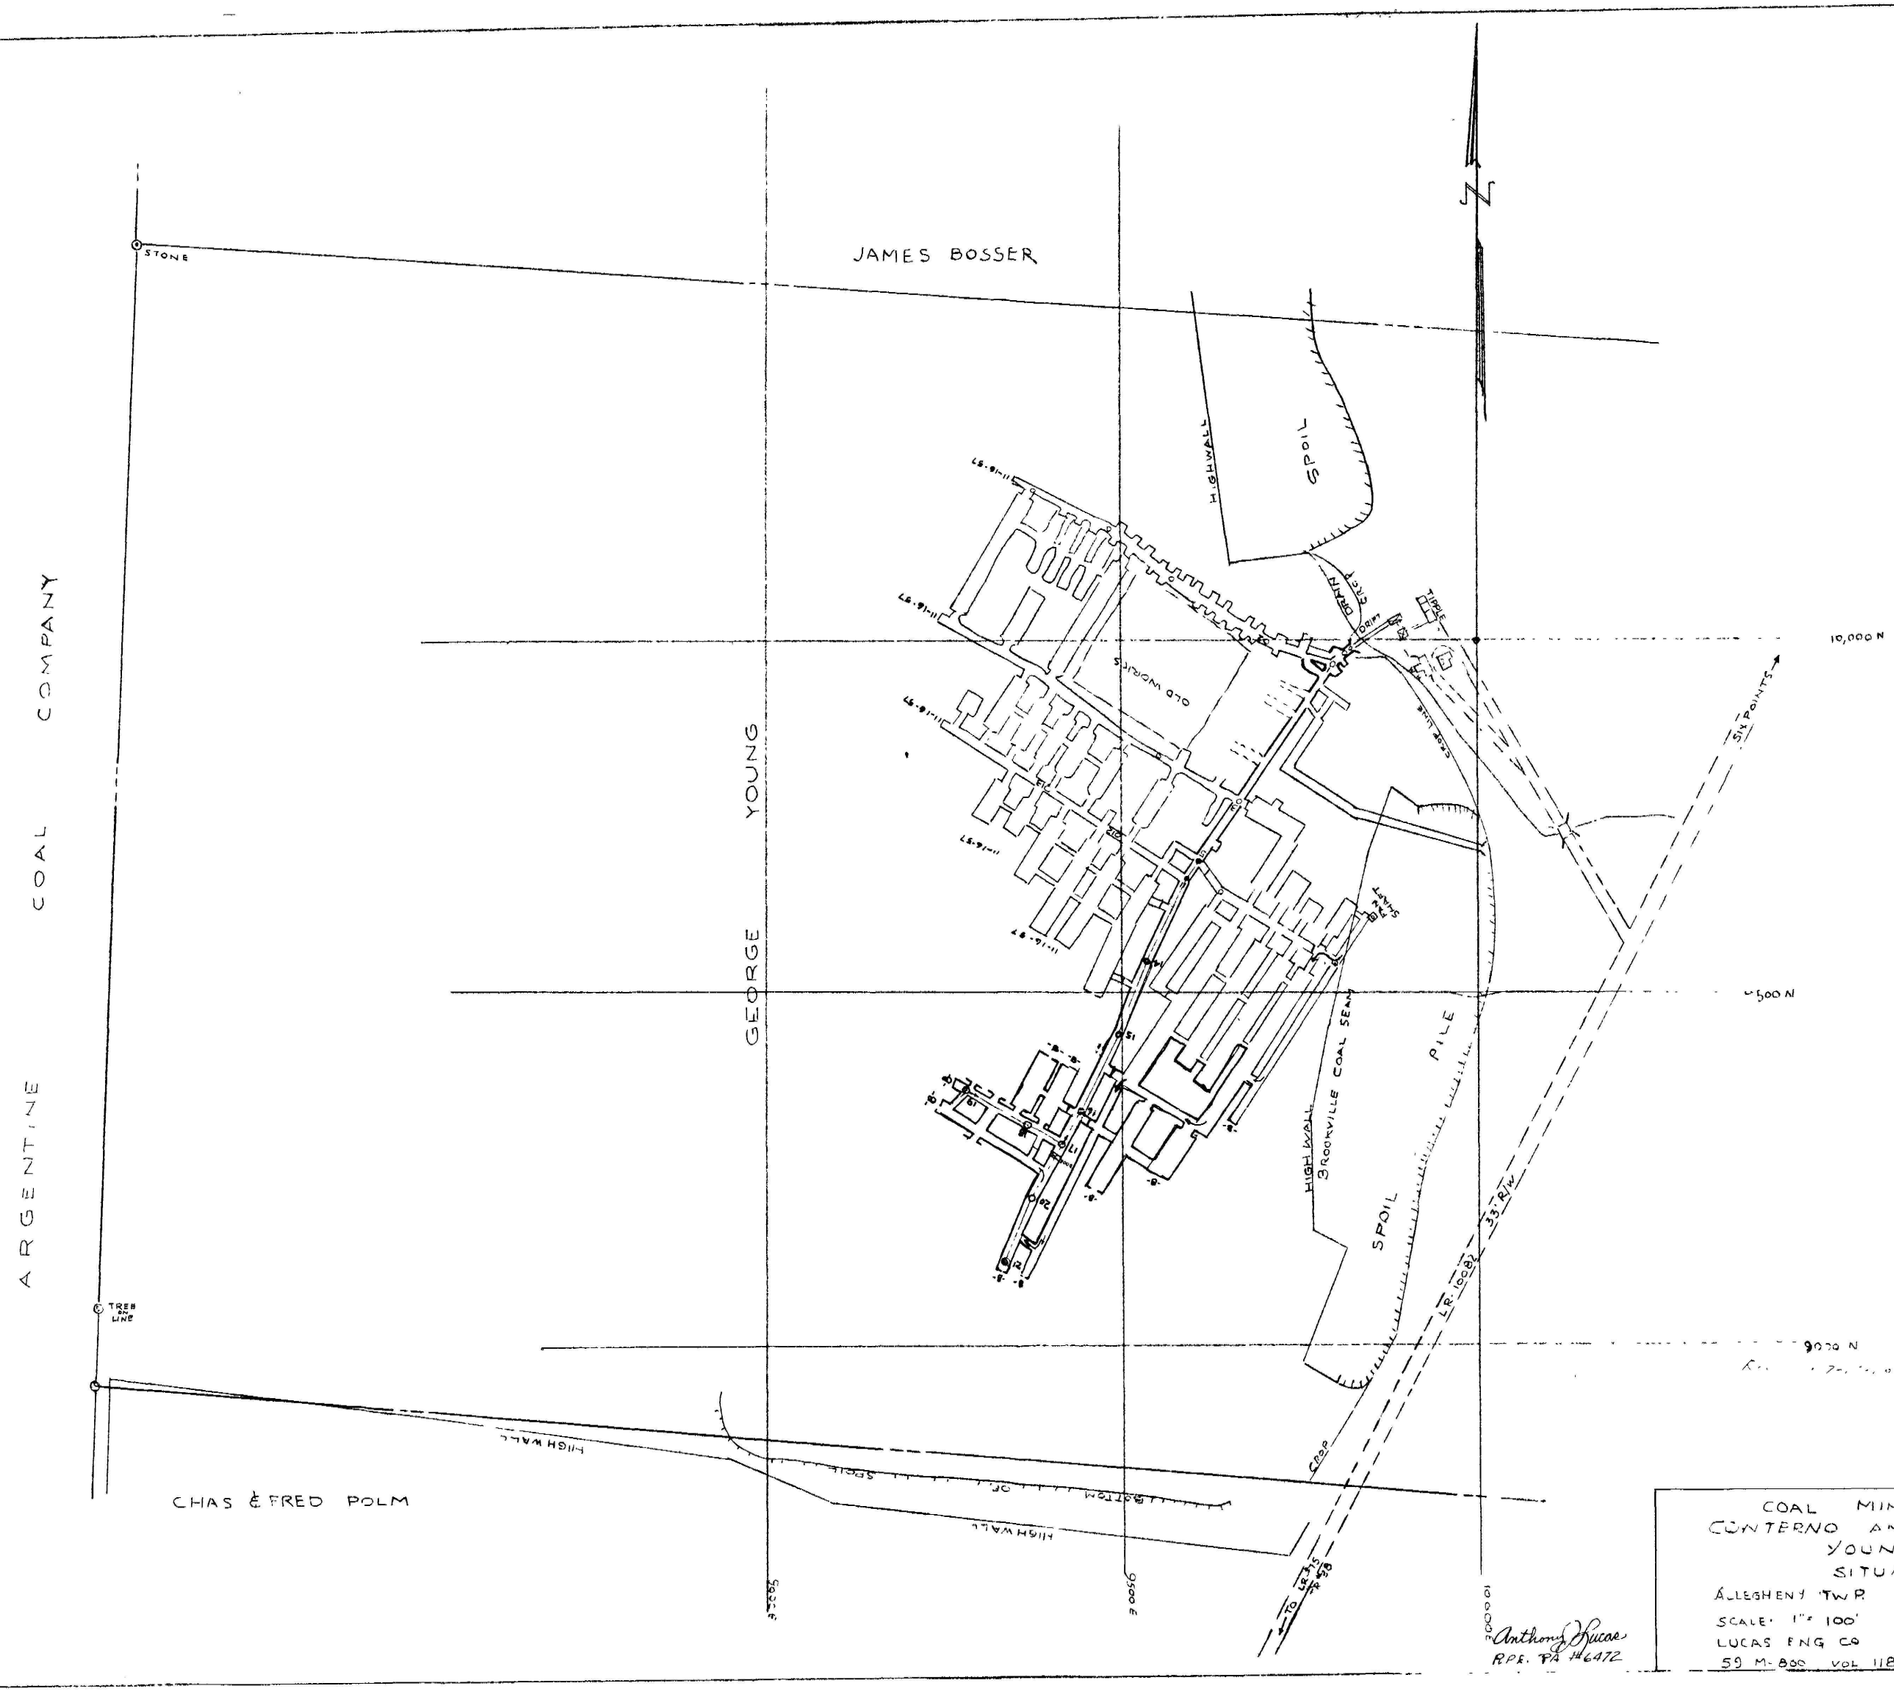

LEGEND		
SYMBOL	ENGINEER	DATE
-A-	E. J. Weibel	11-16-57
-B-	A J Lucas	5-10-59

COAL MINE SURVEY FOR
CONTERNO AND DEVEN COAL CO.
YOUNG MINE
SITUATE
ALLEGHENY TWP. BUTLER CO., PENNA.
SCALE: 1" = 100' MAY 10 1959
LUCAS ENG CO BUTLER, PA.
59 M-800 VOL 118 NOTE ORIGINAL SURVEY BY E J WEIBEL 11-16-57

Anthony Lucas
RPE. PA #6472