


J. Hockenberry

DILLIAM

586'-38' W. 1423.95'

Old


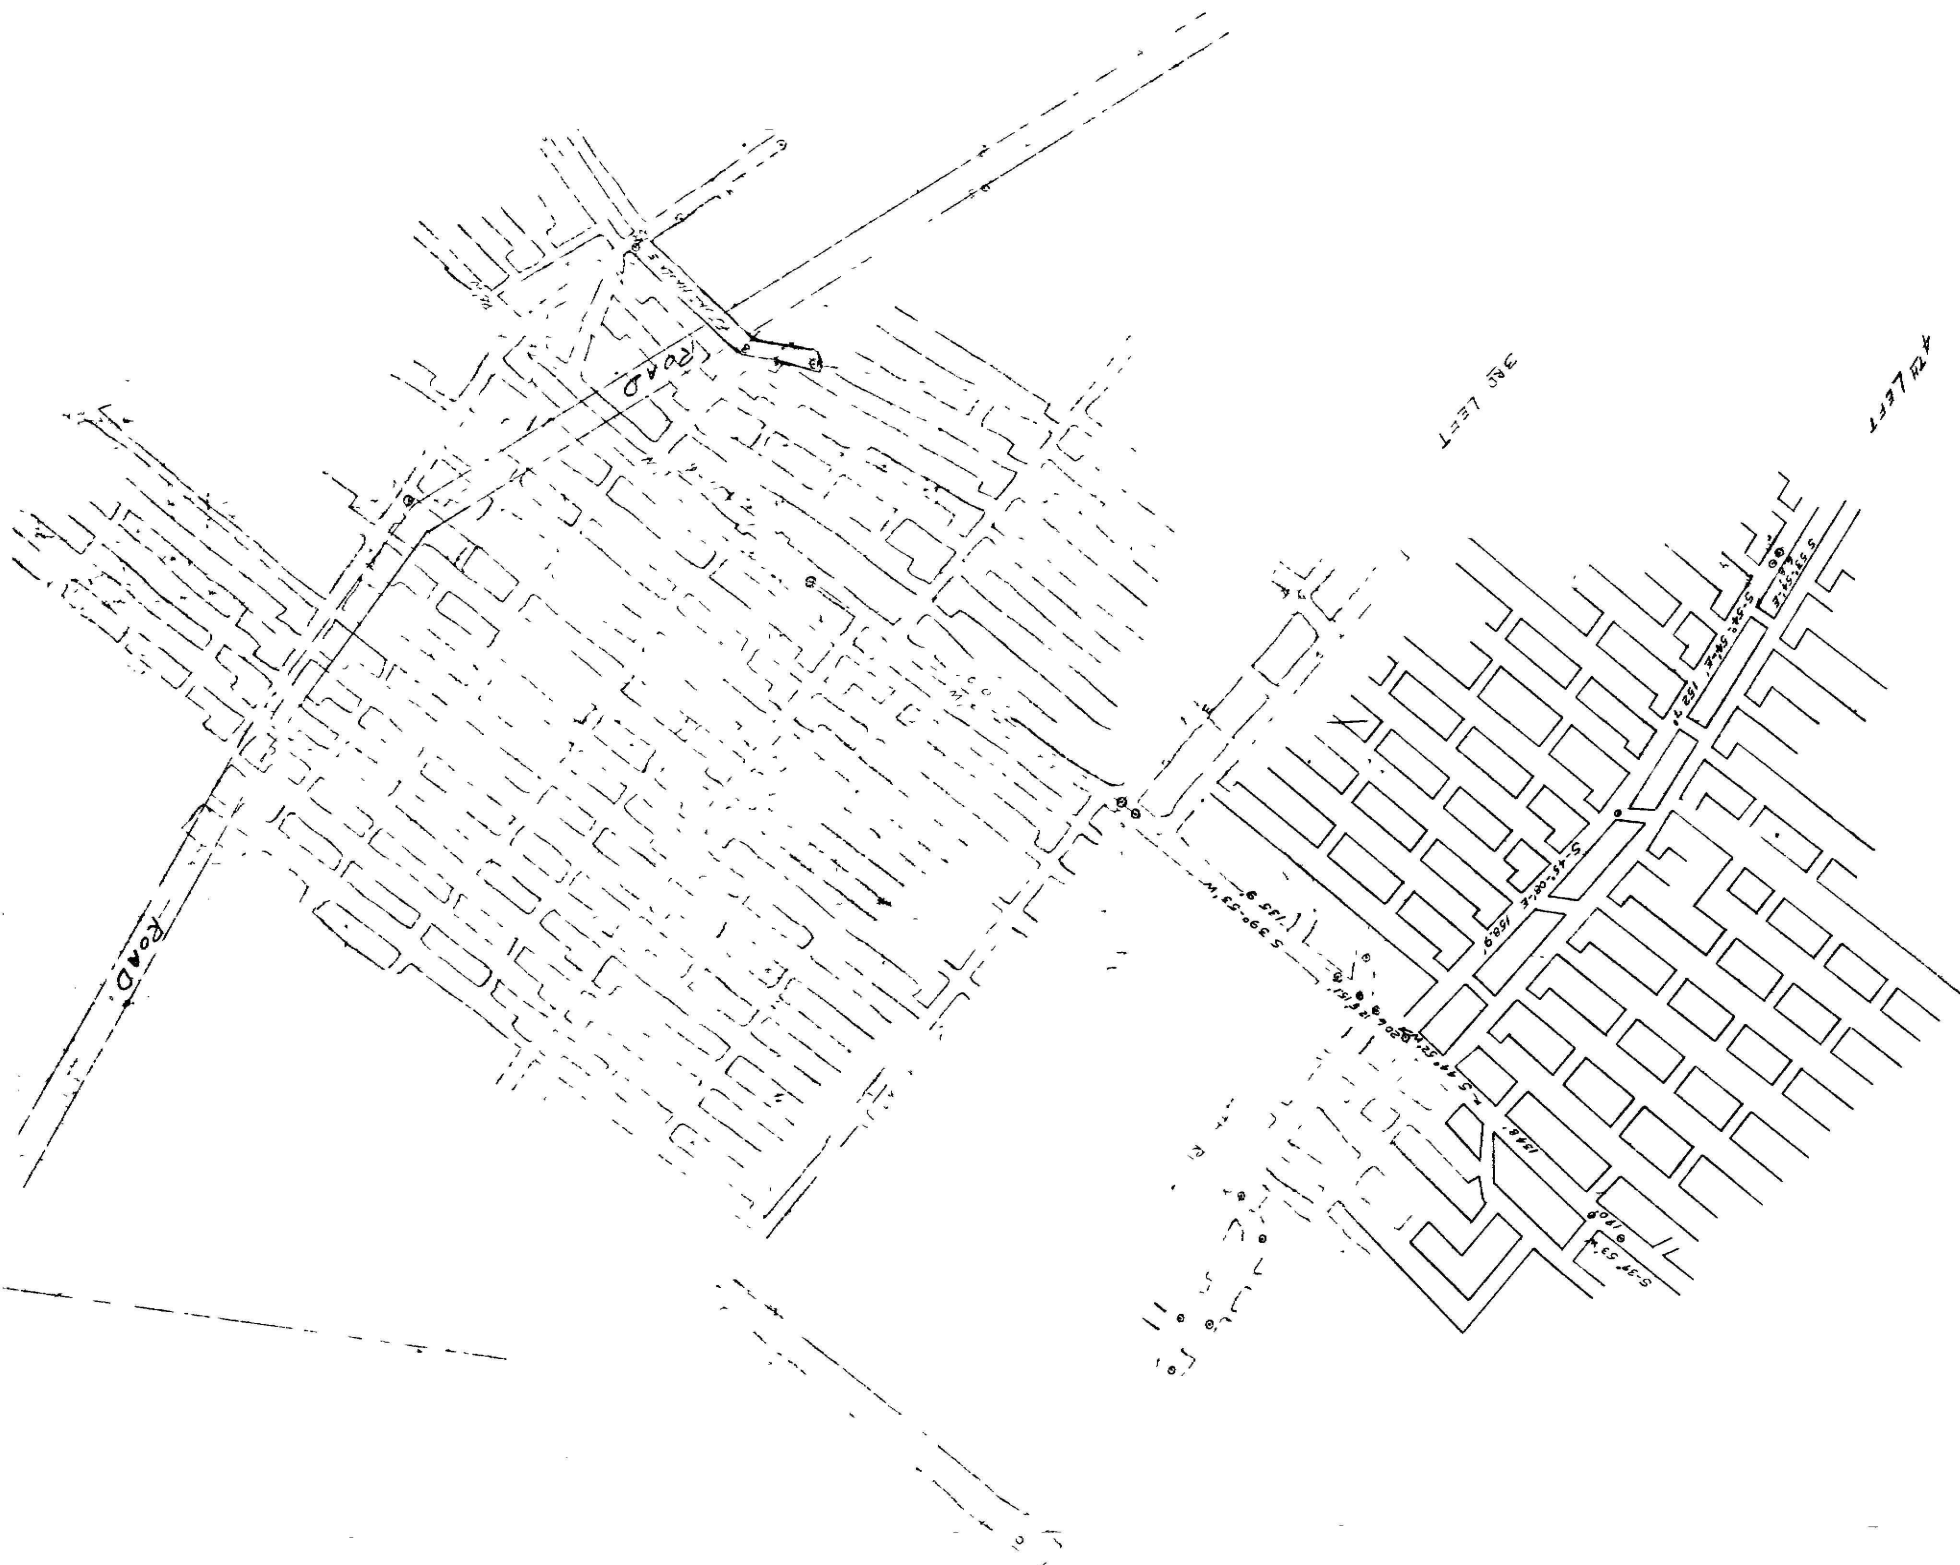

S 4°-46' W
Z TINKER

1786.01'

SISCO COAL CO.
FORMERLY
FARREN MINE
R.D. WEST SUNBURY BUTLER CO
RR 2055 12-1-1956
DIST 3
CLAY TWP

Scale 50 FT PER INCH

N 86°-55' E 12.1

DAVIS

1056.0'
N 80°-22' E
J. H. DAVENPORT