


W. LUNN TRACT
66.26 AC.

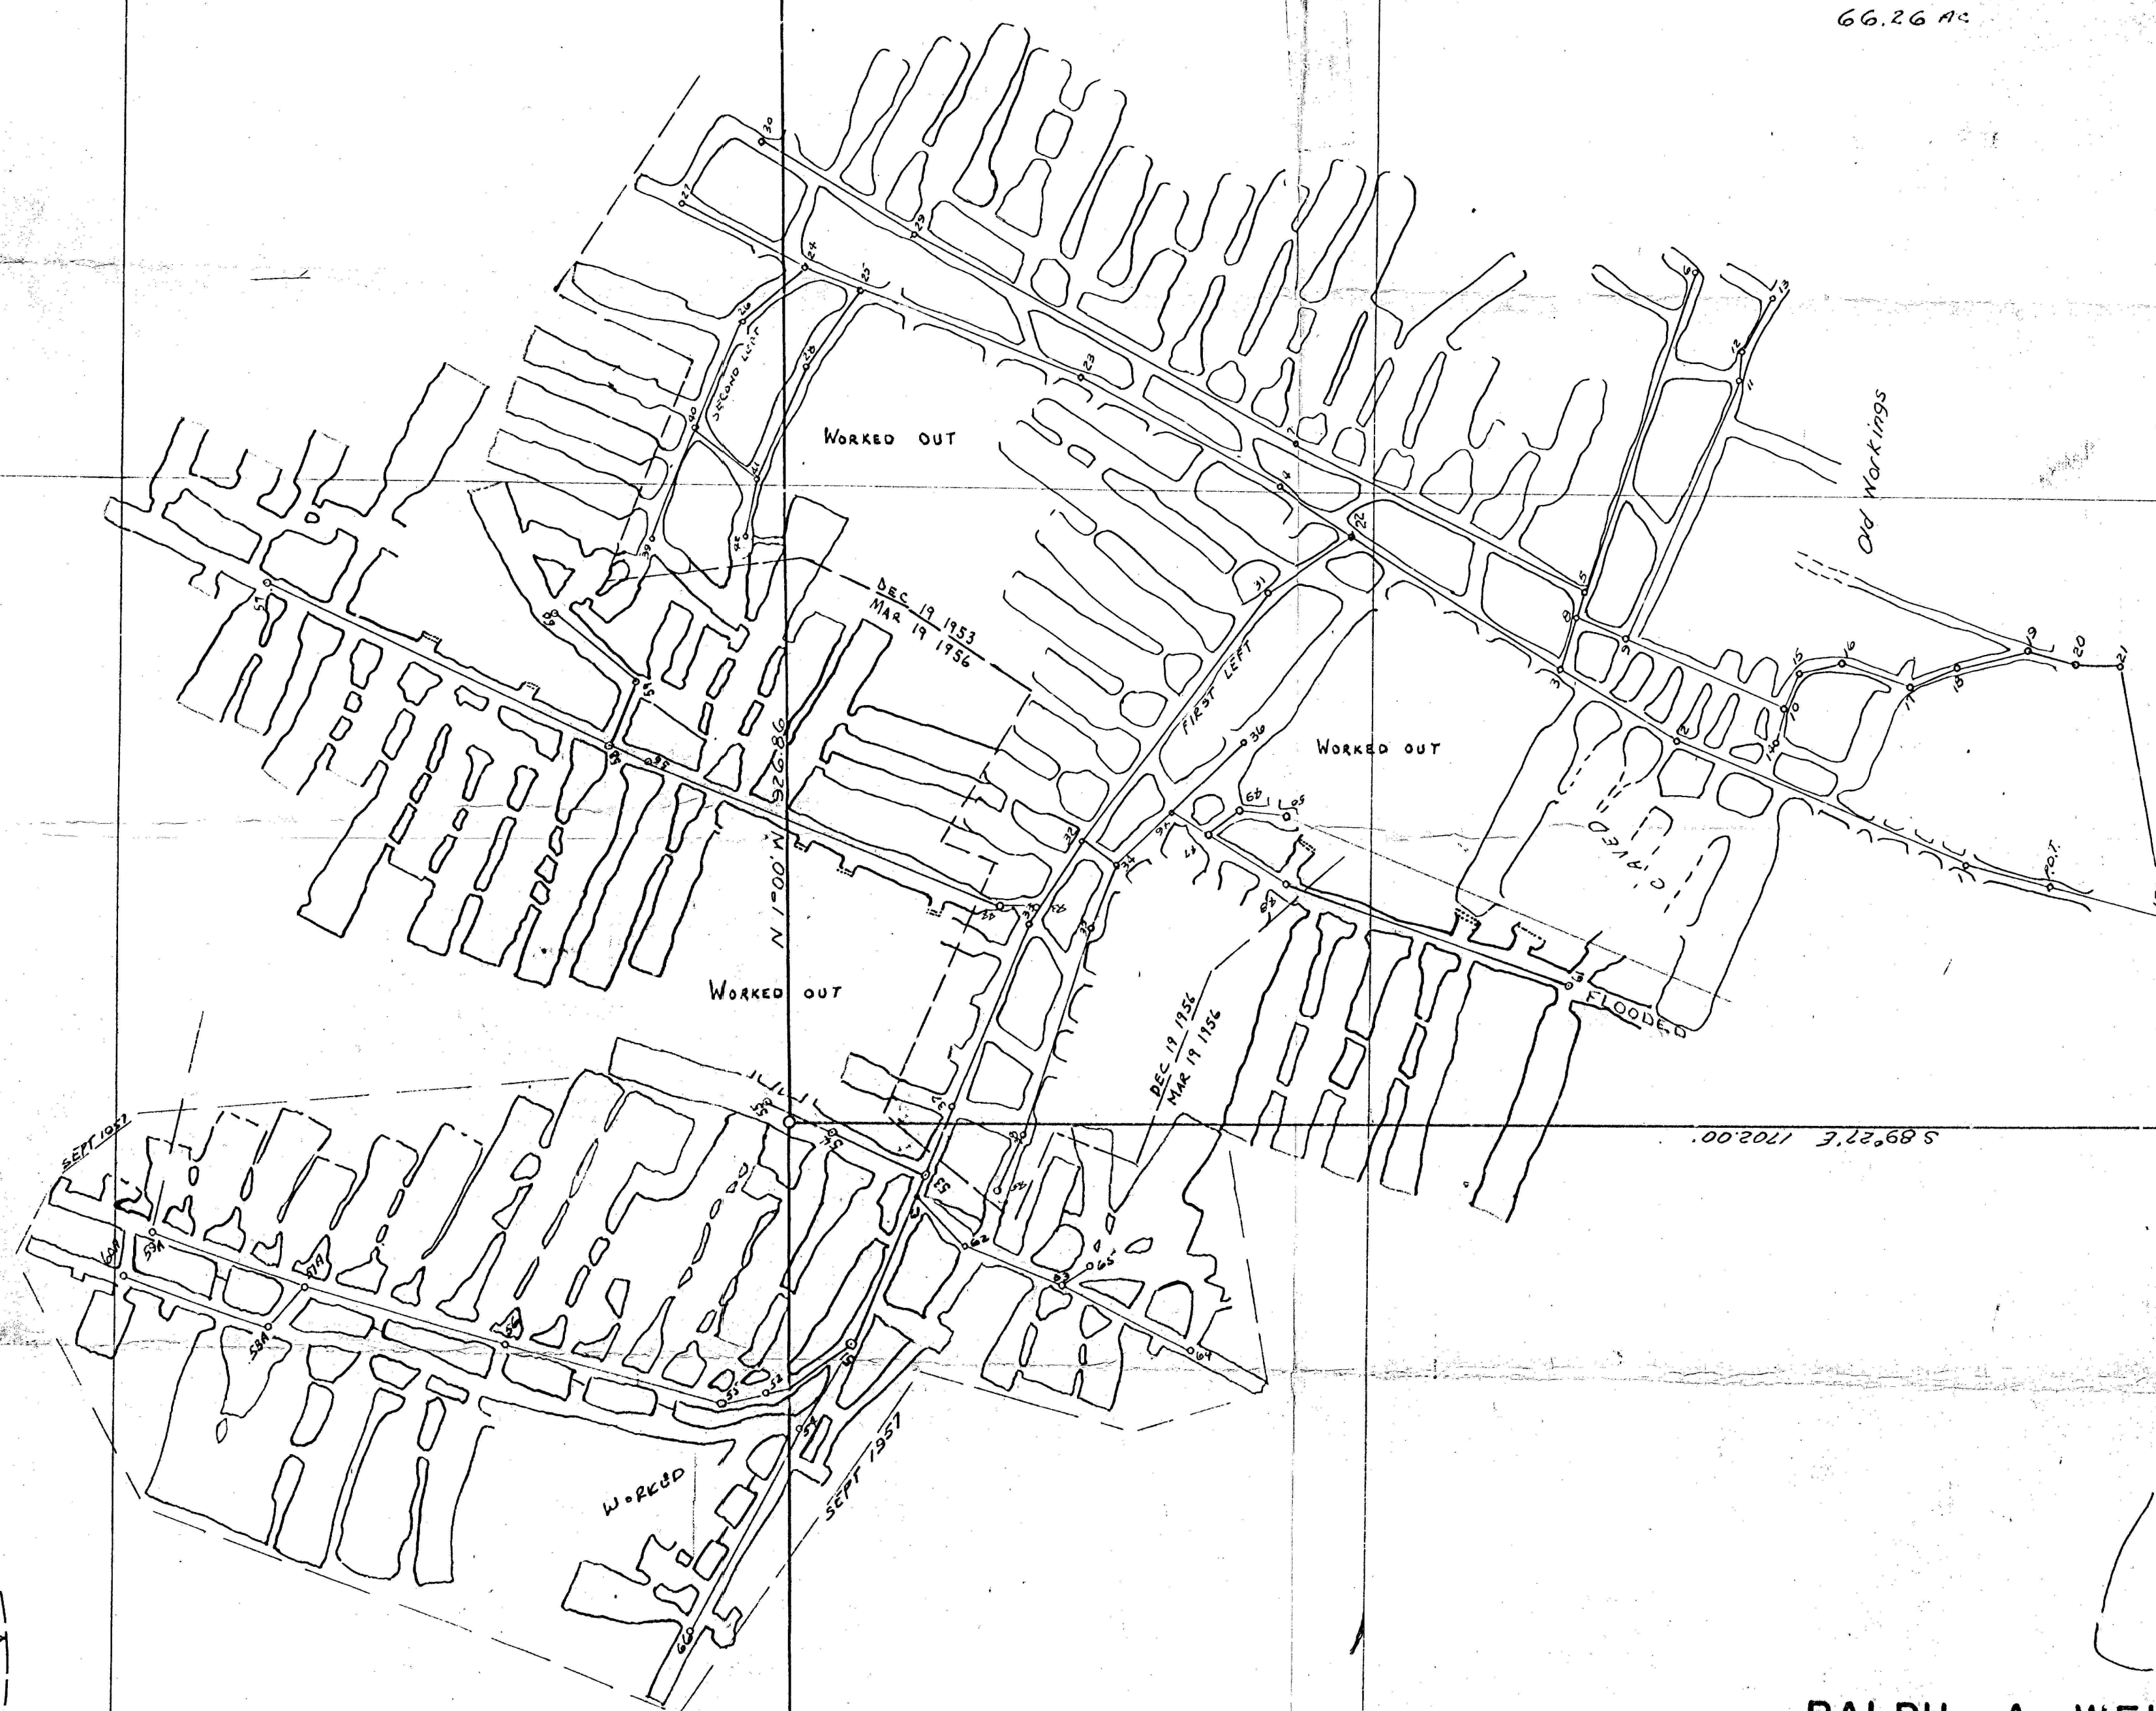

GEORGE WEIR
RESERVE

RALPH A. WEISS TRACT
54.32 AC.

STANFORD COAL CO.
MUDDY CREEK TOWNSHIP
BUTLER COUNTY, PA.
NOV. 1953 SCALE 1" = 100'
McMAHON ENGINEERING CO.
BUTLER, PENNA.

Thomas E. McMahon Co.

SIGHTS DEC 19 1953
REVISED MAR 19 1954
SEPT 1957

Stanford # 2

