


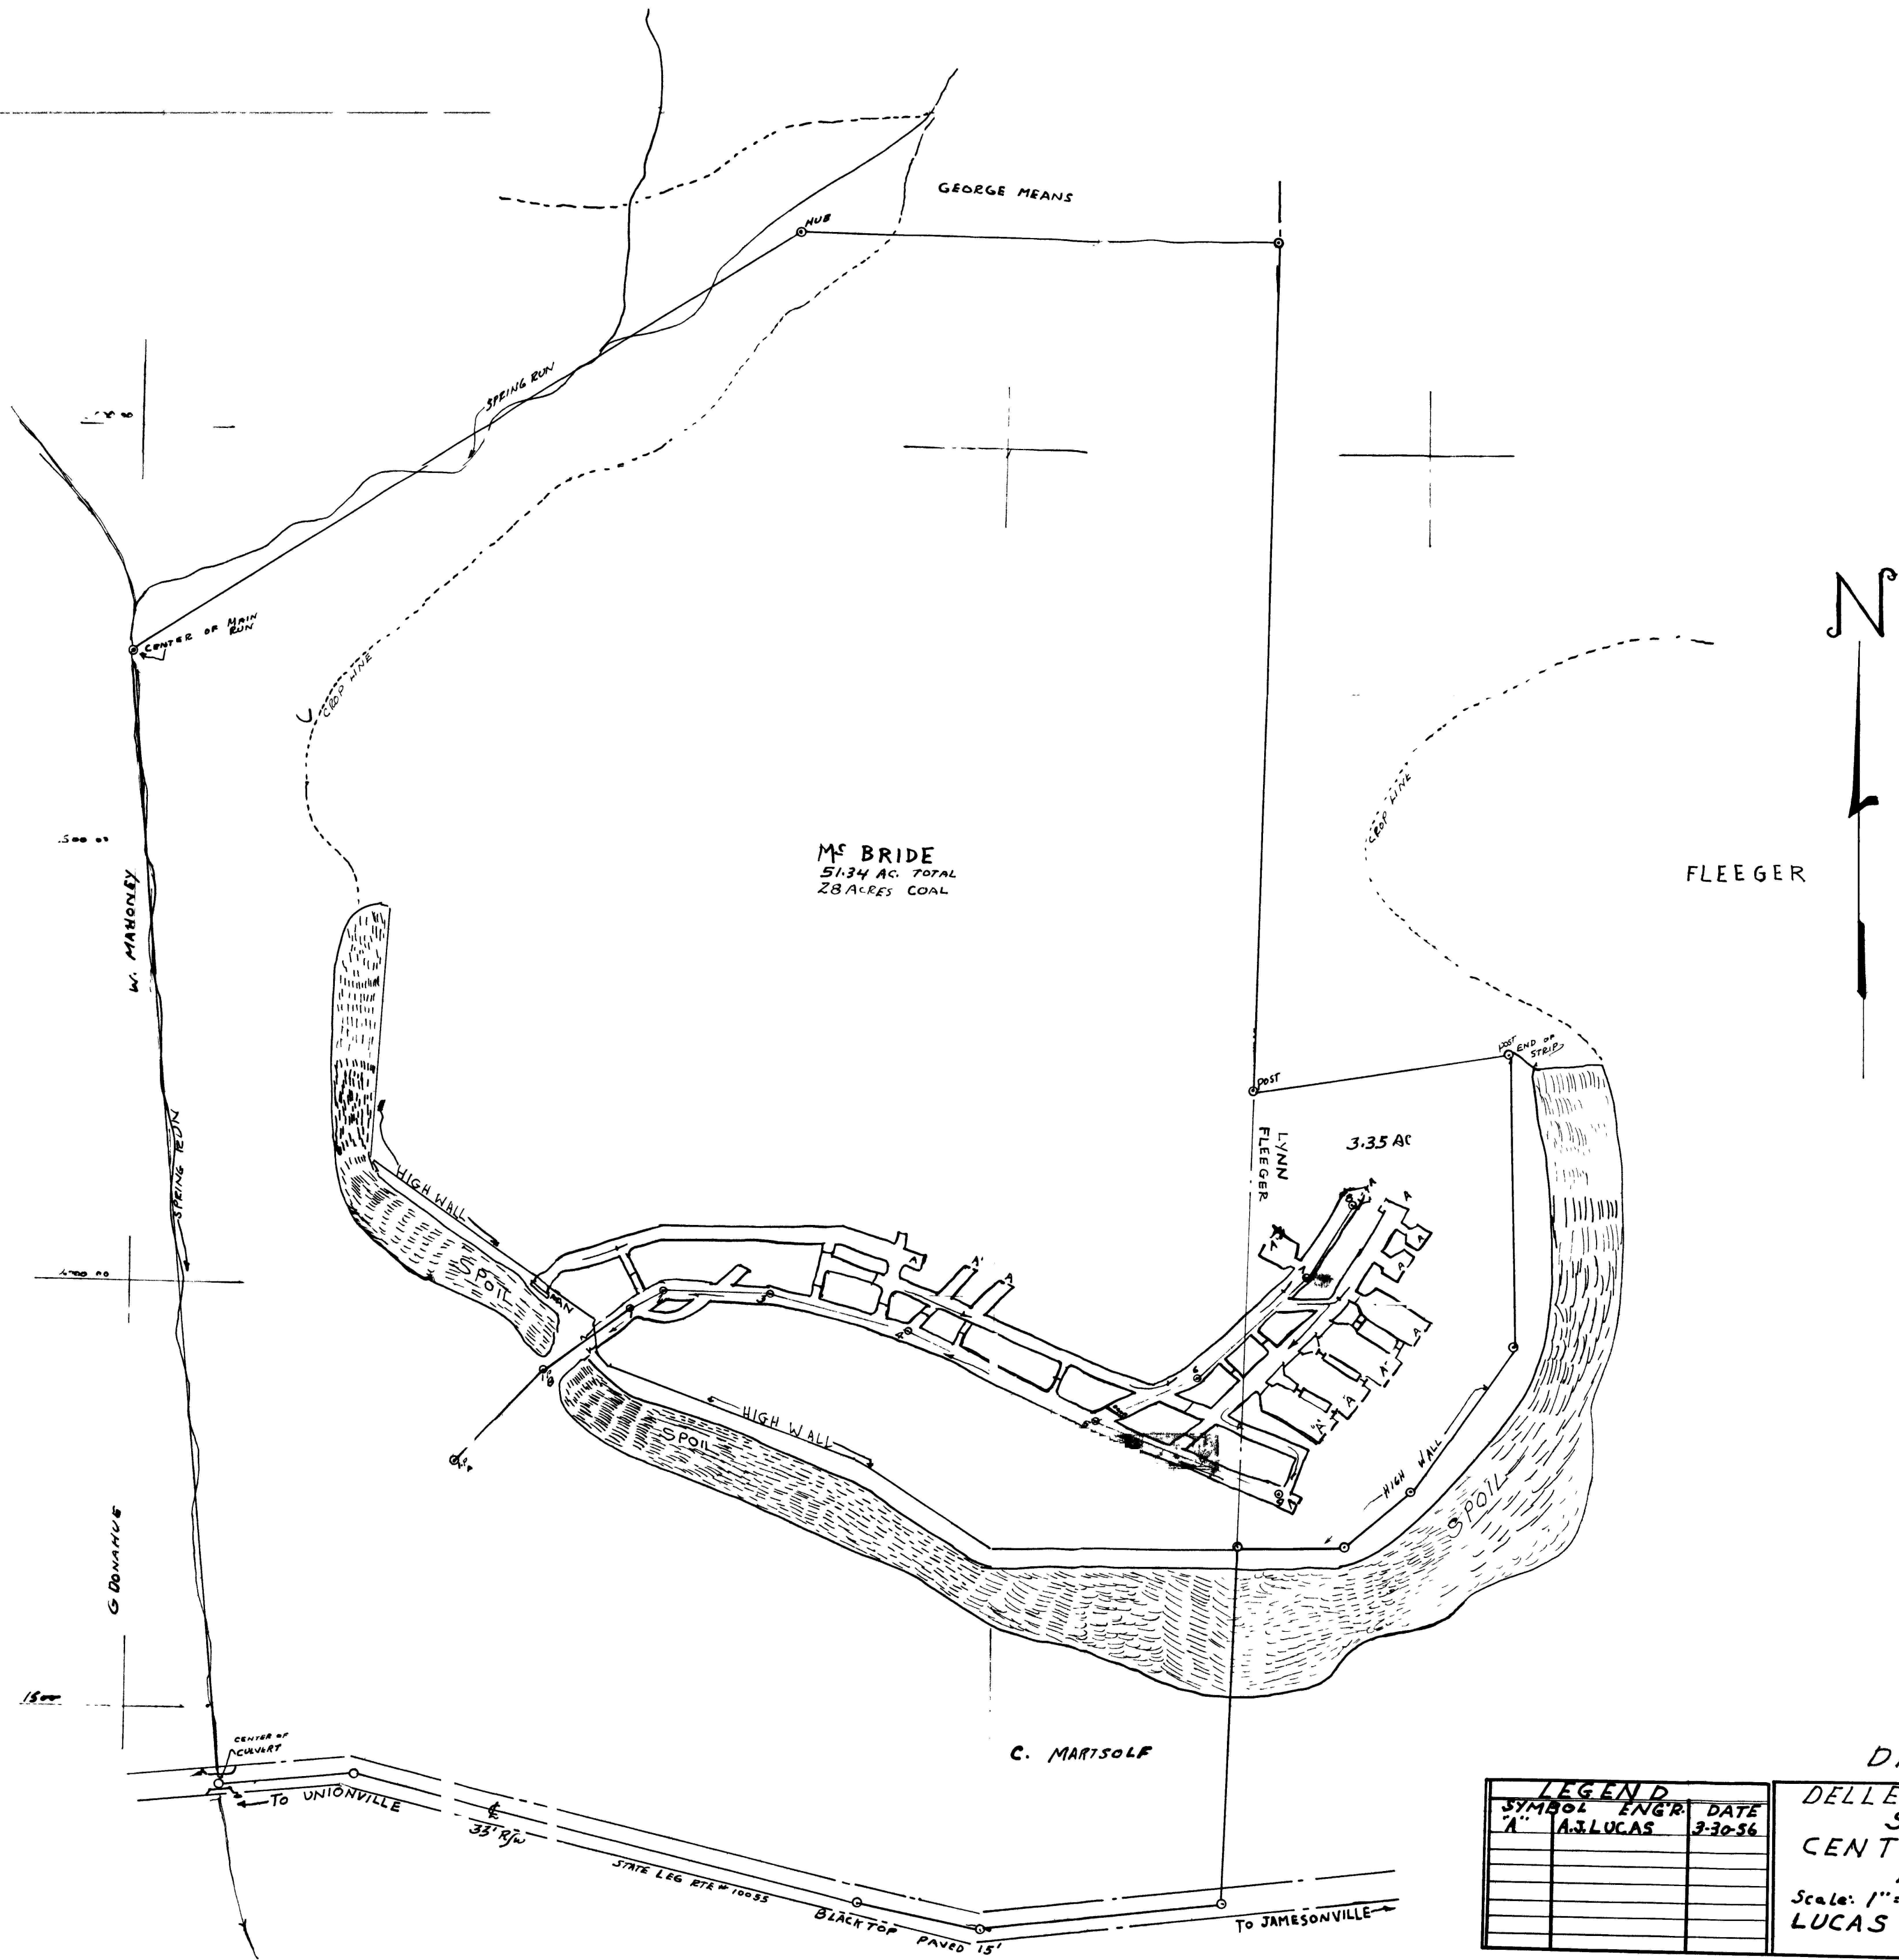

LEGEND		
SYMBOL	ENGR.	DATE
"A"	A.J. LUCAS	3-30-56

Dist 3
 DELLEN COAL CO. MINE
 SITUATED
 CENTER TWP. BUTLER CO.
 PENNA.
 Scale: 1"=100' MARCH 30, 1956
 LUCAS ENG. CO. BUTLER, PA.