


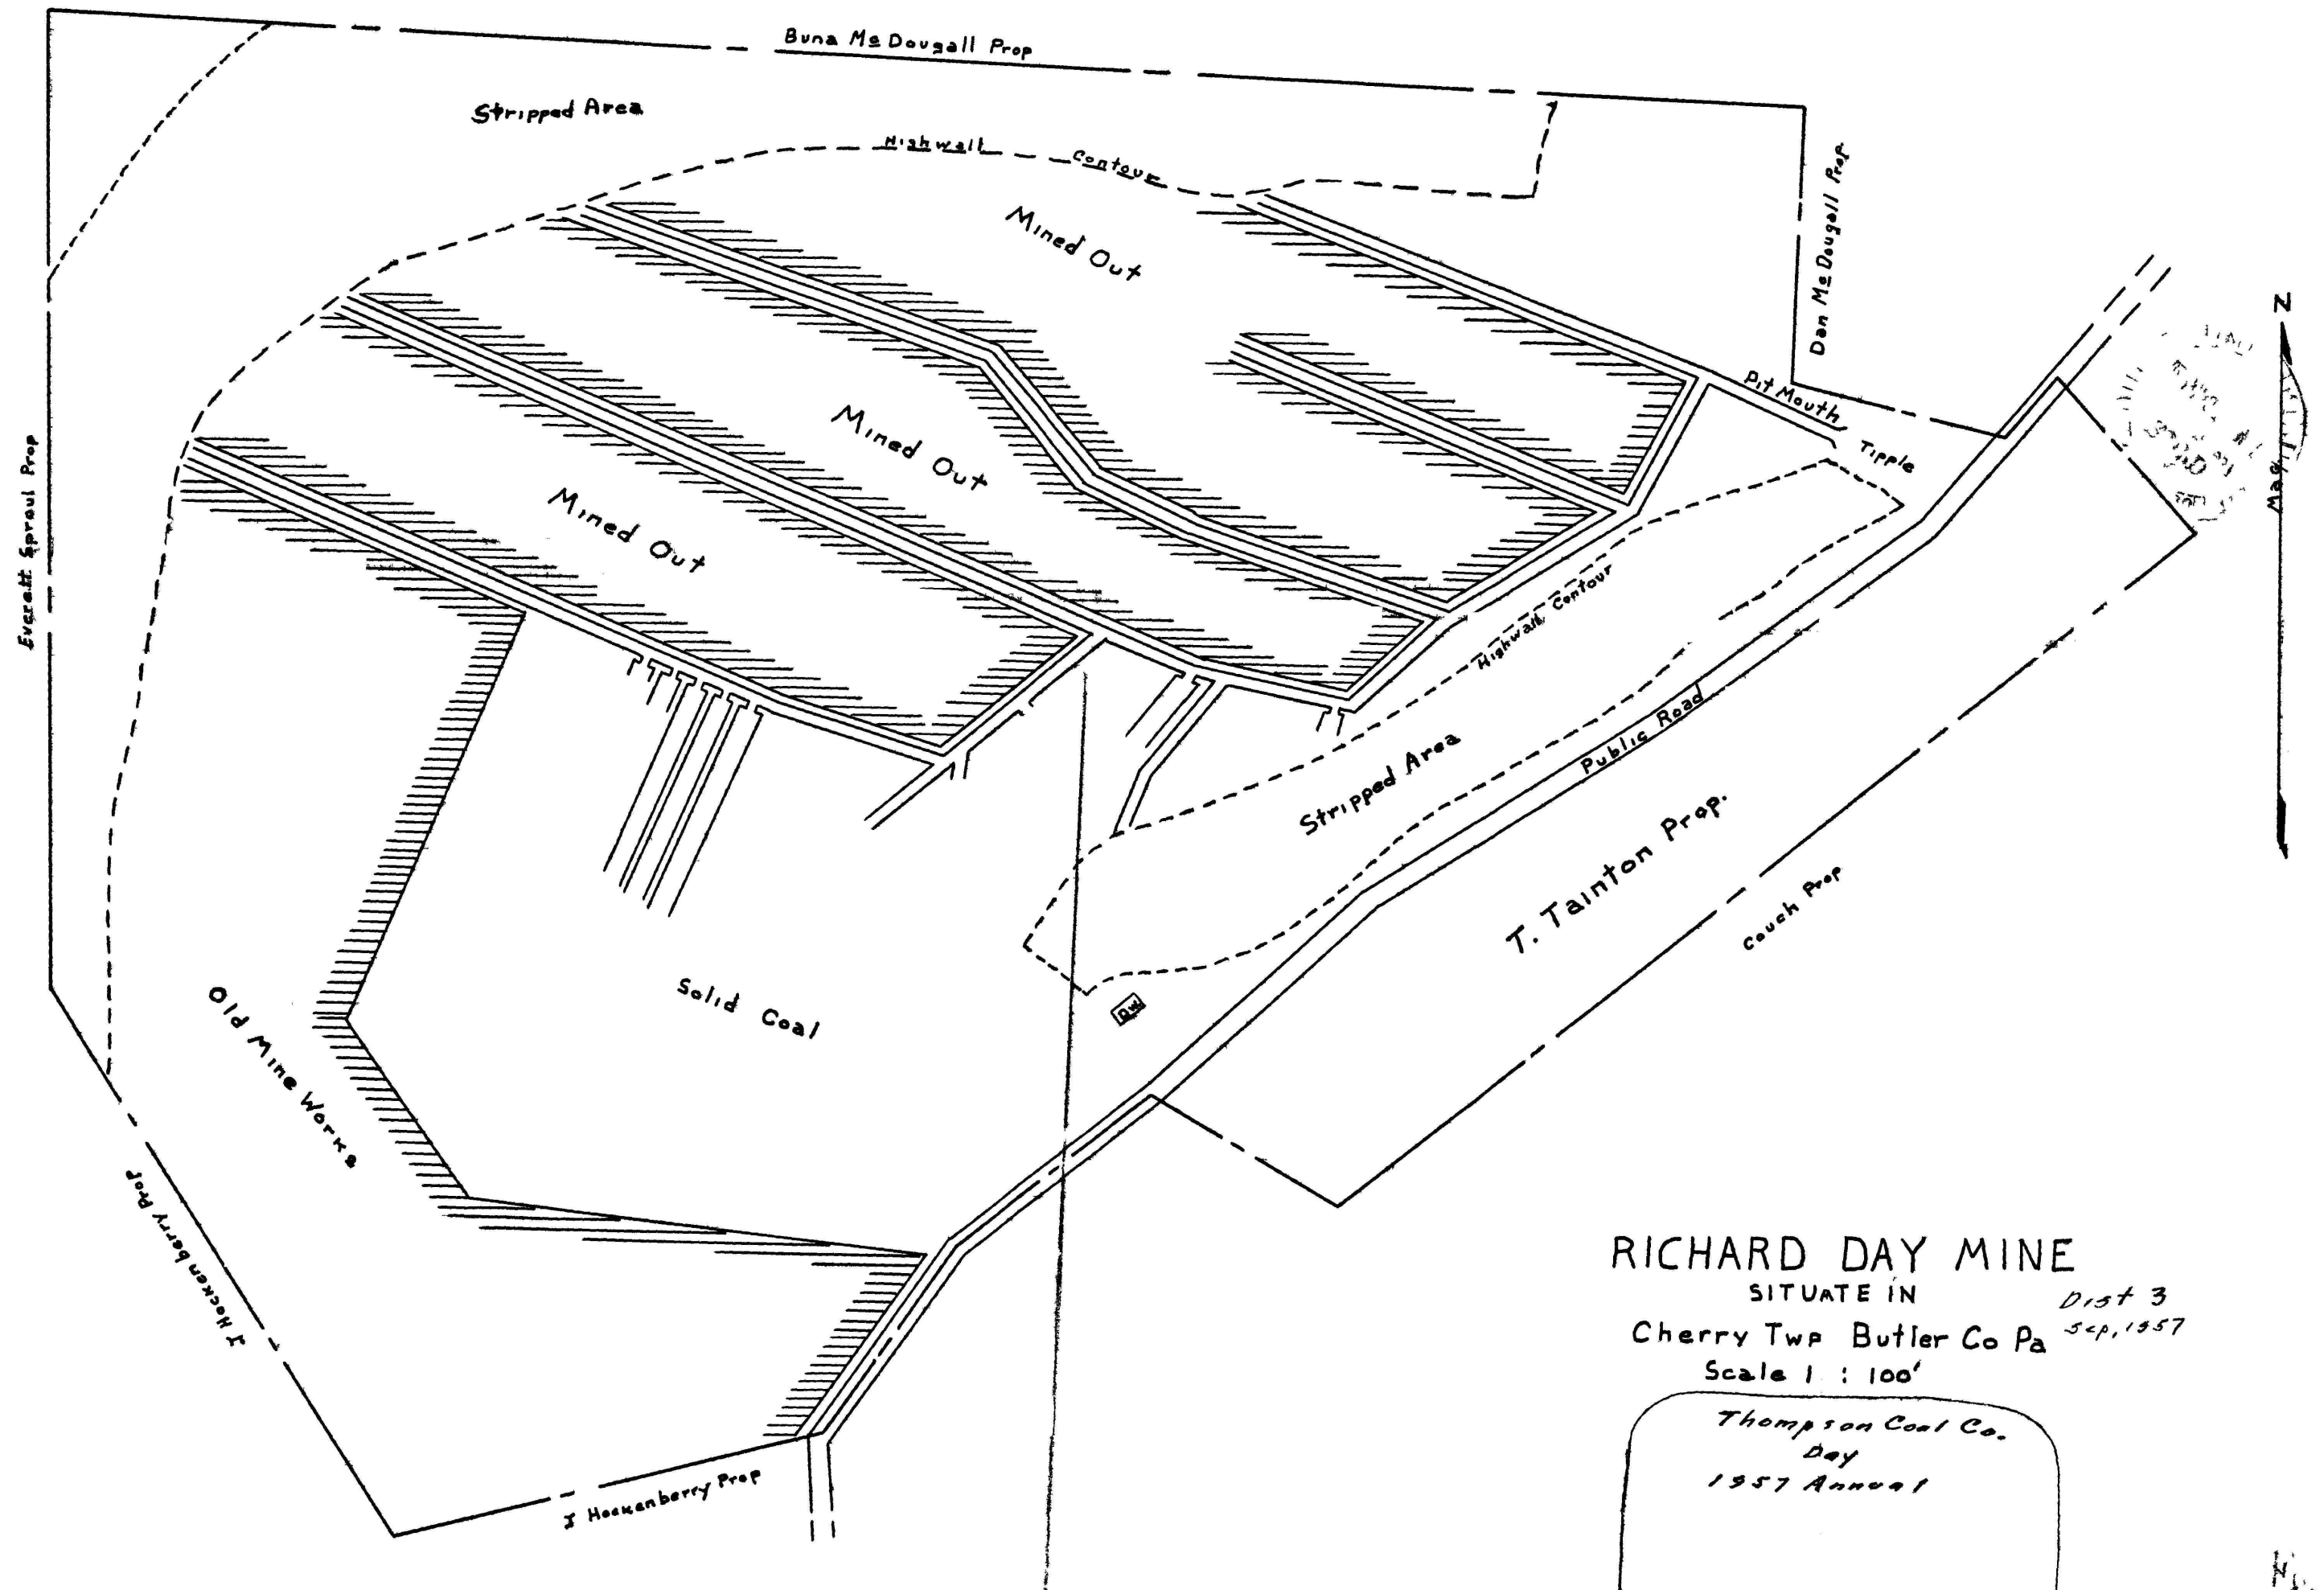

RICHARD DAY MINE

SITUATE IN *Dist 3*
 Cherry Twp Butler Co Pa *Scp, 1957*
 Scale 1 : 100'

Thompson Coal Co.
 Day
 1957 Annual

11/1/57
 #