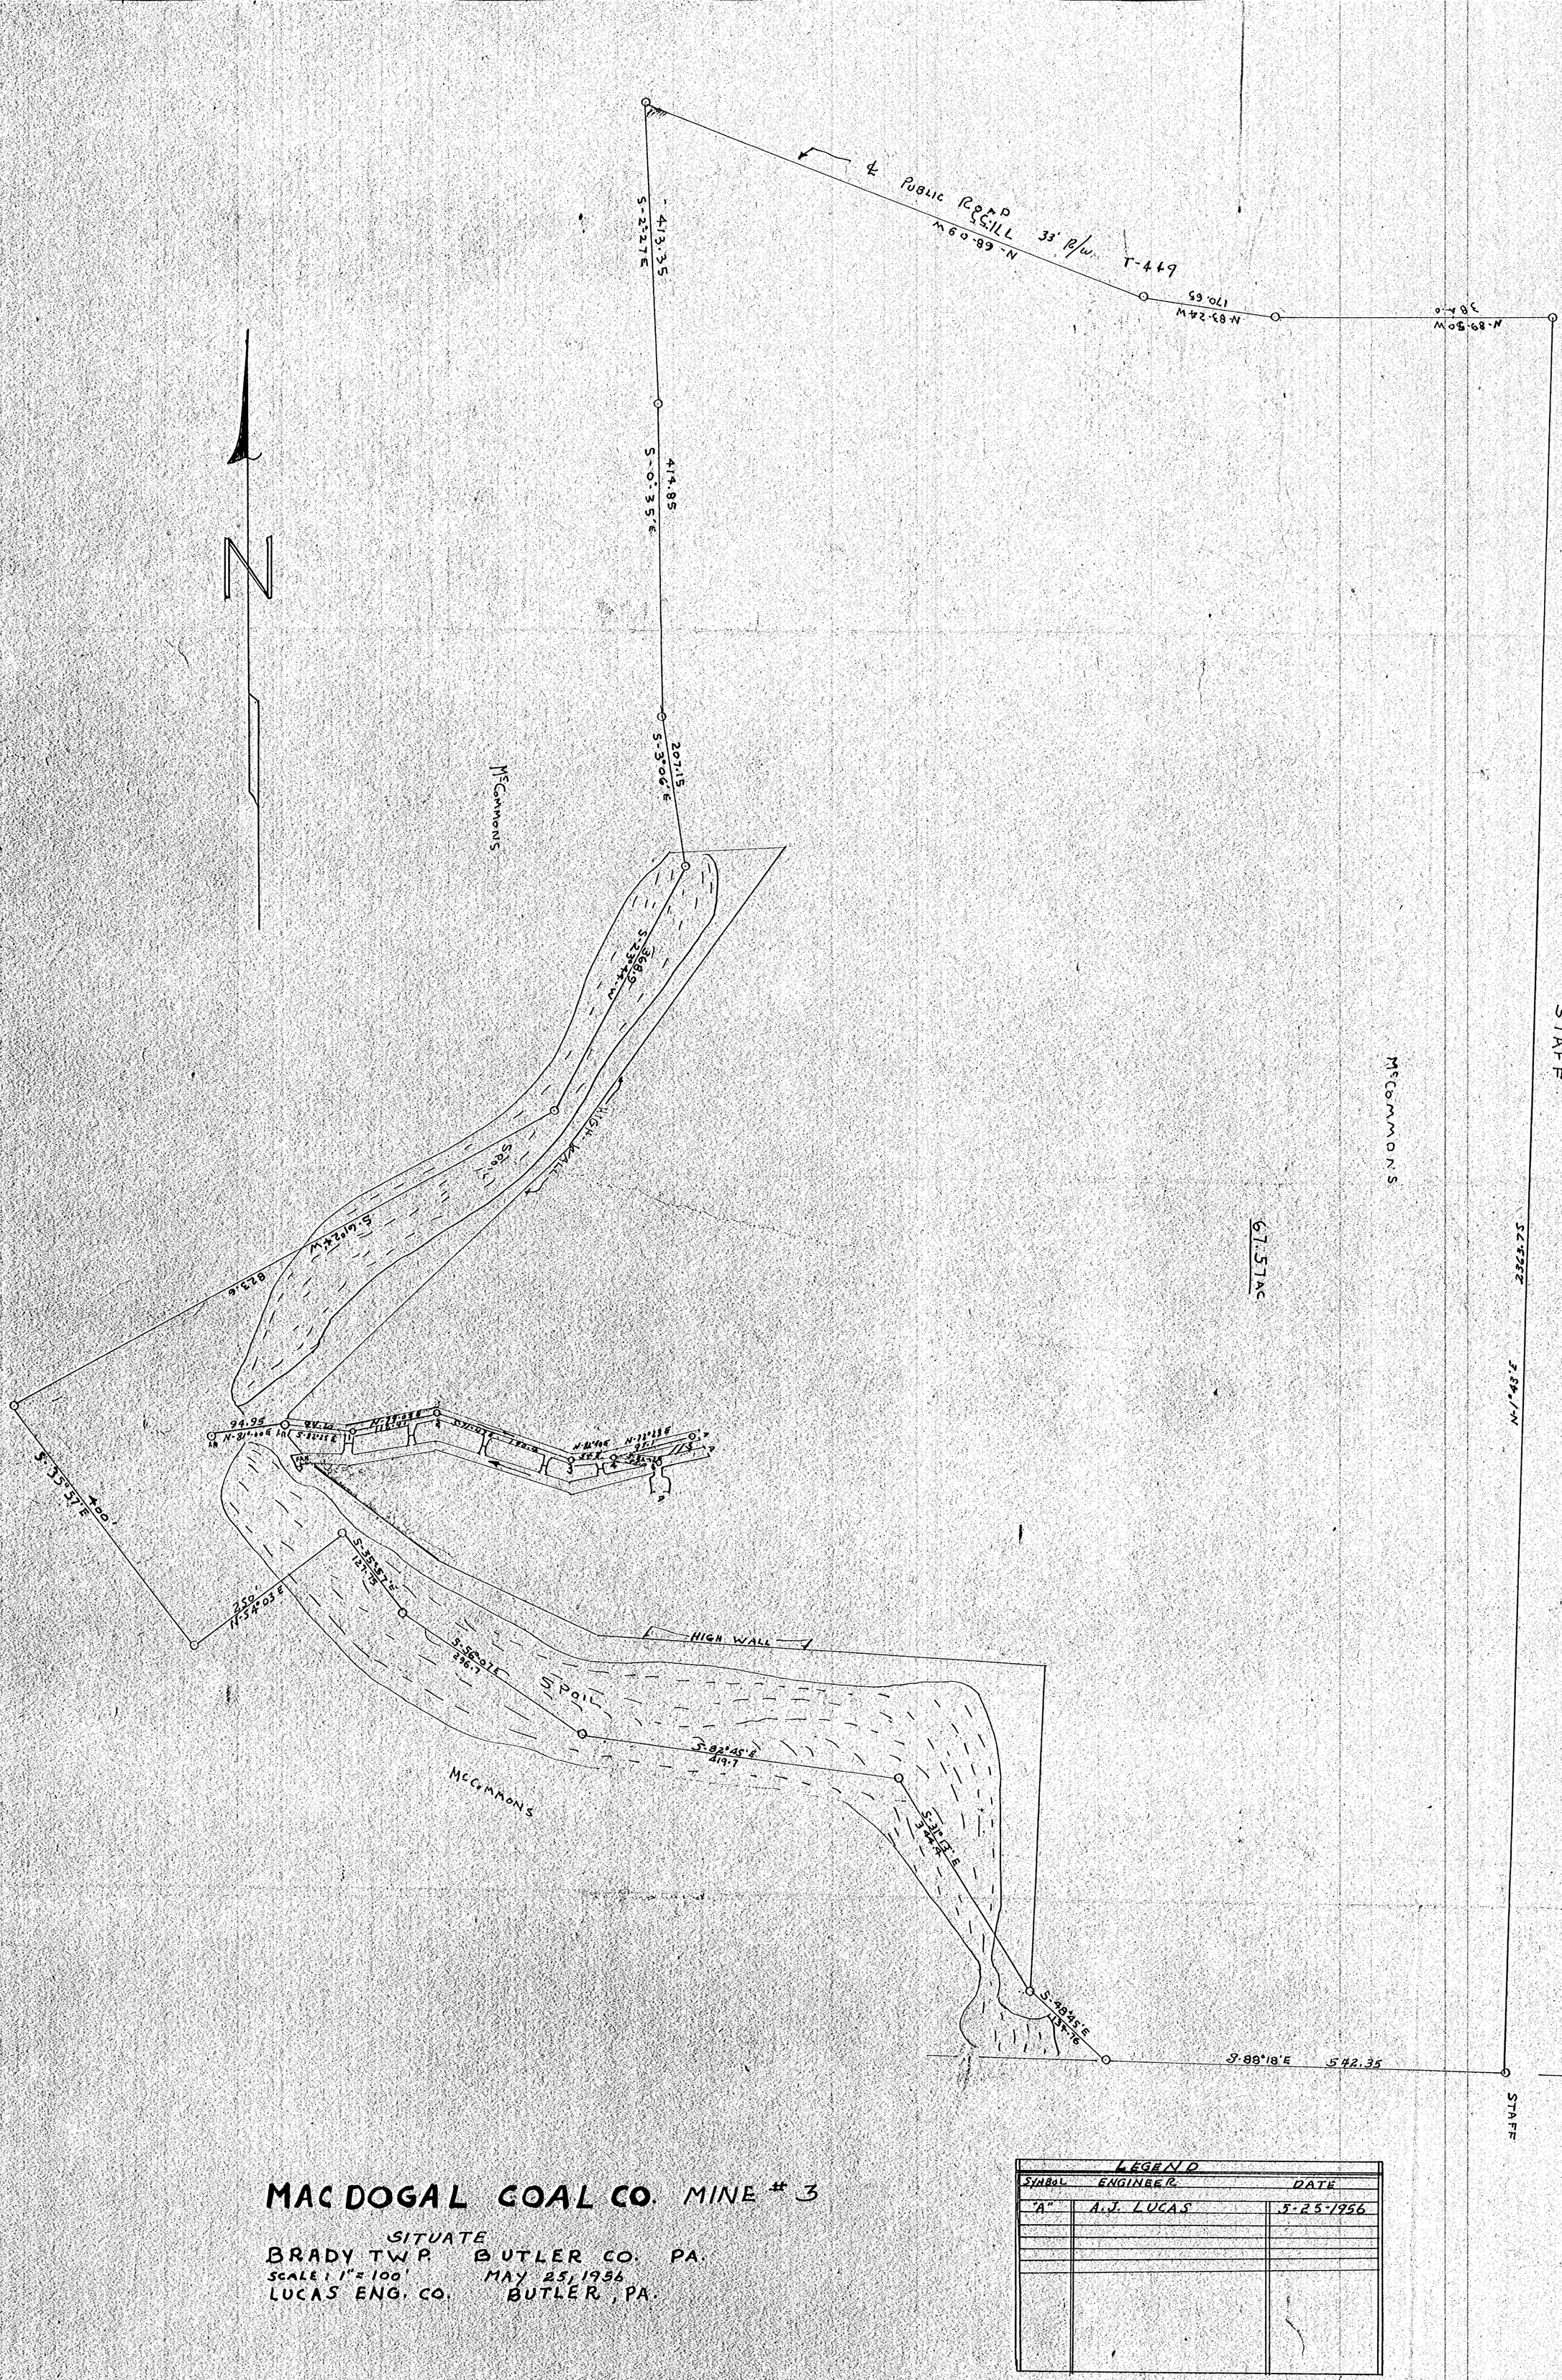



# MAC DOGAL COAL CO. MINE # 3

SITUATE
BRADY TWP. BUTLER CO. PA.
SCALE 1" = 100' MAY 25, 1956
LUCAS ENG. CO. BUTLER, PA.

LEGEND

| SYMBOL | ENGINEER | DATE |
|---|---|---|
| "A" | A.J. LUCAS | 5-25-1956 |