


FL-1-1

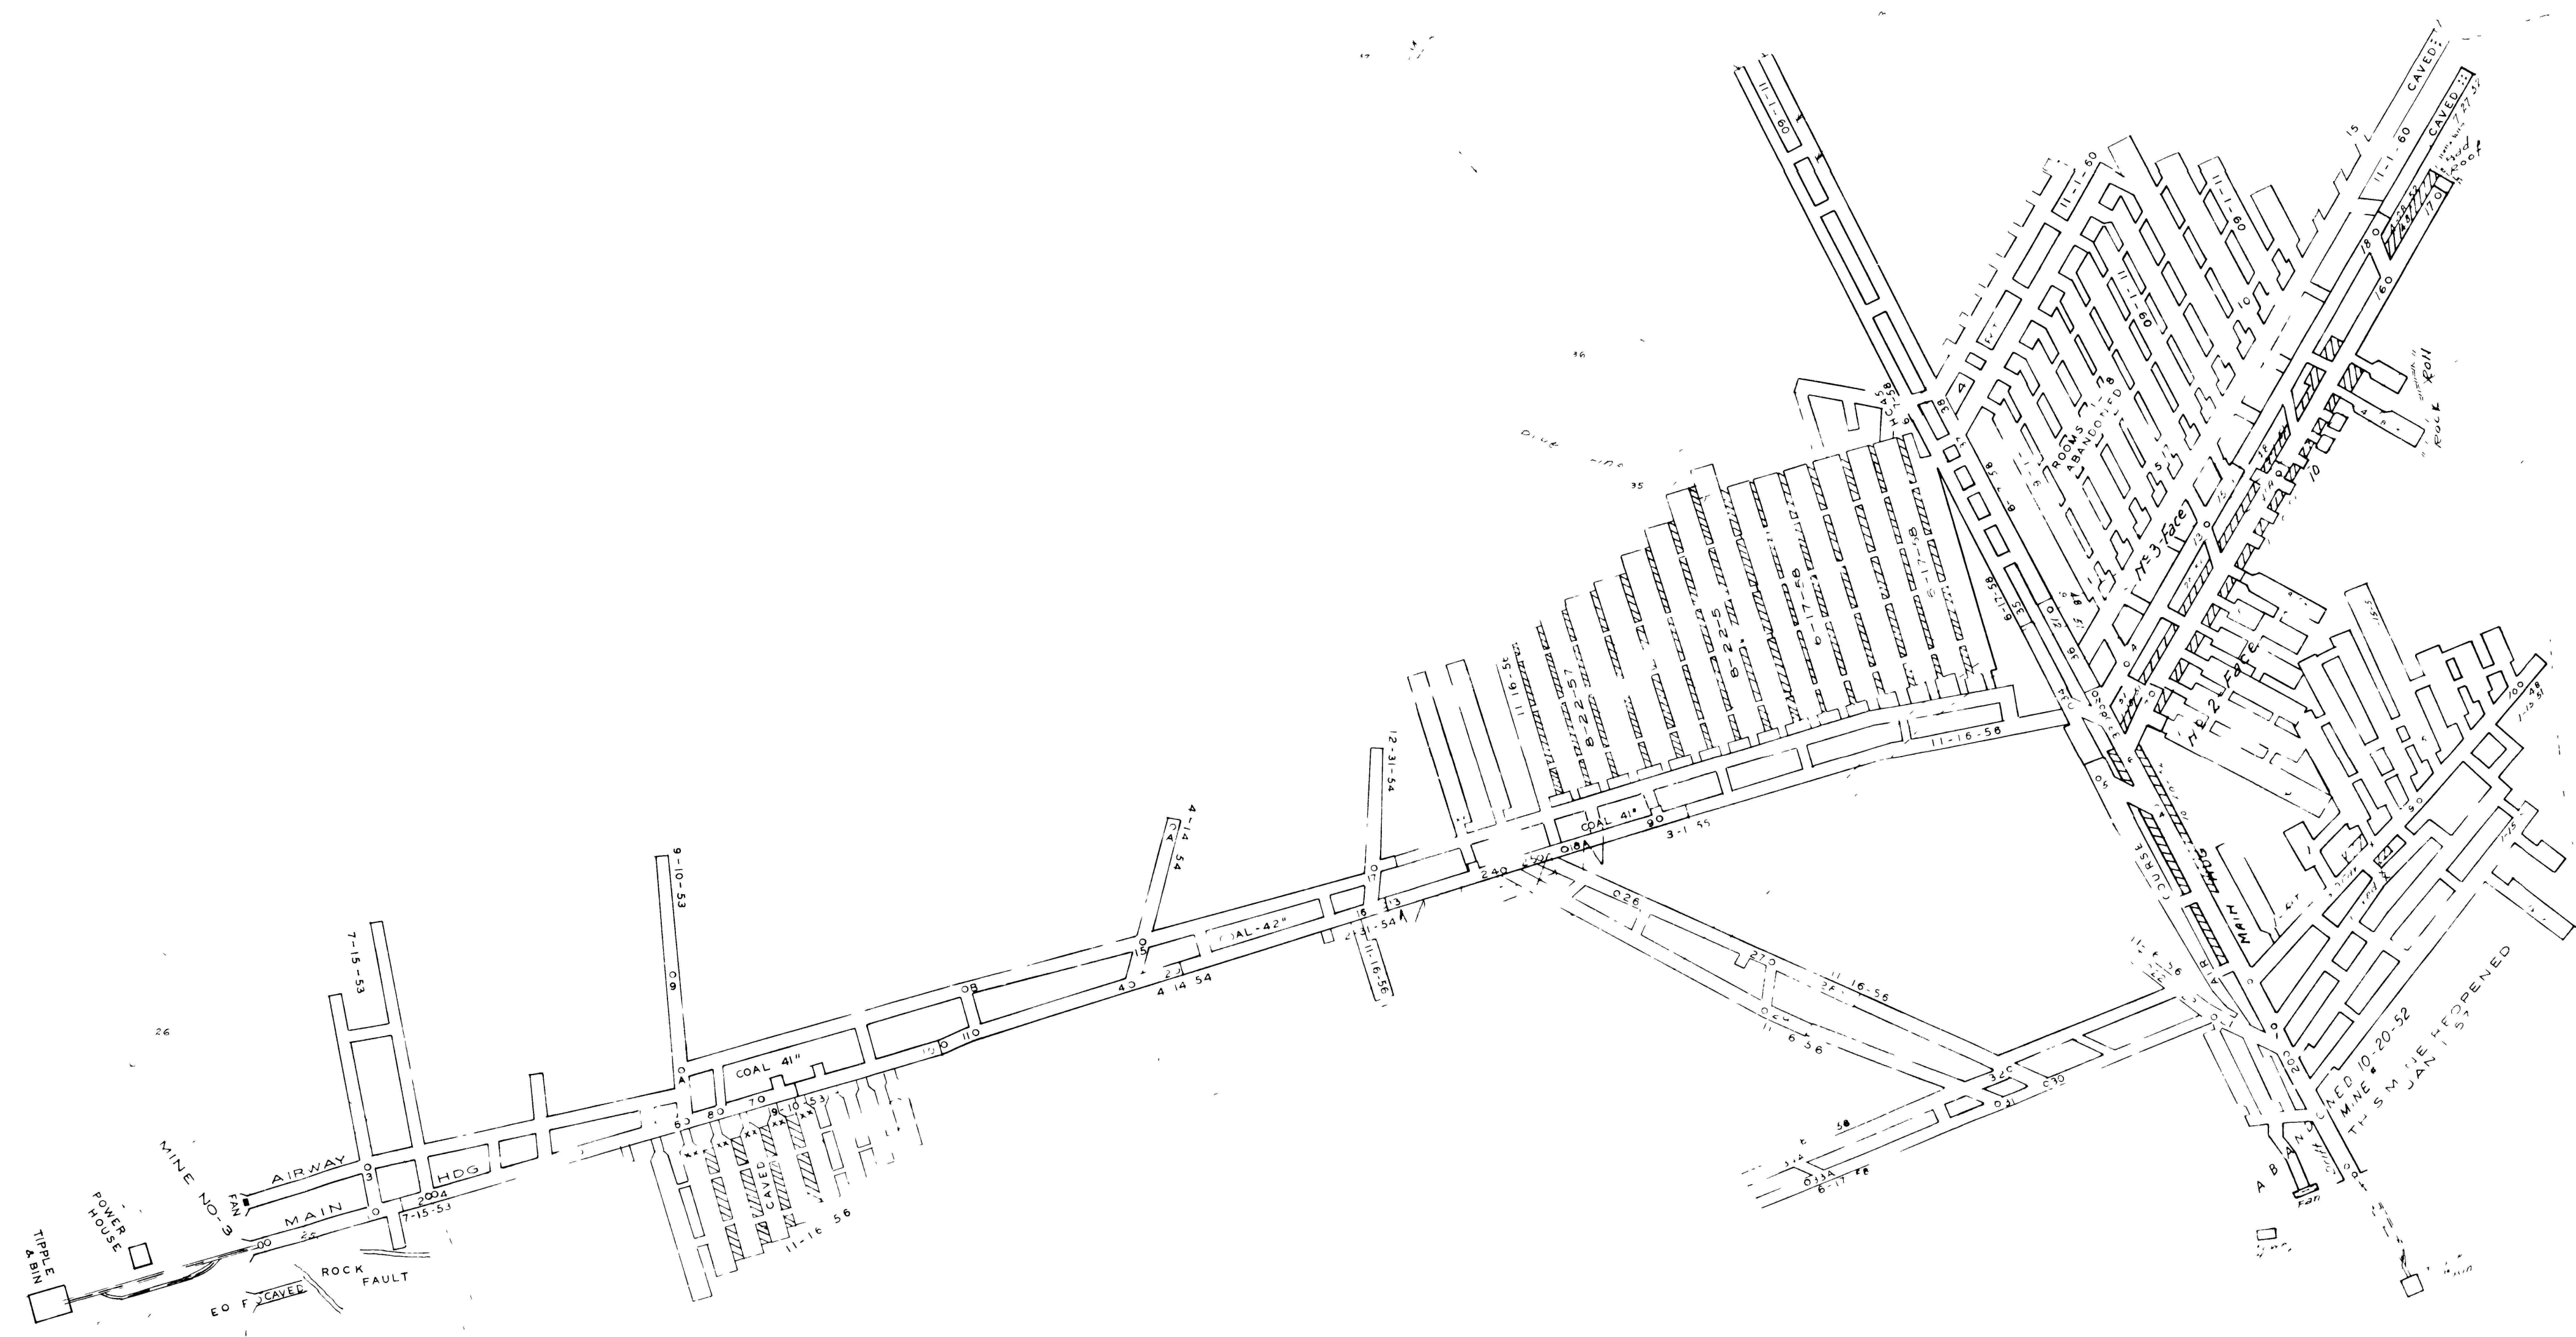

Note RE. MINE #1
I certify that the mine workings shown under date of
10-30-52 are true and correct to the best of my knowledge
and ability, and this mine ceased operation as of that date.
Operator Lawrence Brink, Conansville, Pa. 160
THIS MINE REOPENED - JAN 1 57
#1 MINE #1 63 6512
East Brady, Pa.

BRINK COAL CO

MINE NO. 1 & 3
UPPER FREEPORT VEIN
SUGAR CREEK TWP. ARMSTRONG CO. PA.
SCALE 1-100'

REVISED 1-57
REVISED 1-13-6

LEGEND

- SURVEYED MINE WORKINGS
- PROPOSED DEVELOPMENT
- HIGH WALL FROM STRIPPING
- PRODUCING WELL

#359
6-16-99
C.C.