

N


Harvey K. Glessner

Charles Shank

Charles Shank

Charles Shank

Harvey K. Glessner

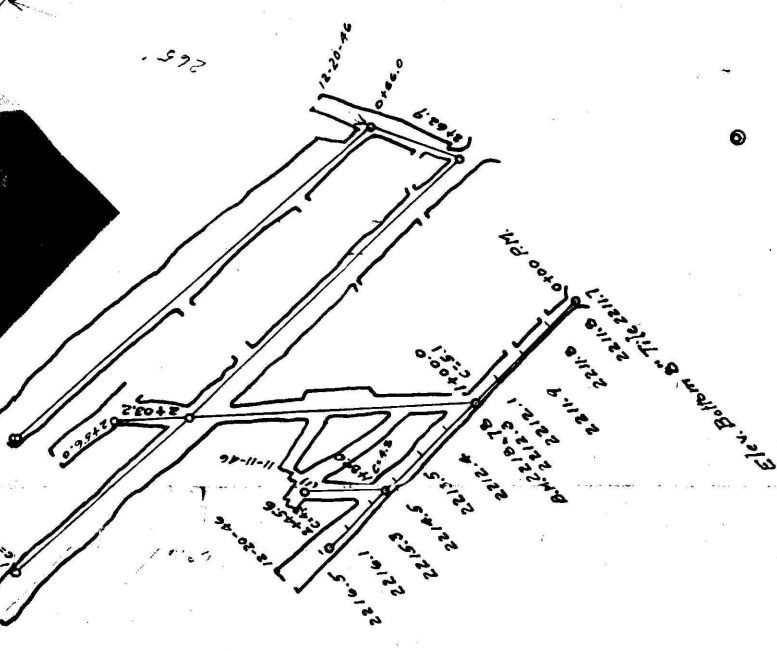

To Coleman Branch

B.M. Elev. 224.28 B.B. spike in 8\"/>

B.M. Elev. 224.28 B.B. spike in 8\"/>

Tobias Speicher

STONY CREEK

Yoder Mine

Robert Young Dist. 20

STONYCREEK TWP. SOMERSET CO.

PENNA.

Scale 1"=100 Feet

Harry W. Kimmerel
Reg. Surveyor

Note: Location of property corners are taken from description given in deed and are not from actual survey.