


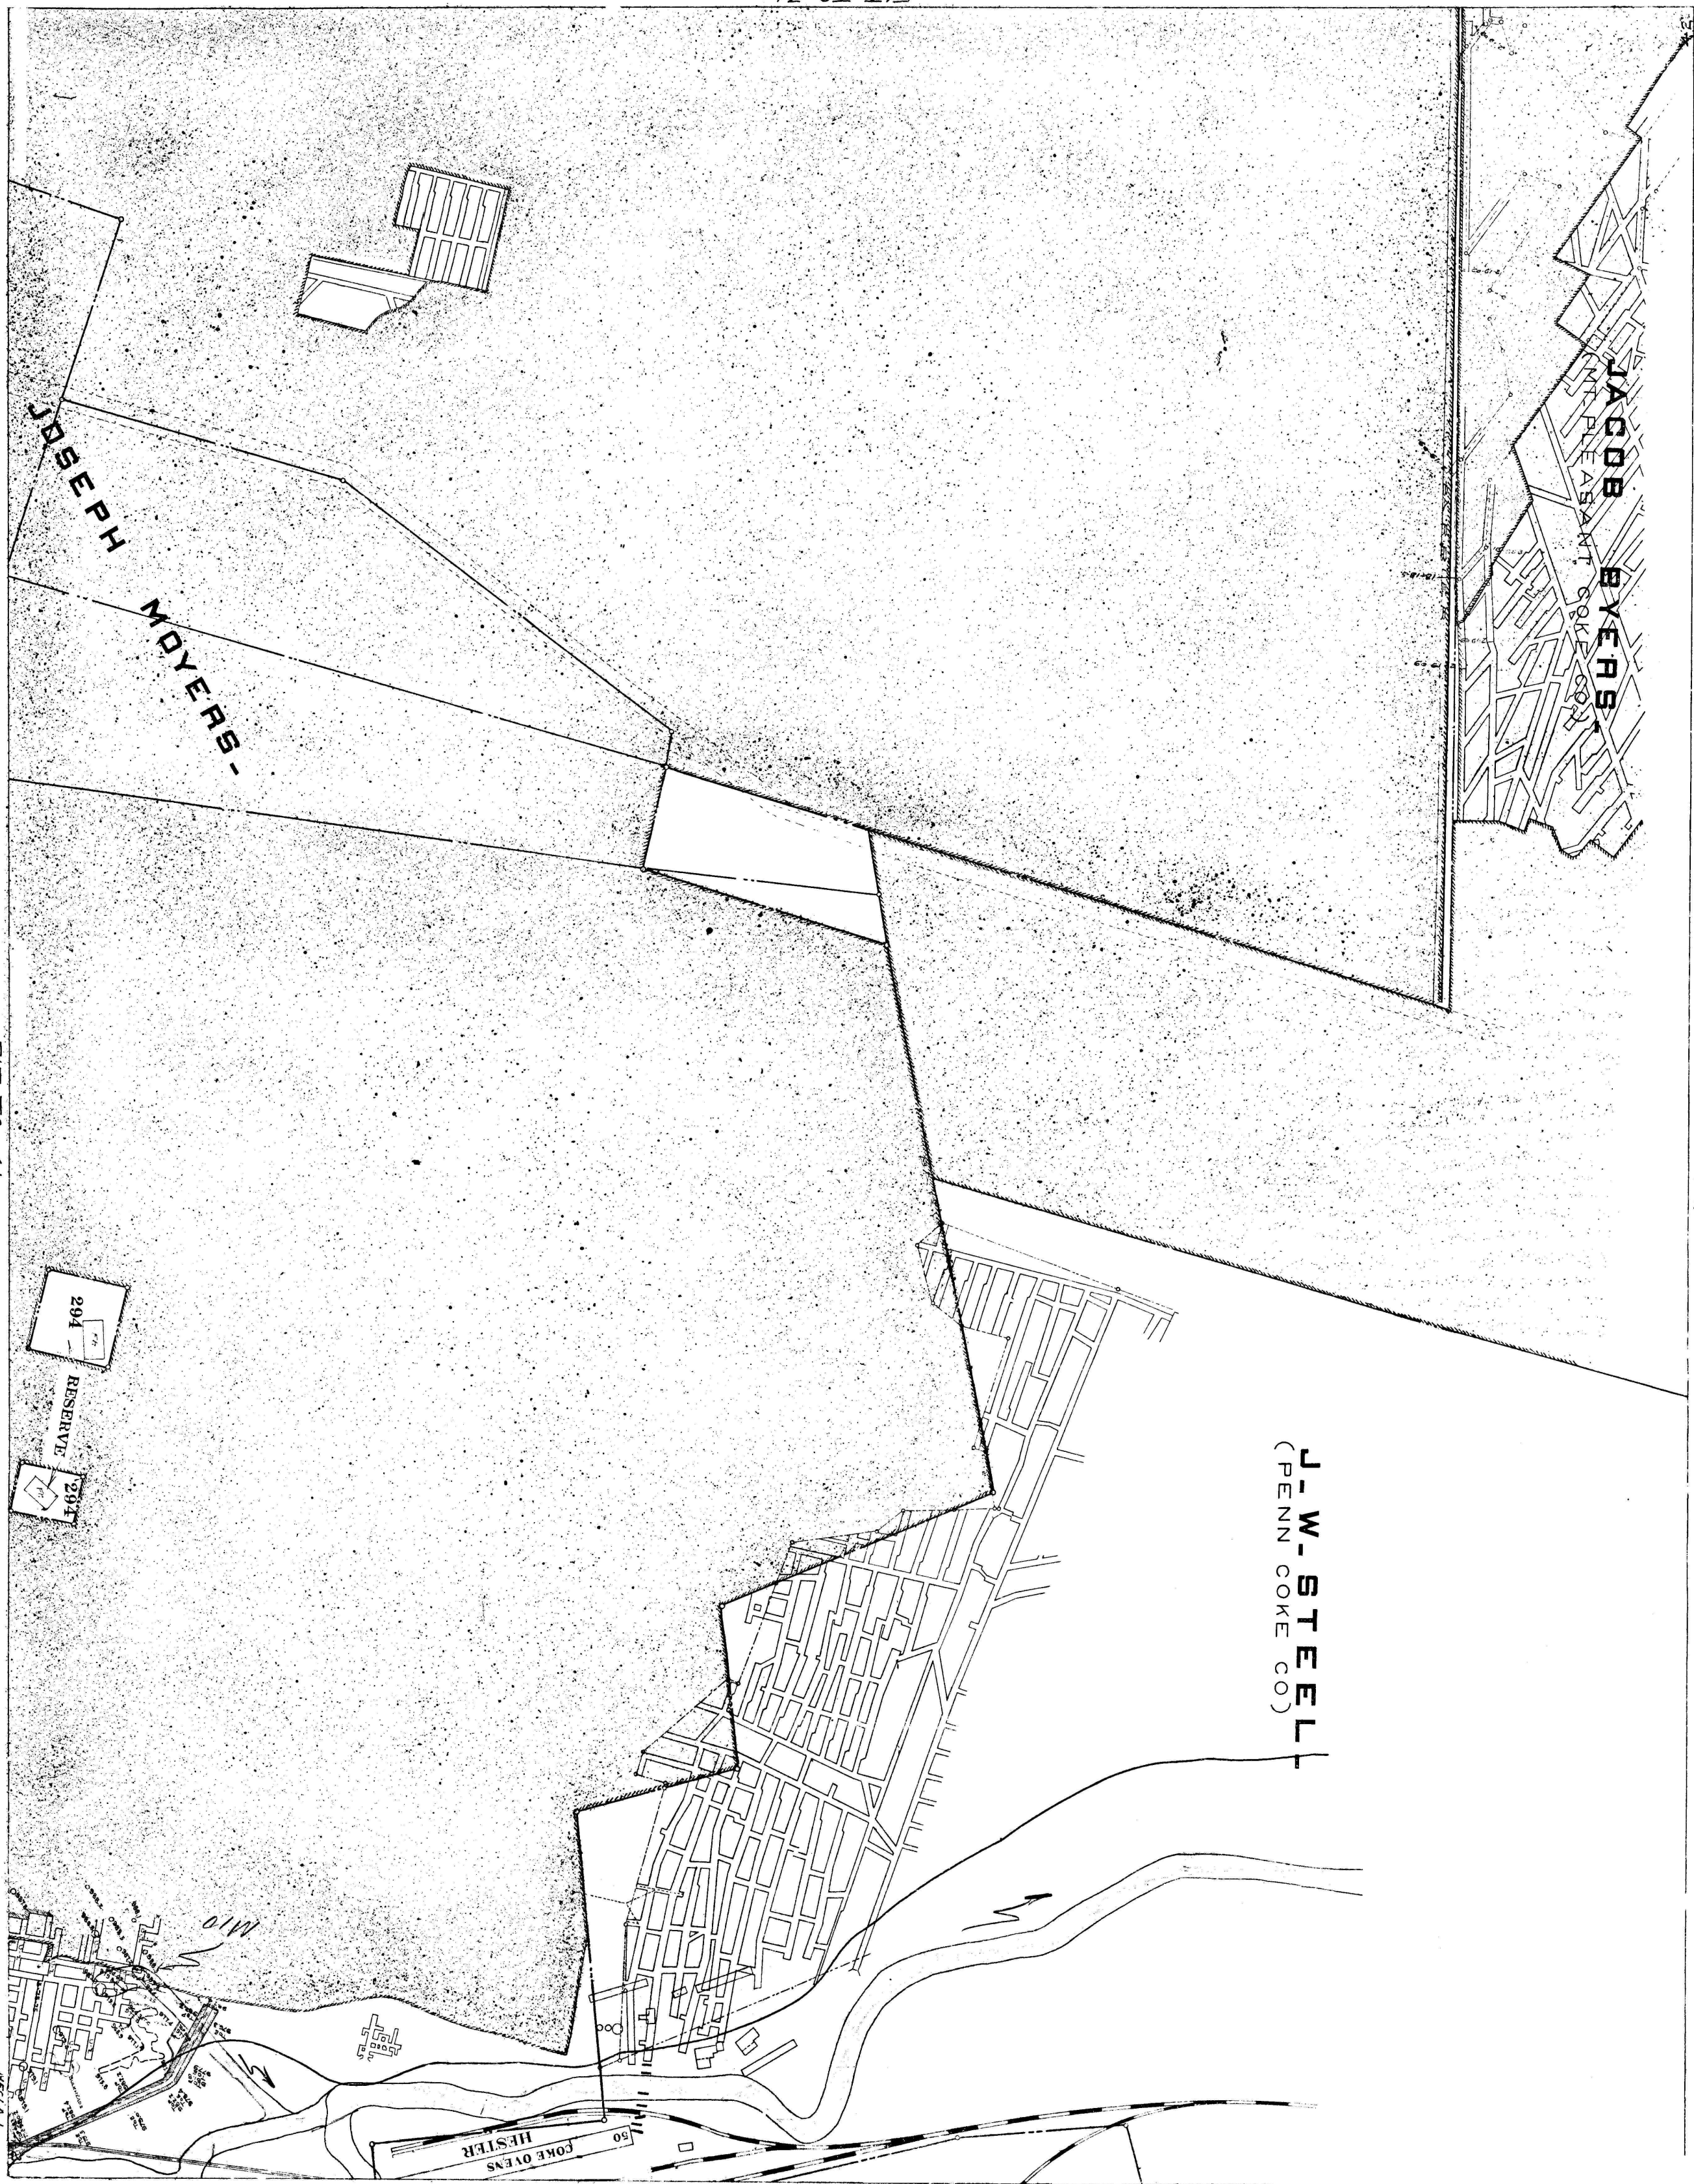

FIT TO 31

FIT TO 41

FIT TO 52