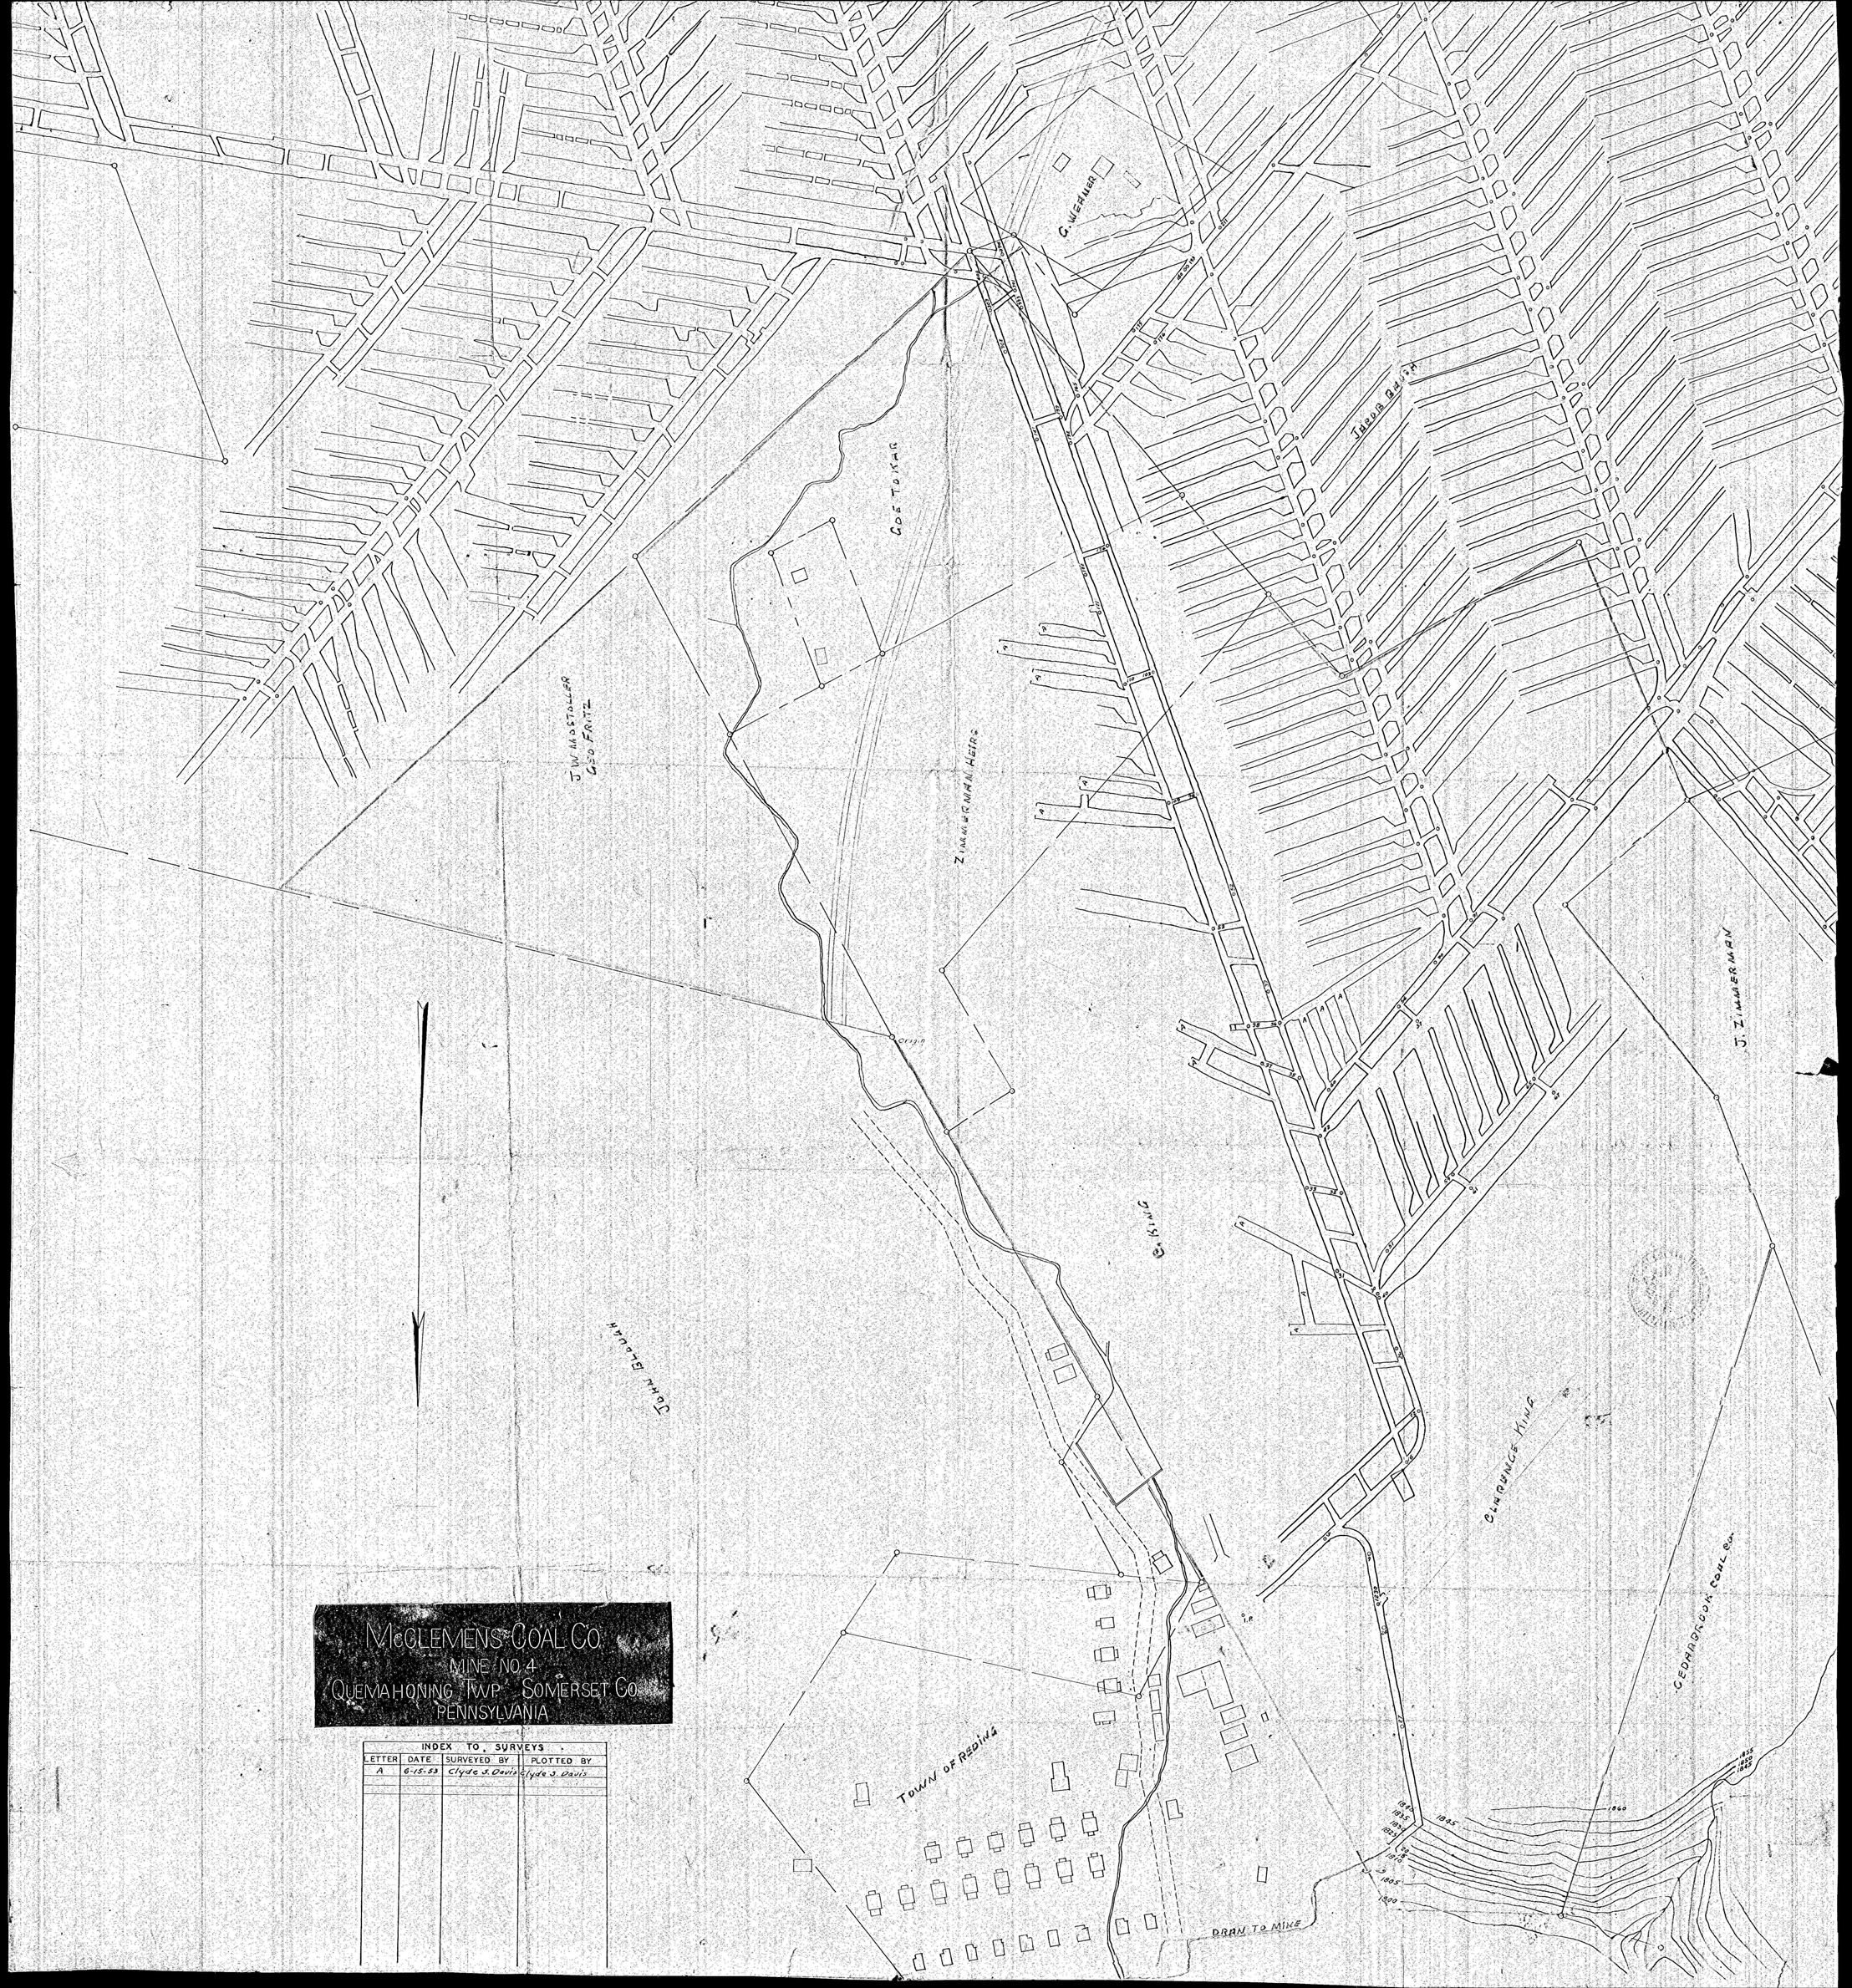
McCLEMENS COAL CO.
MINE NO. 4
QUEMAHONING TWP. SOMERSET CO.
PENNSYLVANIA
INDEX TO SURVEYS
LETTER | DATE | SURVEYED BY | PLOTTED BY
A | 6-15-53 | Clyde S. Davis | Clyde S. Davis
G. WEAVER
JACOB BAUGH
GOE TOKAR
J.W. MOSTOLLER
GEO FRITZ
ZIMMERMAN HEIRS
J. ZIMMERMAN
C. KING
JOHN BLOUGH
CLARENCE KING
CEDARBROOK COAL CO.
TOWN OF REDING
DRAIN TO MINE