


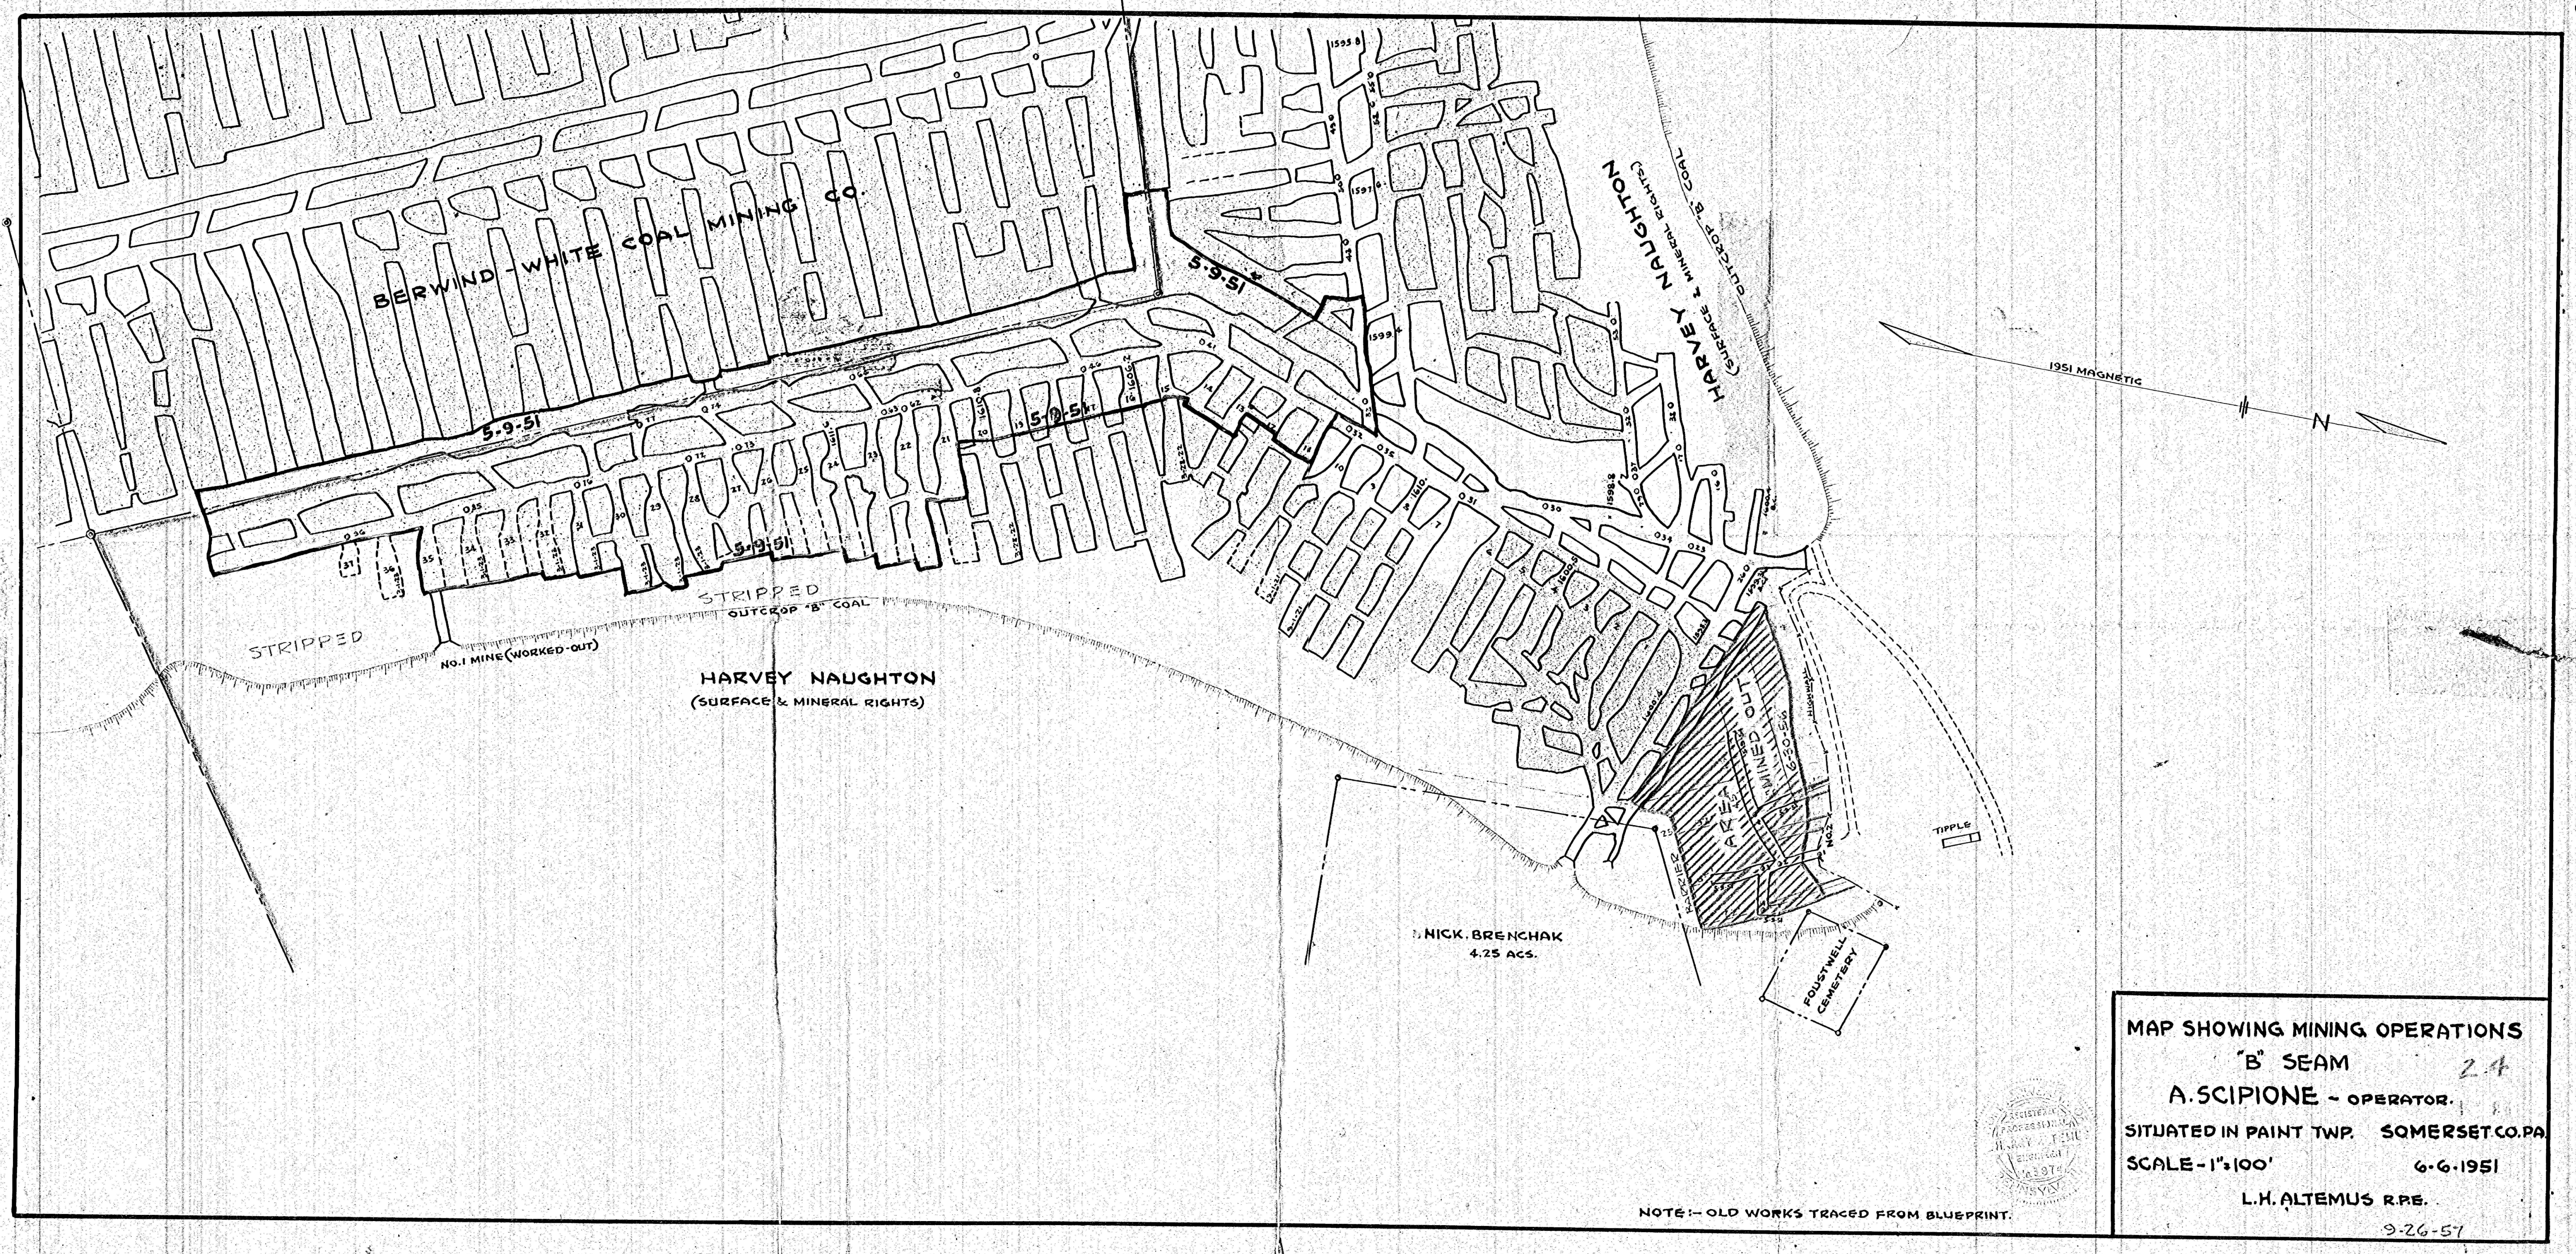

MAP SHOWING MINING OPERATIONS
"B" SEAM
A. SCIPIONE - OPERATOR.
SITUATED IN PAINT TWP. SOMERSET CO. PA.
SCALE - 1" = 100'
L.H. ALTEMUS R.P.E.
9-26-57

NOTE: - OLD WORKS TRACED FROM BLUEPRINT.