


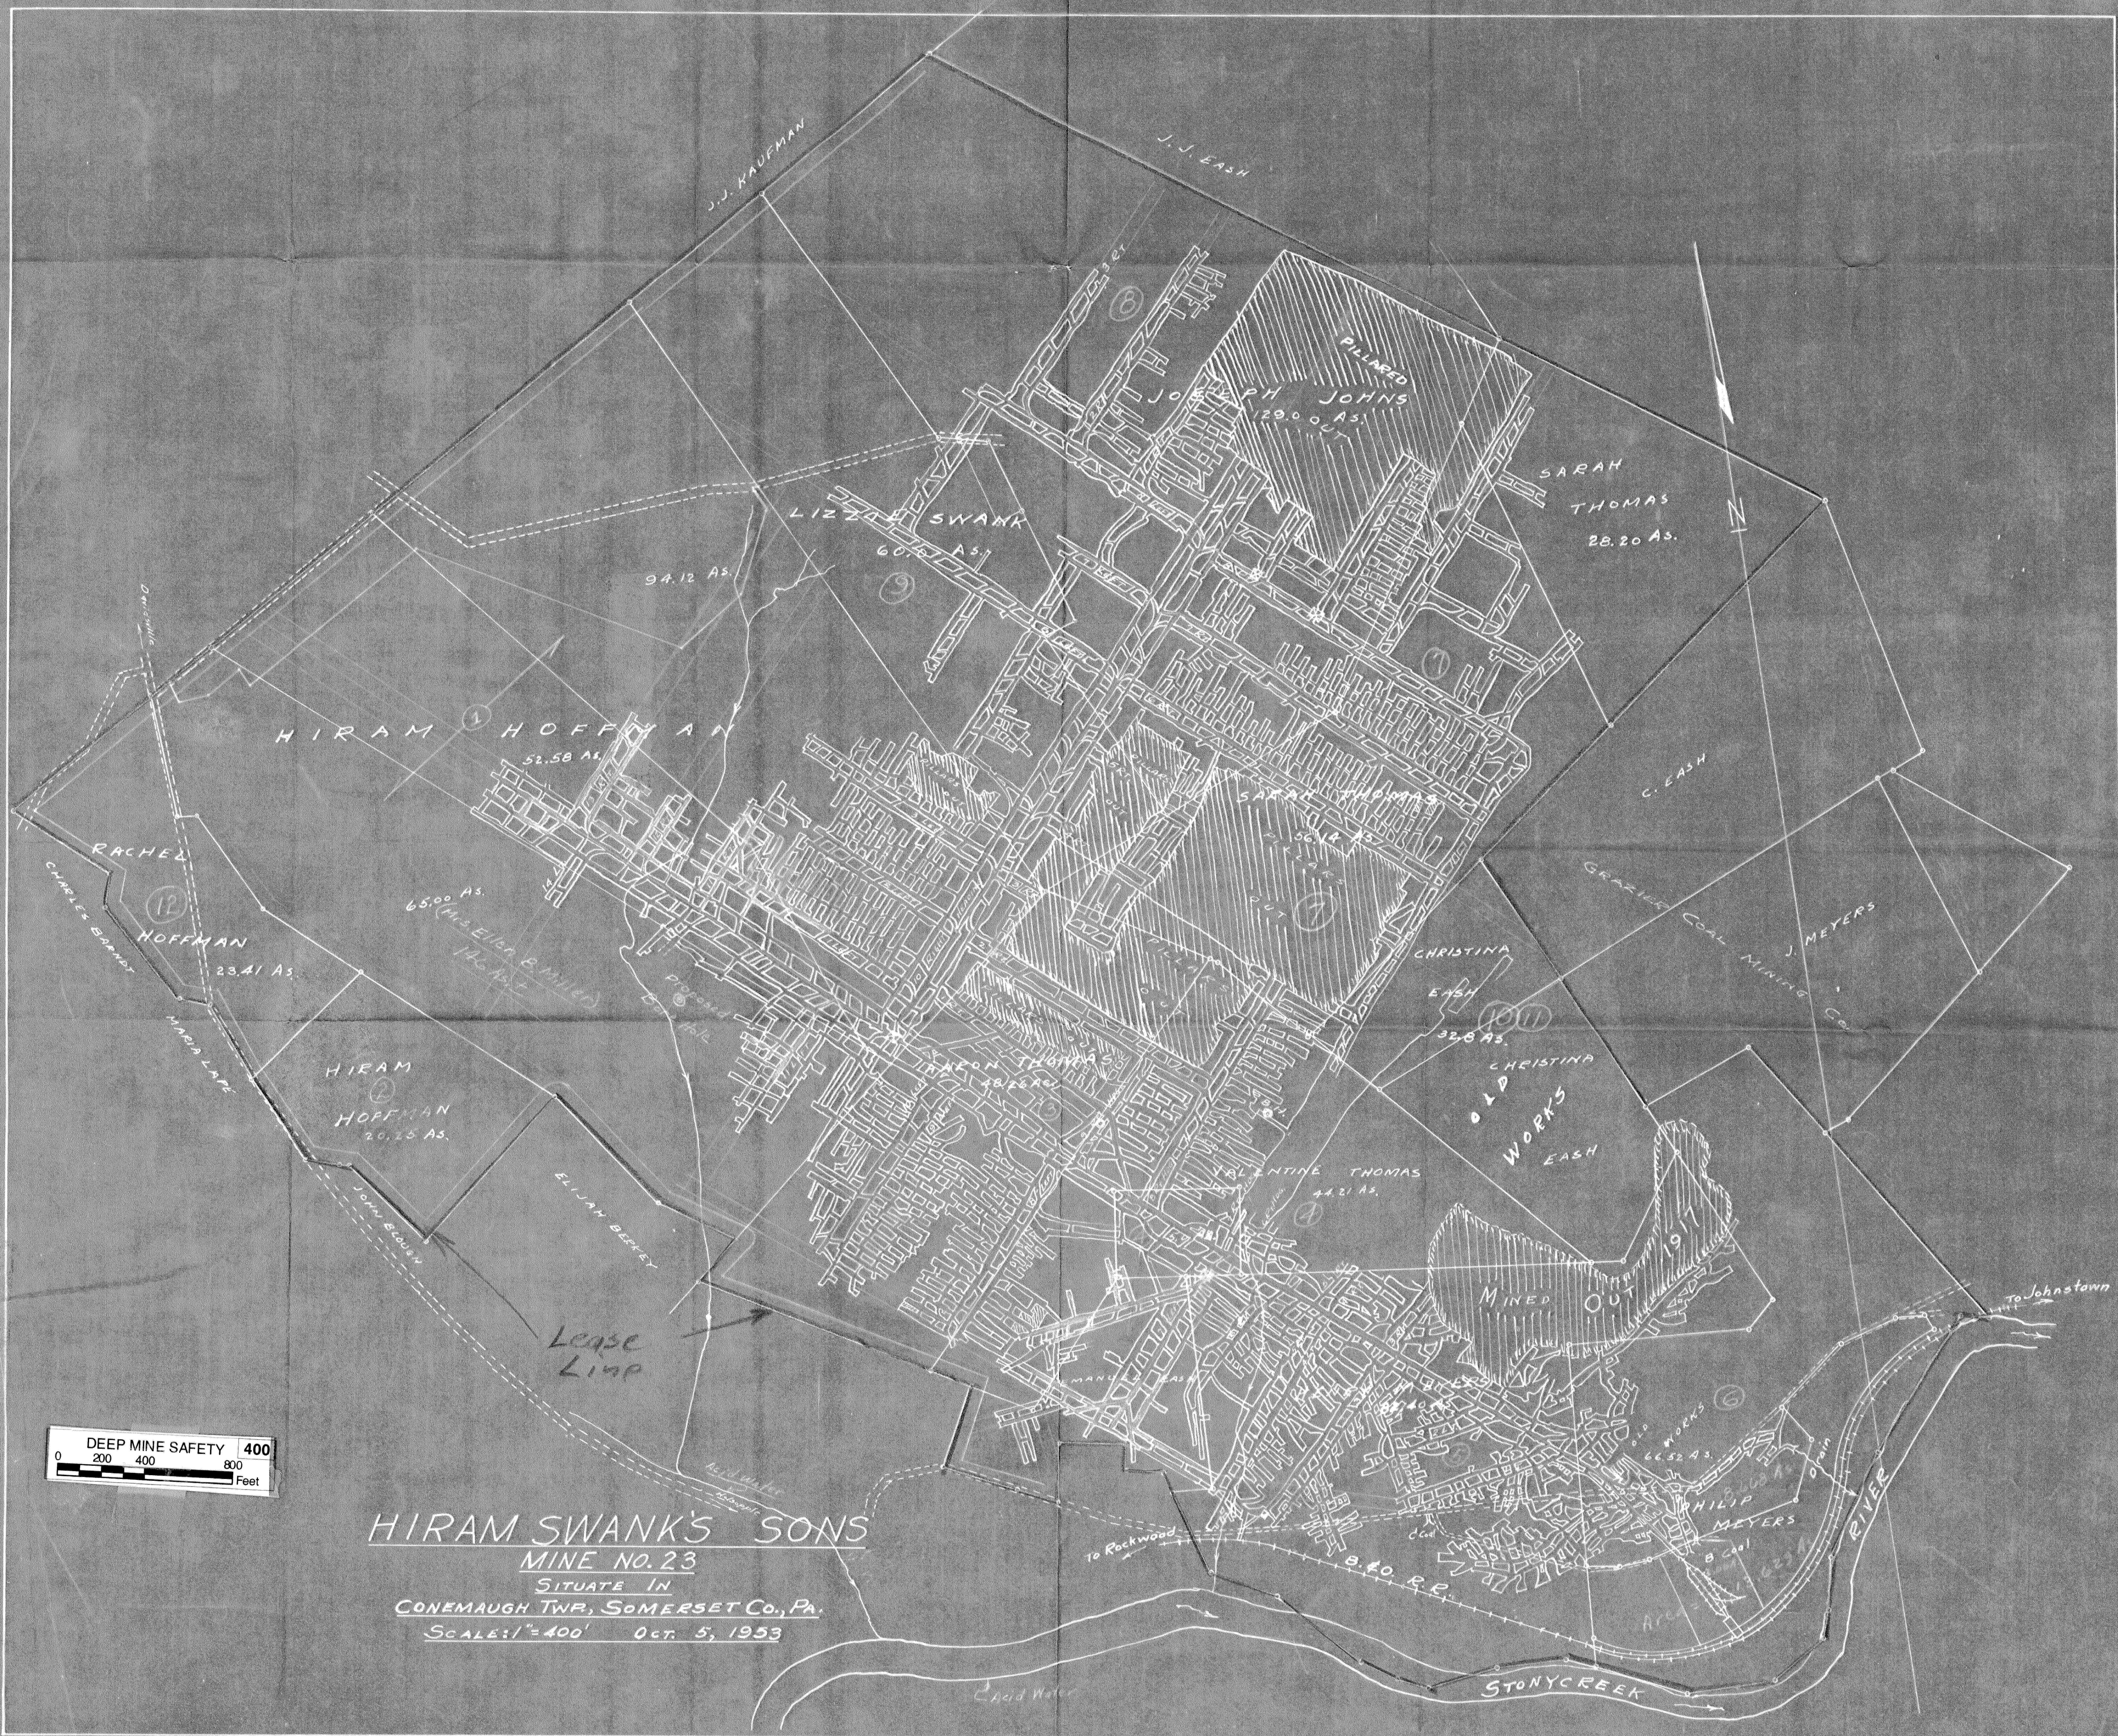

DEEP MINE SAFETY 400
0 200 400 800
Feet

HIRAM SWANK'S SONS
MINE NO. 23
SITUATE IN
CONEMAUGH TWP., SOMERSET CO., PA.
SCALE: 1"=400' Oct. 5, 1953