


HIGGINS RUN COAL CO.
 MINING - OPERATION
 C-PRIME SEAM
 QUEMAHONING TWP
 SOMERSET CO. PA.
 11-19-1955
 L.H. ALTEMUS R.P.E.

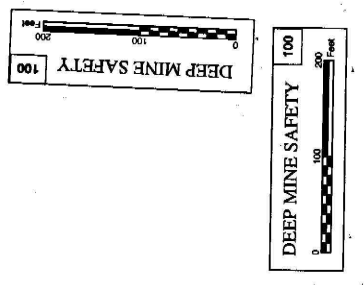

STRIKE
 DIP

BARRIER

NOTE - OLD WORKS OF RANDOLPH MINE
 RANDOLPH COAL CO. TRACED FROM
 BLUE PRINT LAST SURVEY DATE
 2-27-1926 BY E.B. FLOOD

S.P. ZIMMERMAN

MINED - OUT - 2-2-1926

VAL. HAY

FRED B. ZIMMERMAN - SURF
 (JACOB BERKEY)
 DEERFIELD COAL CO. - MINERAL

SPRING HOUSE

JACK STERN

J. OBER

