




ROBERT KOHLER COAL CO.,
 SHADE TWP, SOMERSET CO, PA
 SCALE 1"=100' SURVEYED AS NOTED
 DIST. 24 W.J. BATTISTA R.R.E.

24

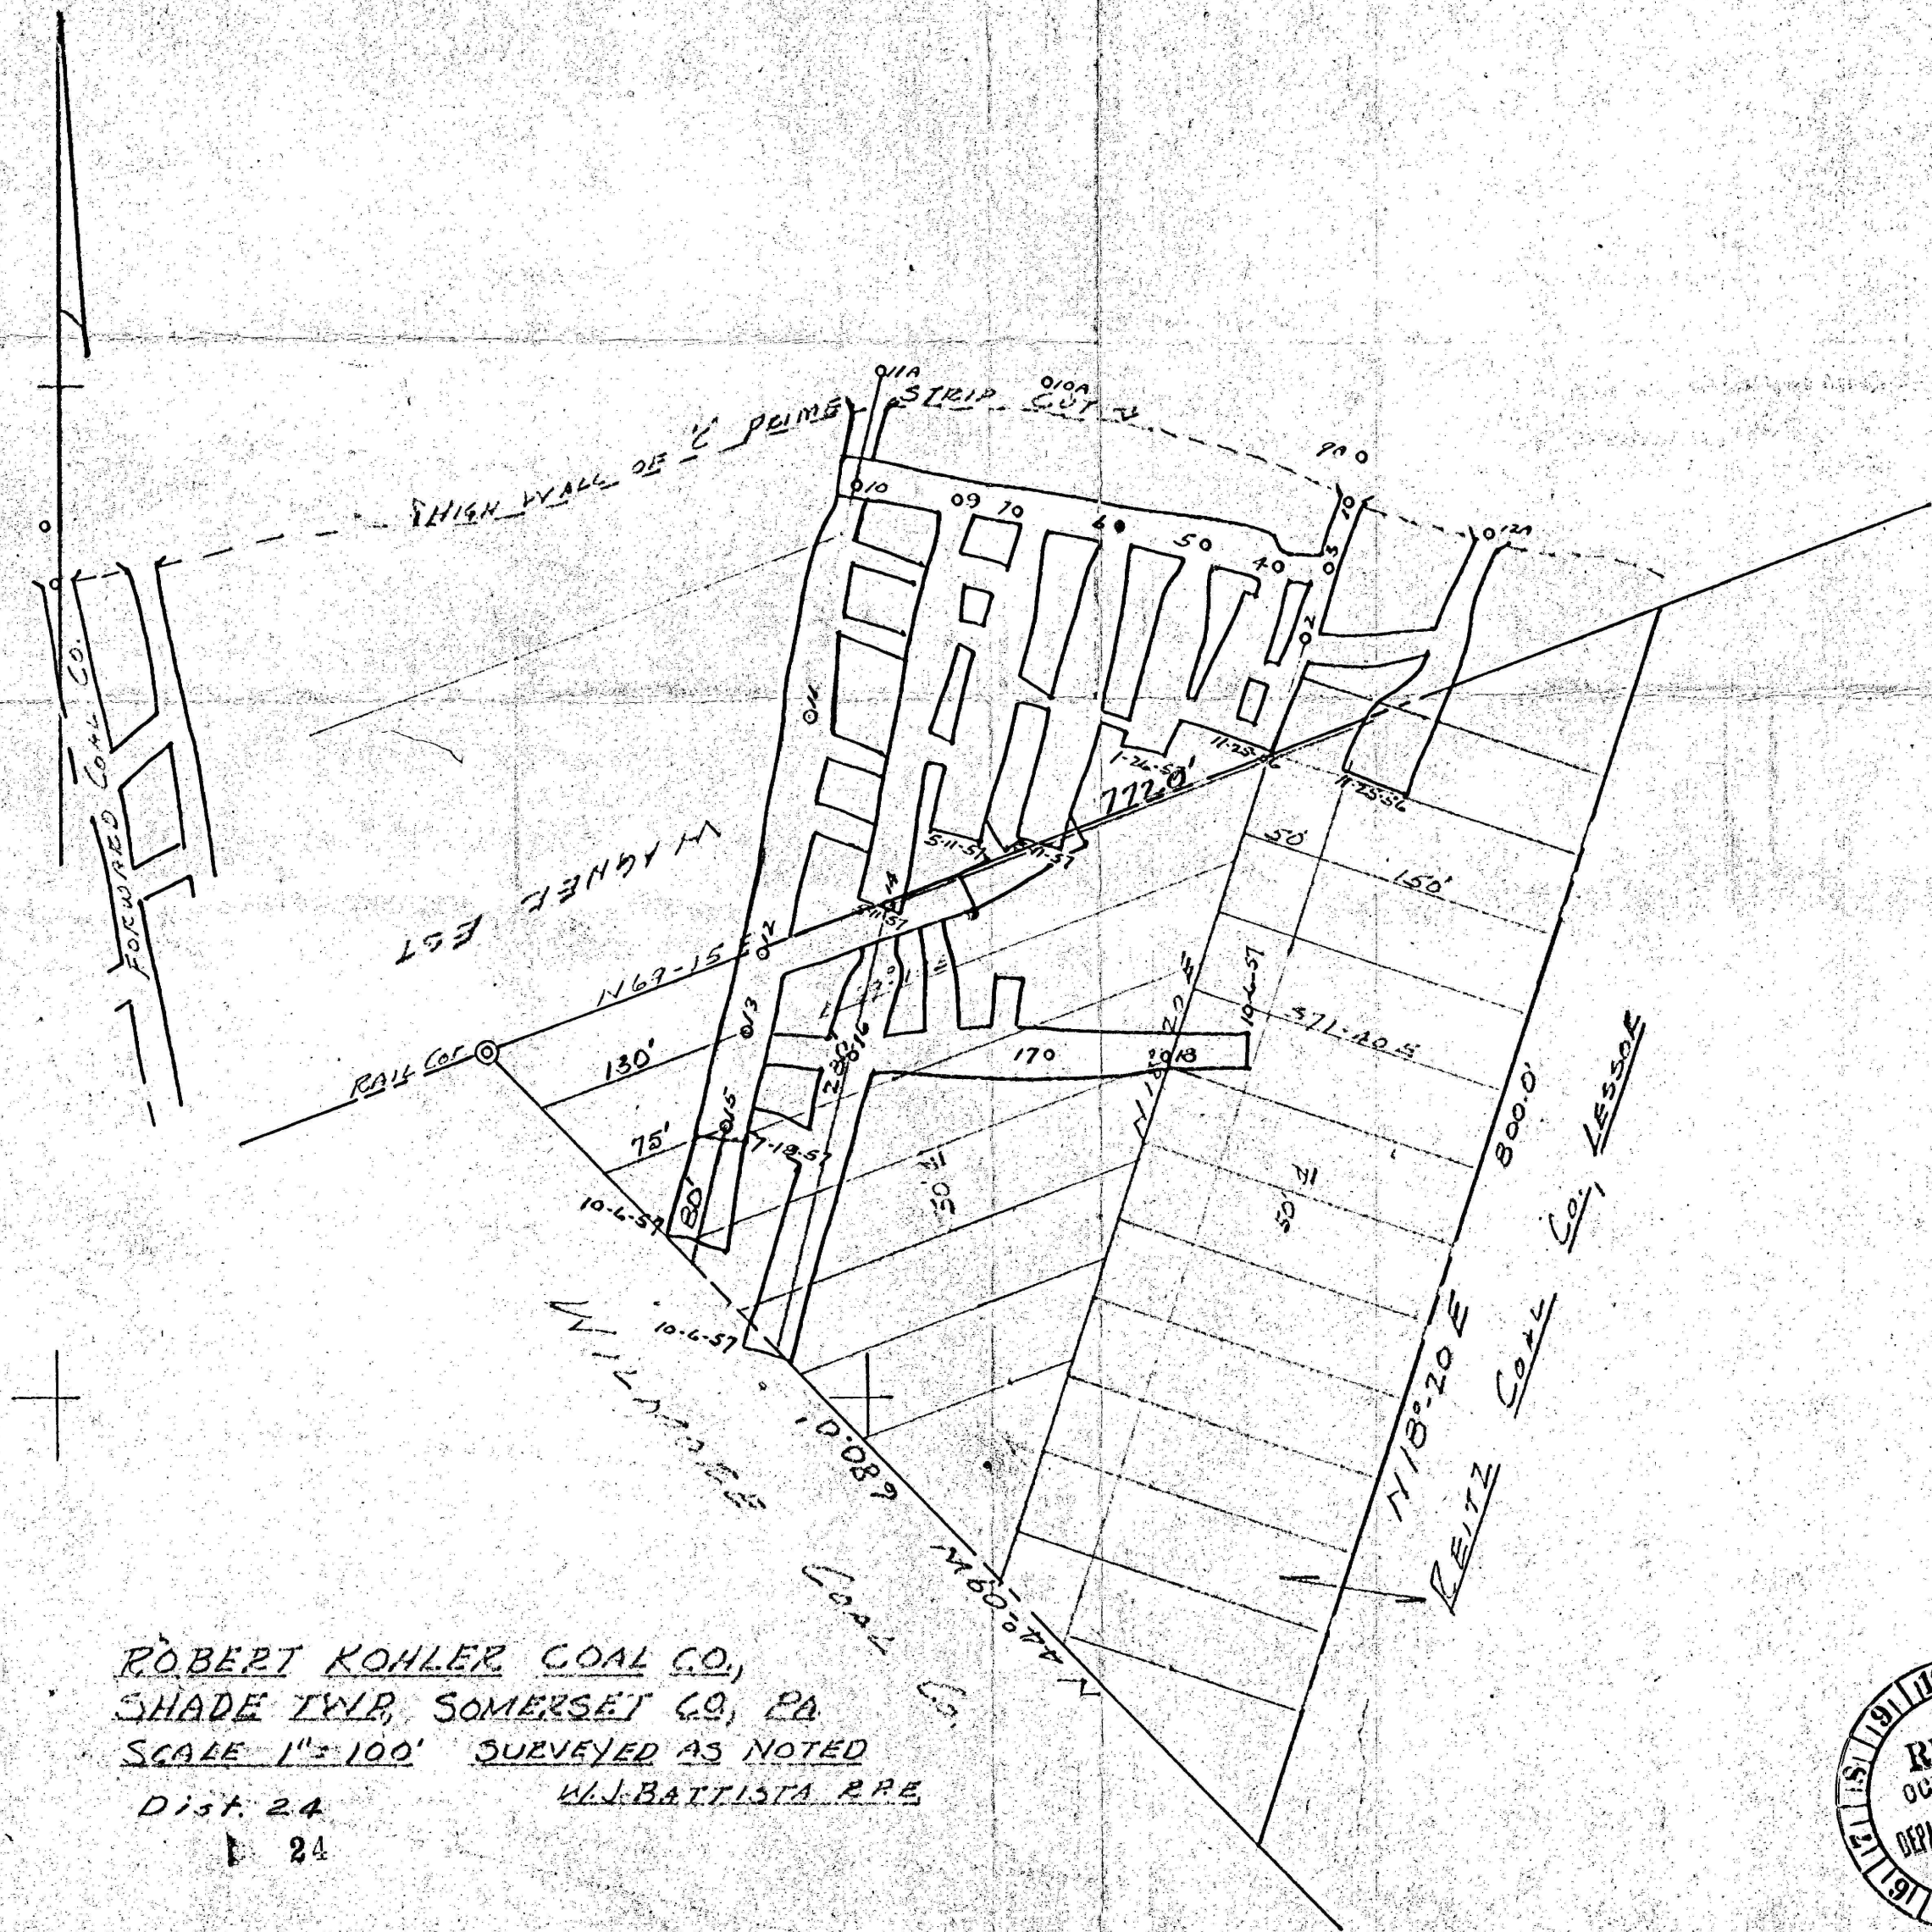