

SOMERSET COUNTY AIRPORT PROPERTY

TO RTE. 53

CHRIST HERNLEY

THIS AREA MINED BY STAUFFER-QUEMAHONING COAL CO.
Before 1928

OLIN E. HETRICK

#4 MINE

L.R. # 55135

HETRICK MINE
PRESENT OPERATION

APPROX. OUTCROP
UPPER FREEPORT SEAM


DEEP MINE SAFETY 100
0 25 50 100 150 200 Feet

TO LISTIE

L.R. # 55057

T 5523

TO WELLS CREEK

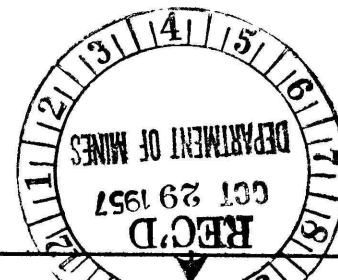

THE NEILAN ENGINEERS, SOMERSET, PENNA.		
Map of Mine Workings 20		
OLIN E. HETRICK		
Somerset Twp., Somerset Co., Pa.		
SURVEY	PLAN D.R.M.	CHECK J.H.N.
DATE 10/21/57	APPROVED	
SCALE 1" = 100'	N.B.	FILE 571021