


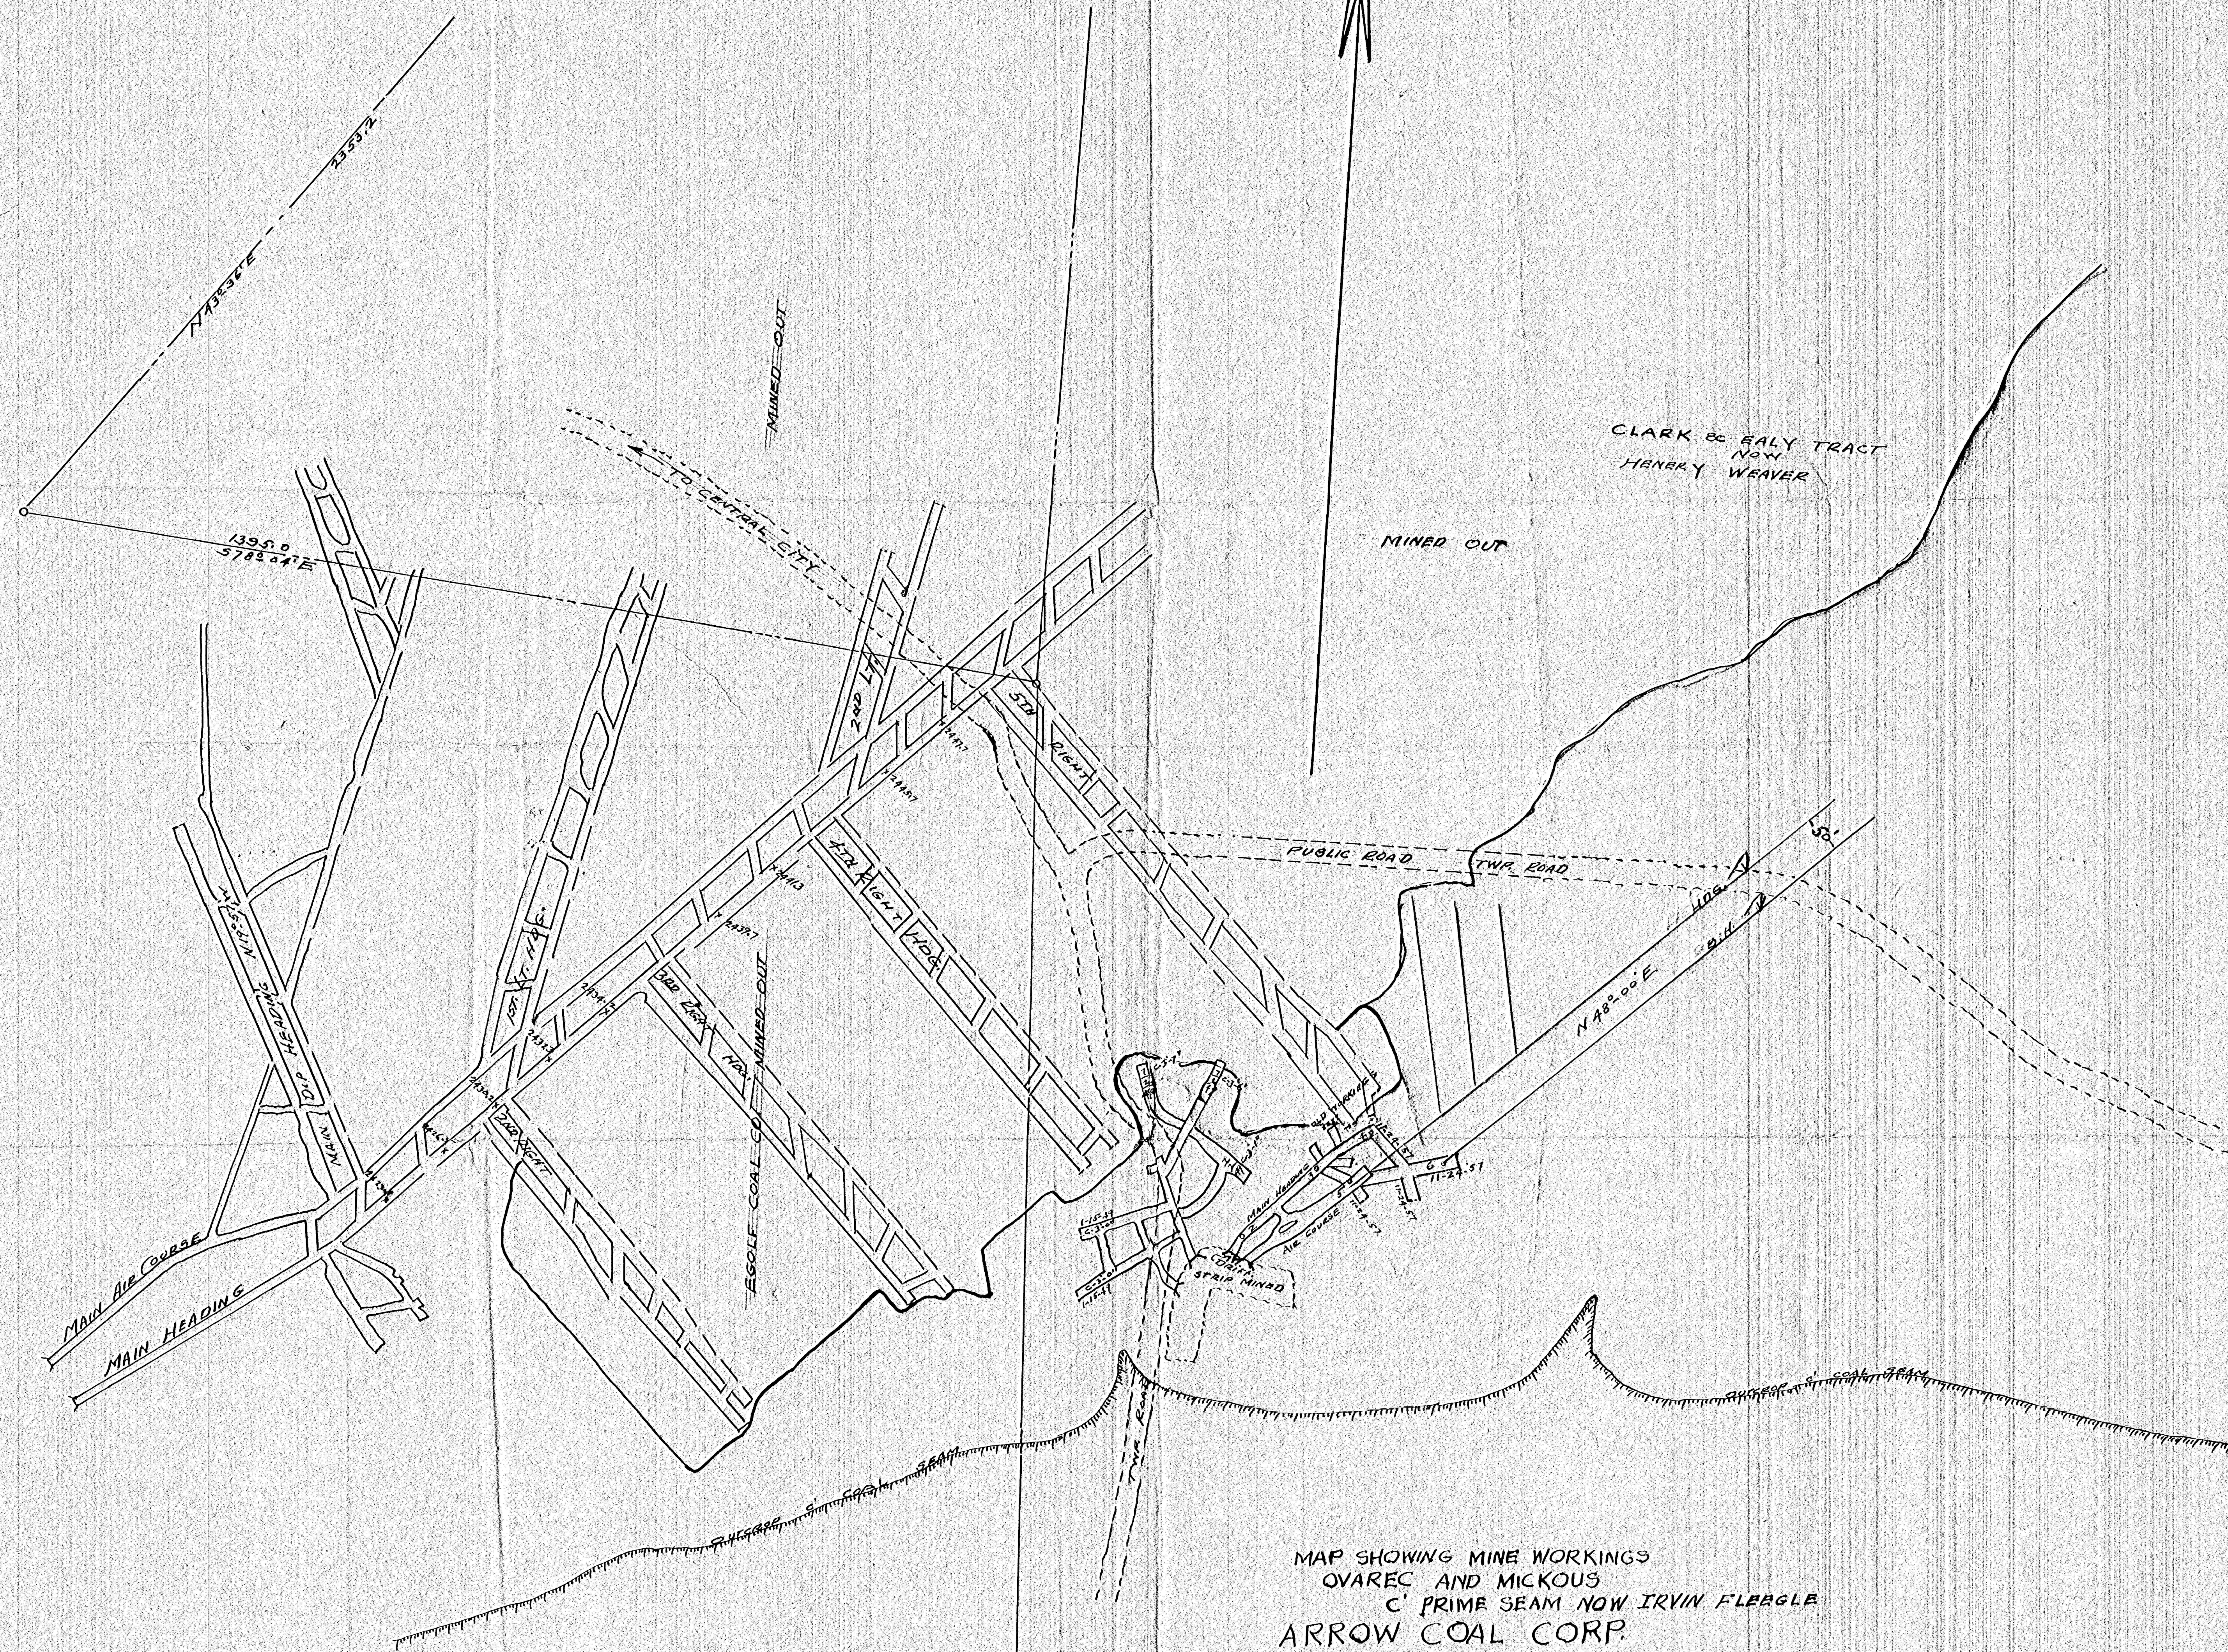

MAP SHOWING MINE WORKINGS
OVAREC AND MICKOUS
C' PRIME SEAM NOW IRVIN FLEAGLE
ARROW COAL CORP.
SHADE TWP., SOMERSET CO. PENNA.
SCALE 1"=100' DEC. 8 1947
REVISED AND PLOTTED NOV. 27, 1957.