


Miller Coal Co
Miller
1958 Annual

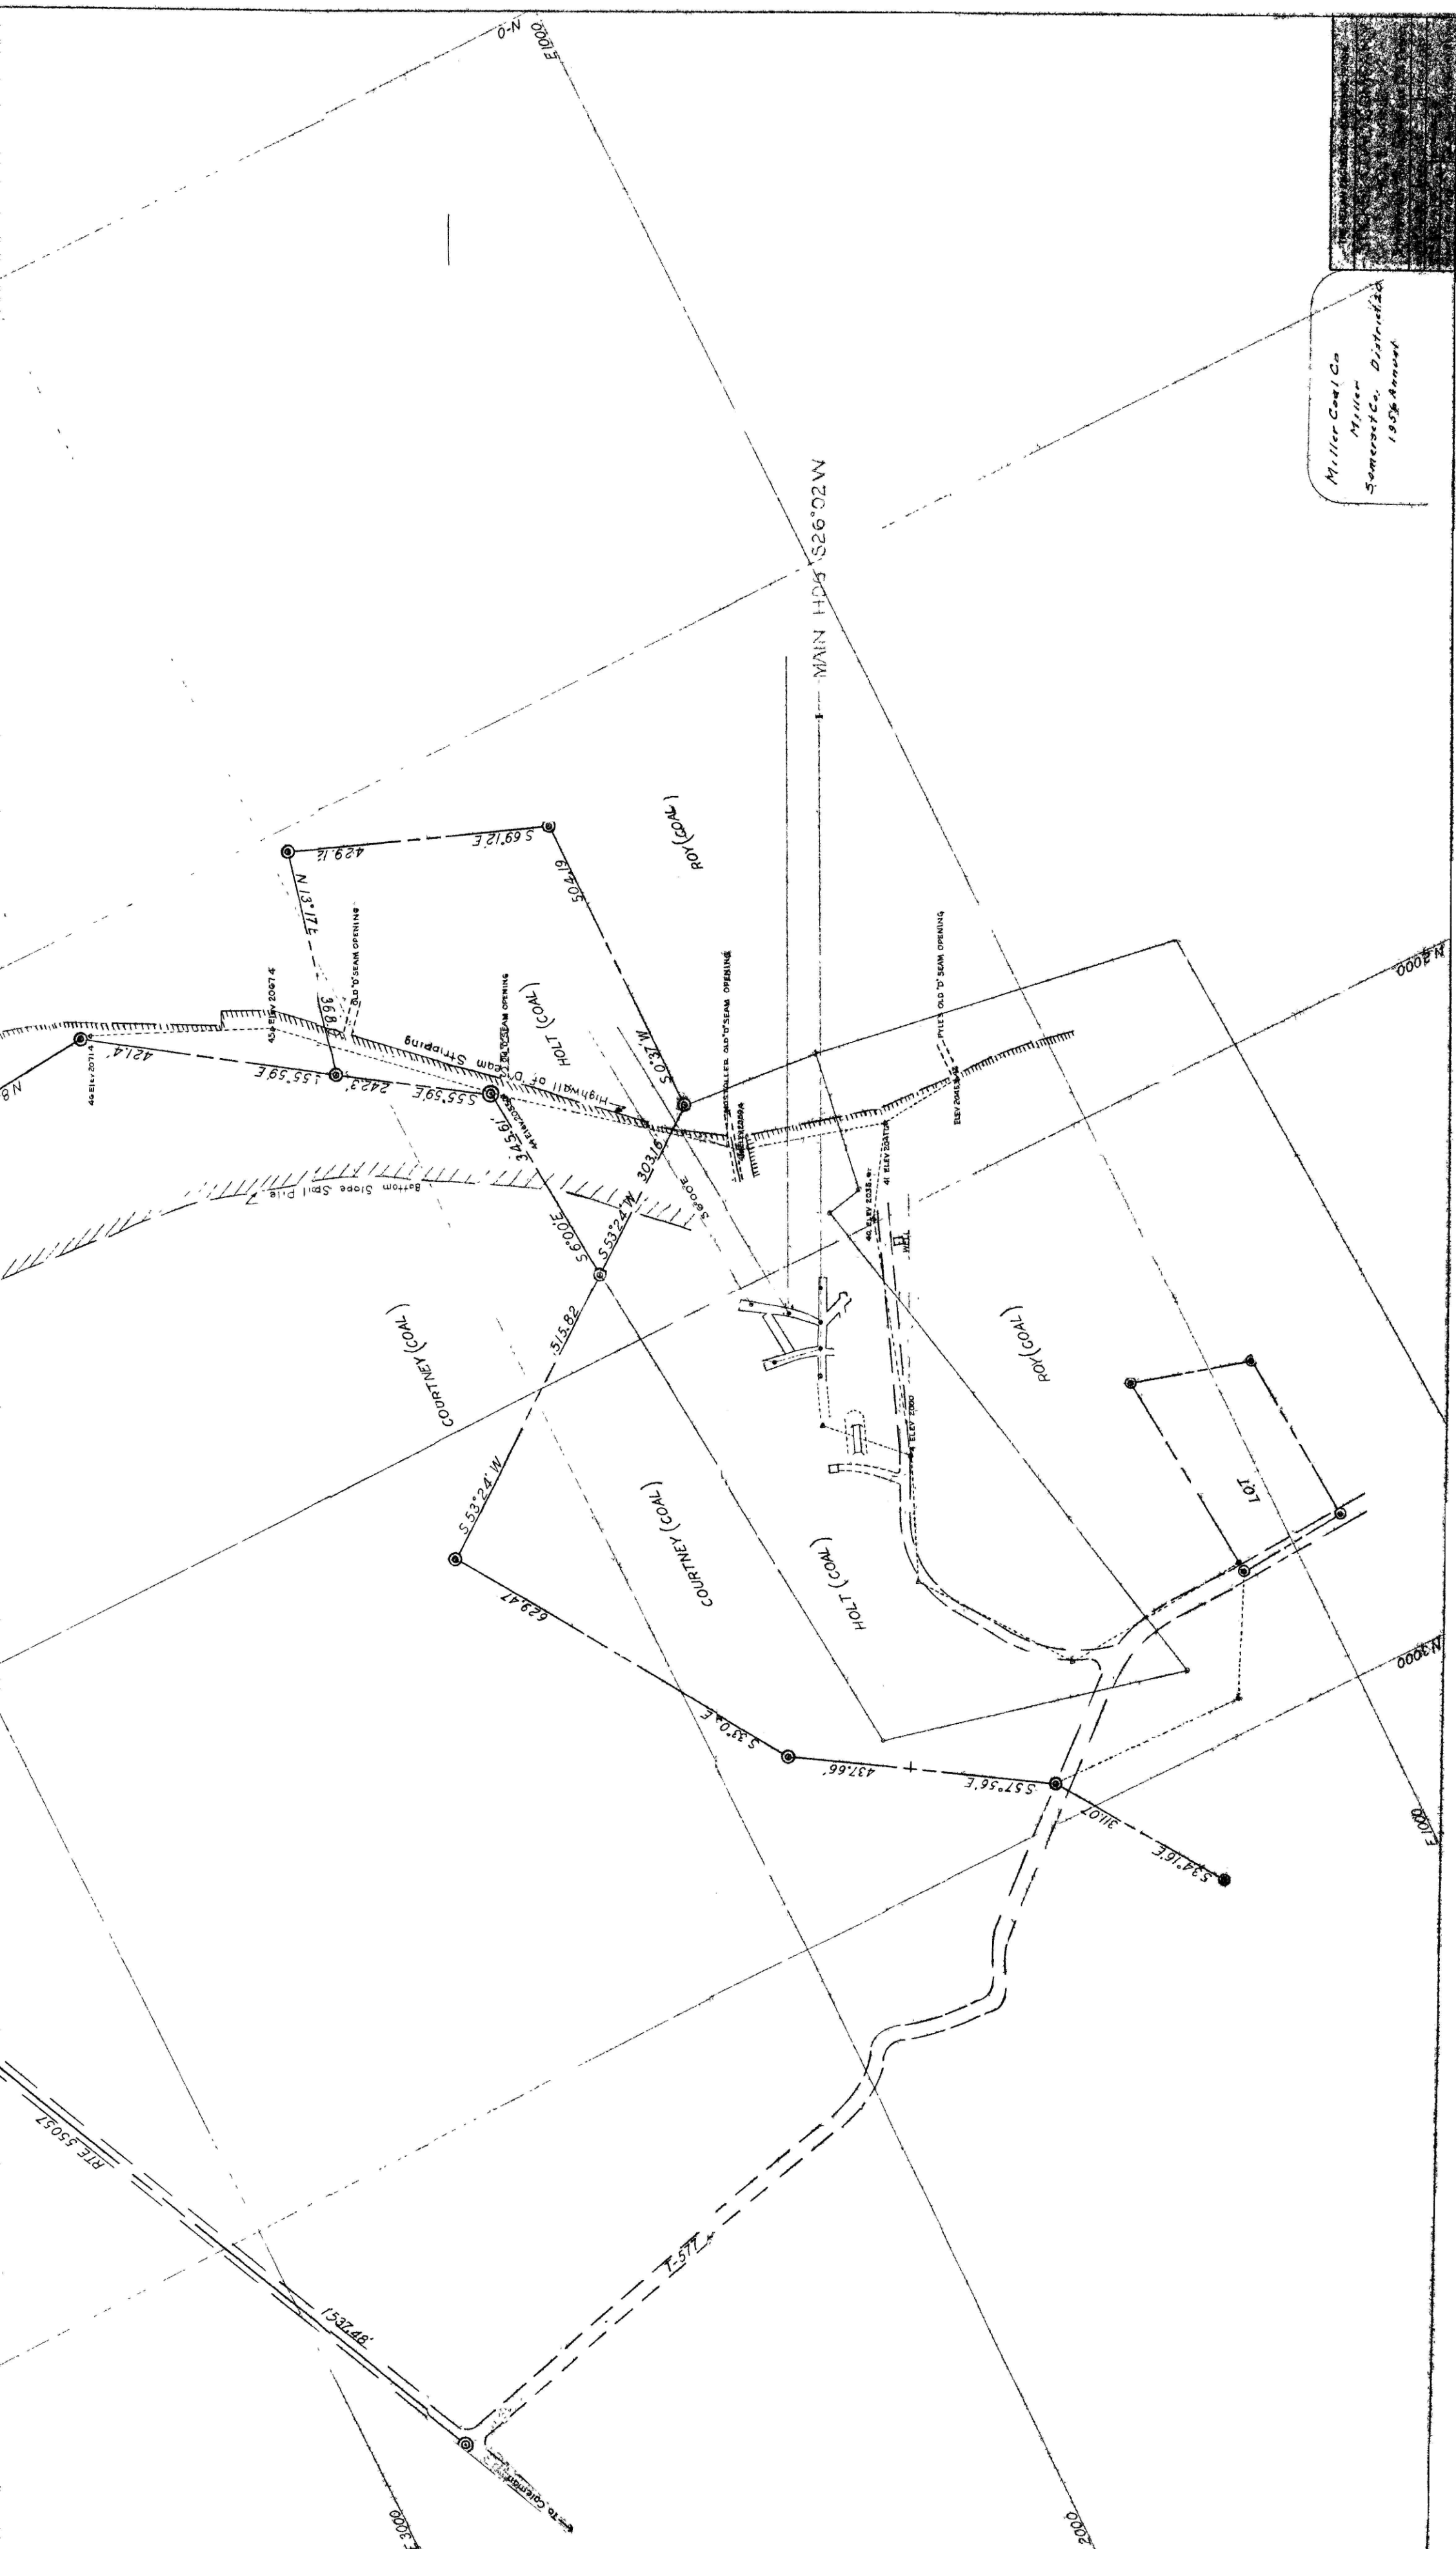

MAIN HIGHWAY S26°02'W

ROY (COAL)

HOLT (COAL)

COURTNEY (COAL)

COURTNEY (COAL)

HOLT (COAL)

ROY (COAL)

LOT

RTE 55057

1537.48'

to Co. 1000'

E 2000'

N 3000'

N 4000'

N-0
E 0000