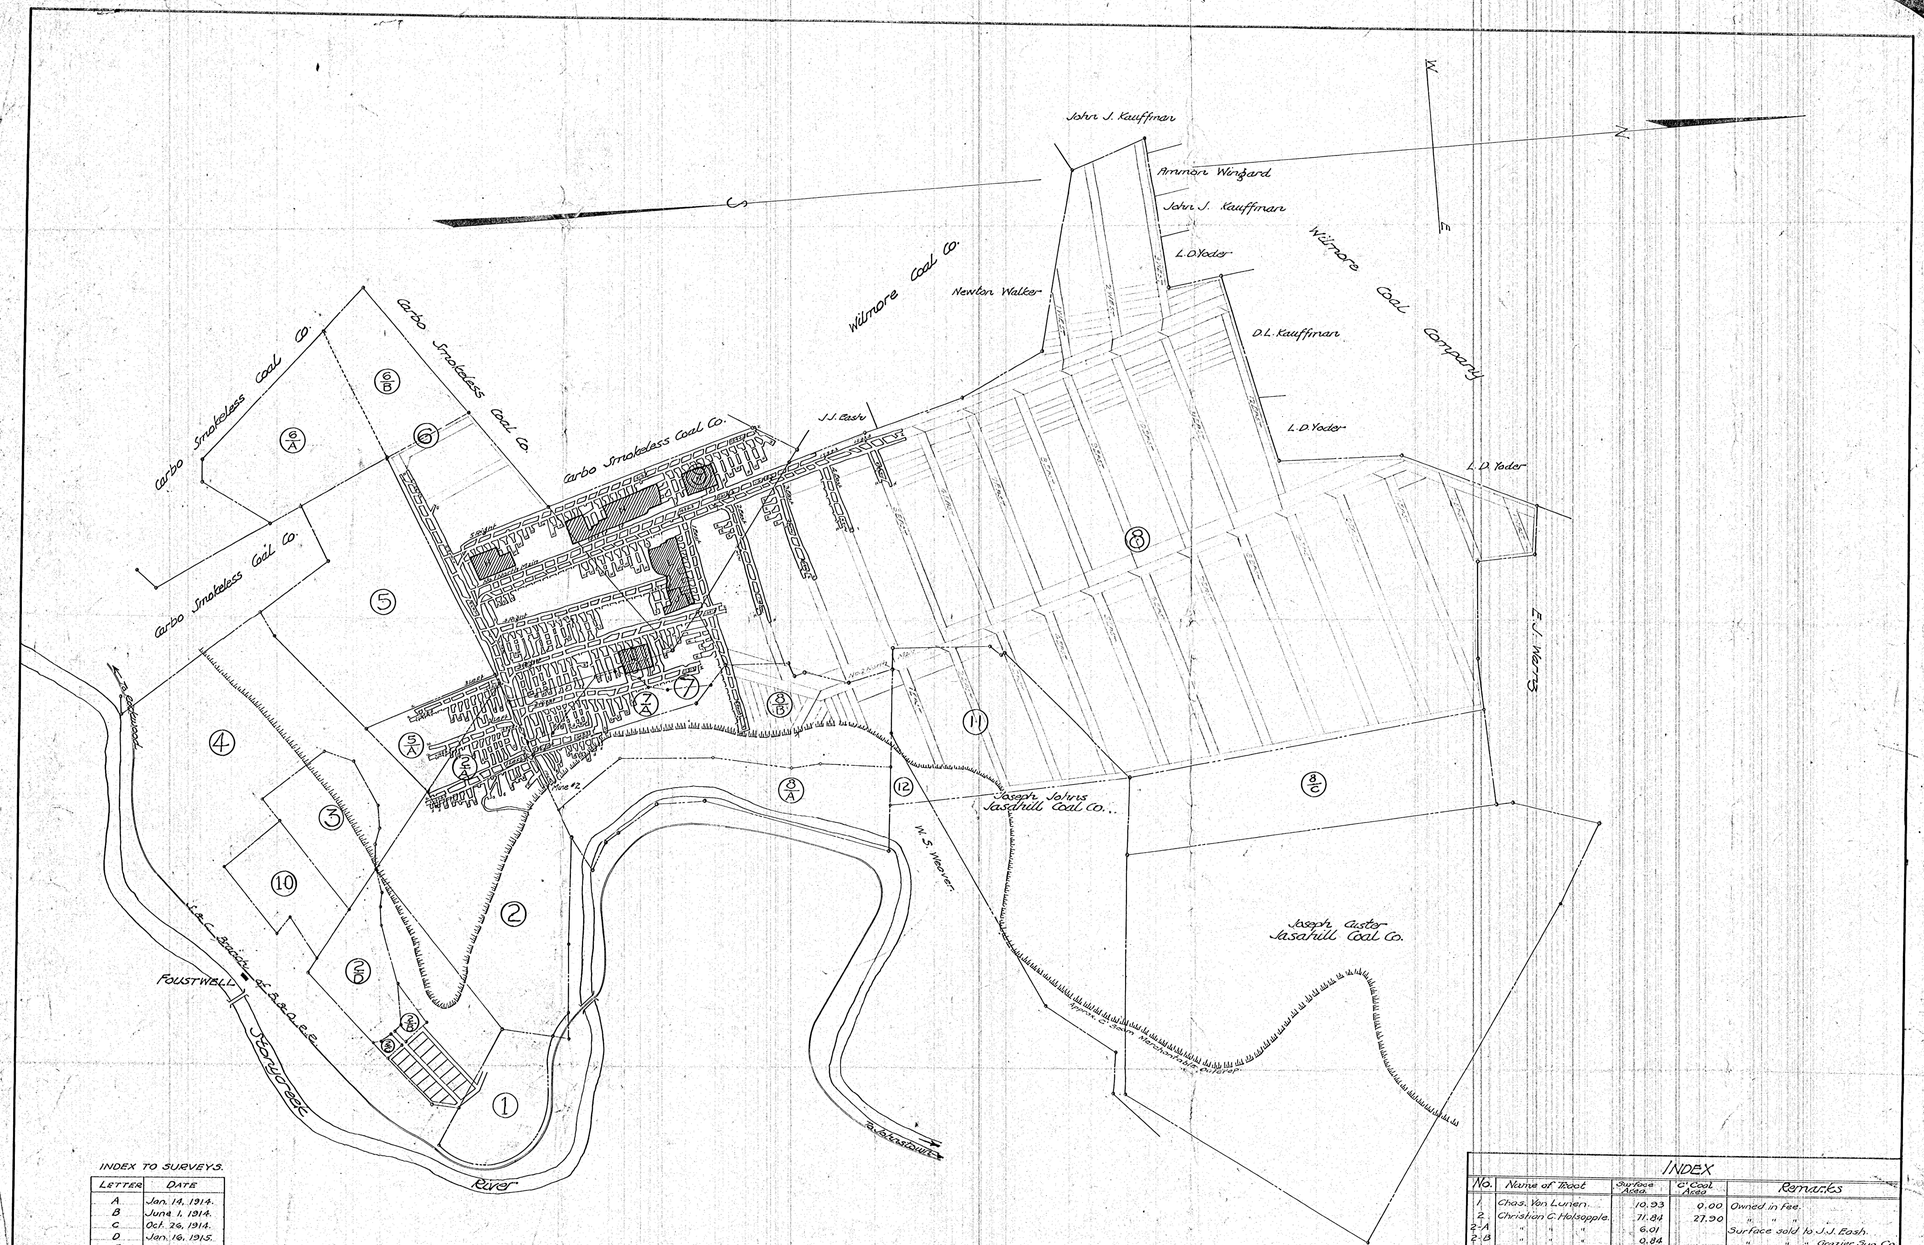

INDEX TO SURVEYS.

LETTER	DATE
A	Jan. 14, 1914.
B	June 1, 1914.
C	Oct. 26, 1914.
D	Jan. 16, 1915.
E	June 5, 1915.
F	Jan. 18, 1916.
G	Aug. 2, 1916.
H	Feb. 13, 1917.
I	Aug. 23, 1917.
J	Feb. 8, 1918.
K	Aug. 13, 1918.
L	Jan. 14, 1919.
M	July 2, 1919.
N	Jan. 14, 1920.

GRAZIER COAL MINING CO.

Showing

"C" PRIME SEAM MINING OPERATIONS

Situate at Foustwell, Conemaugh Twp, Somerset Co. Pa.

Scale 1"=400' — S.E. Dickey & Company — July 27, 1918.

Civil and Mining Engineers

Johnstown, — Penna.

INDEX

No.	Name of Tract	Surface Acres	"C" Coal Acres	Remarks
1.	Chas. Van Lurien.	10.93	0.00	Owned in Fee.
2.	Christian C. Holsopple.	71.84	27.90	" " "
2-A	" " "	6.01		Surface sold to J.J. Eash.
2-B	" " "	0.84		" " " Grazier Sup. Co.
2-C	" " "	0.33		" " "
2-D	" " "	9.25		Surface and "C" coal reserved by Christian C. Holsopple.
3	Chas. Livingston.	1.00	3.60	On Royalty. No Minimum.
4	David Livingston.	83.00	16.00	" " " "
5	Josiah Myers.	41.42		All "C" Coal Royalty except B Coal owned by heirs of the late Lara C. reserved in 8-A.
5-A	" "	4.60	4.60	"C" Coal by Eee with Carbo Smoke. C. Co.
6	Christina Eash.	73.64	40.84	All coal, except Top Vein 18" thick.
6-A	" "	20.06		B & "C" traded to Carbo Smoke. C. Co.
6-B	" "	12.74		"C" traded to Black Diamond Coal Co. " " "
7	Annie Eash.	13.81	13.81	B and "C" Coal owned by Annie Eash. "C" Coal reserved by heirs of "C" Coal around buildings.
7-A	" "	6.01		Surface purchased from Annie Eash
8	Jacob C. Eash.	357.48	291.06	All coal Except B-C.
8-A	" " "	21.60		In Fee.
8-B	" " "	26.26		" " "
9	Sarah Thomas.	28.20	28.20	"C" Coal by exch. from Carbo S. C. Co.
10	Jacob Livingston.	8.00		On Royalty. No Minimum.
8-C	Jacob C. Eash.	33.84	33.84	B & "C" Coal Traded To Jasahill C.M.Co.
11	Joseph Johns	26.28	24.05	B & "C" Coal From Jasahill C.M.Co.
12	W.S. Weaver.	1.68	0.12	" " " " " " " " "

2-B-132