




Dist 22
 Plan showing Tract of Coal Land owned
 by James O. & Evelyn L. Miller and other
 Coal Mine Properties leased from Pitts-
 burgh Consolidation Coal Co., Part of the
 Banner Mine Cross Hatched Mined out.
 situate
 Union Twp., Washington Co., Penna.
 Scale 1" = 100' Sept 14, 1957
 Alex. L. McVicker, Reg. Prof. Engr. No. 825.
 R. Hanna, Del.

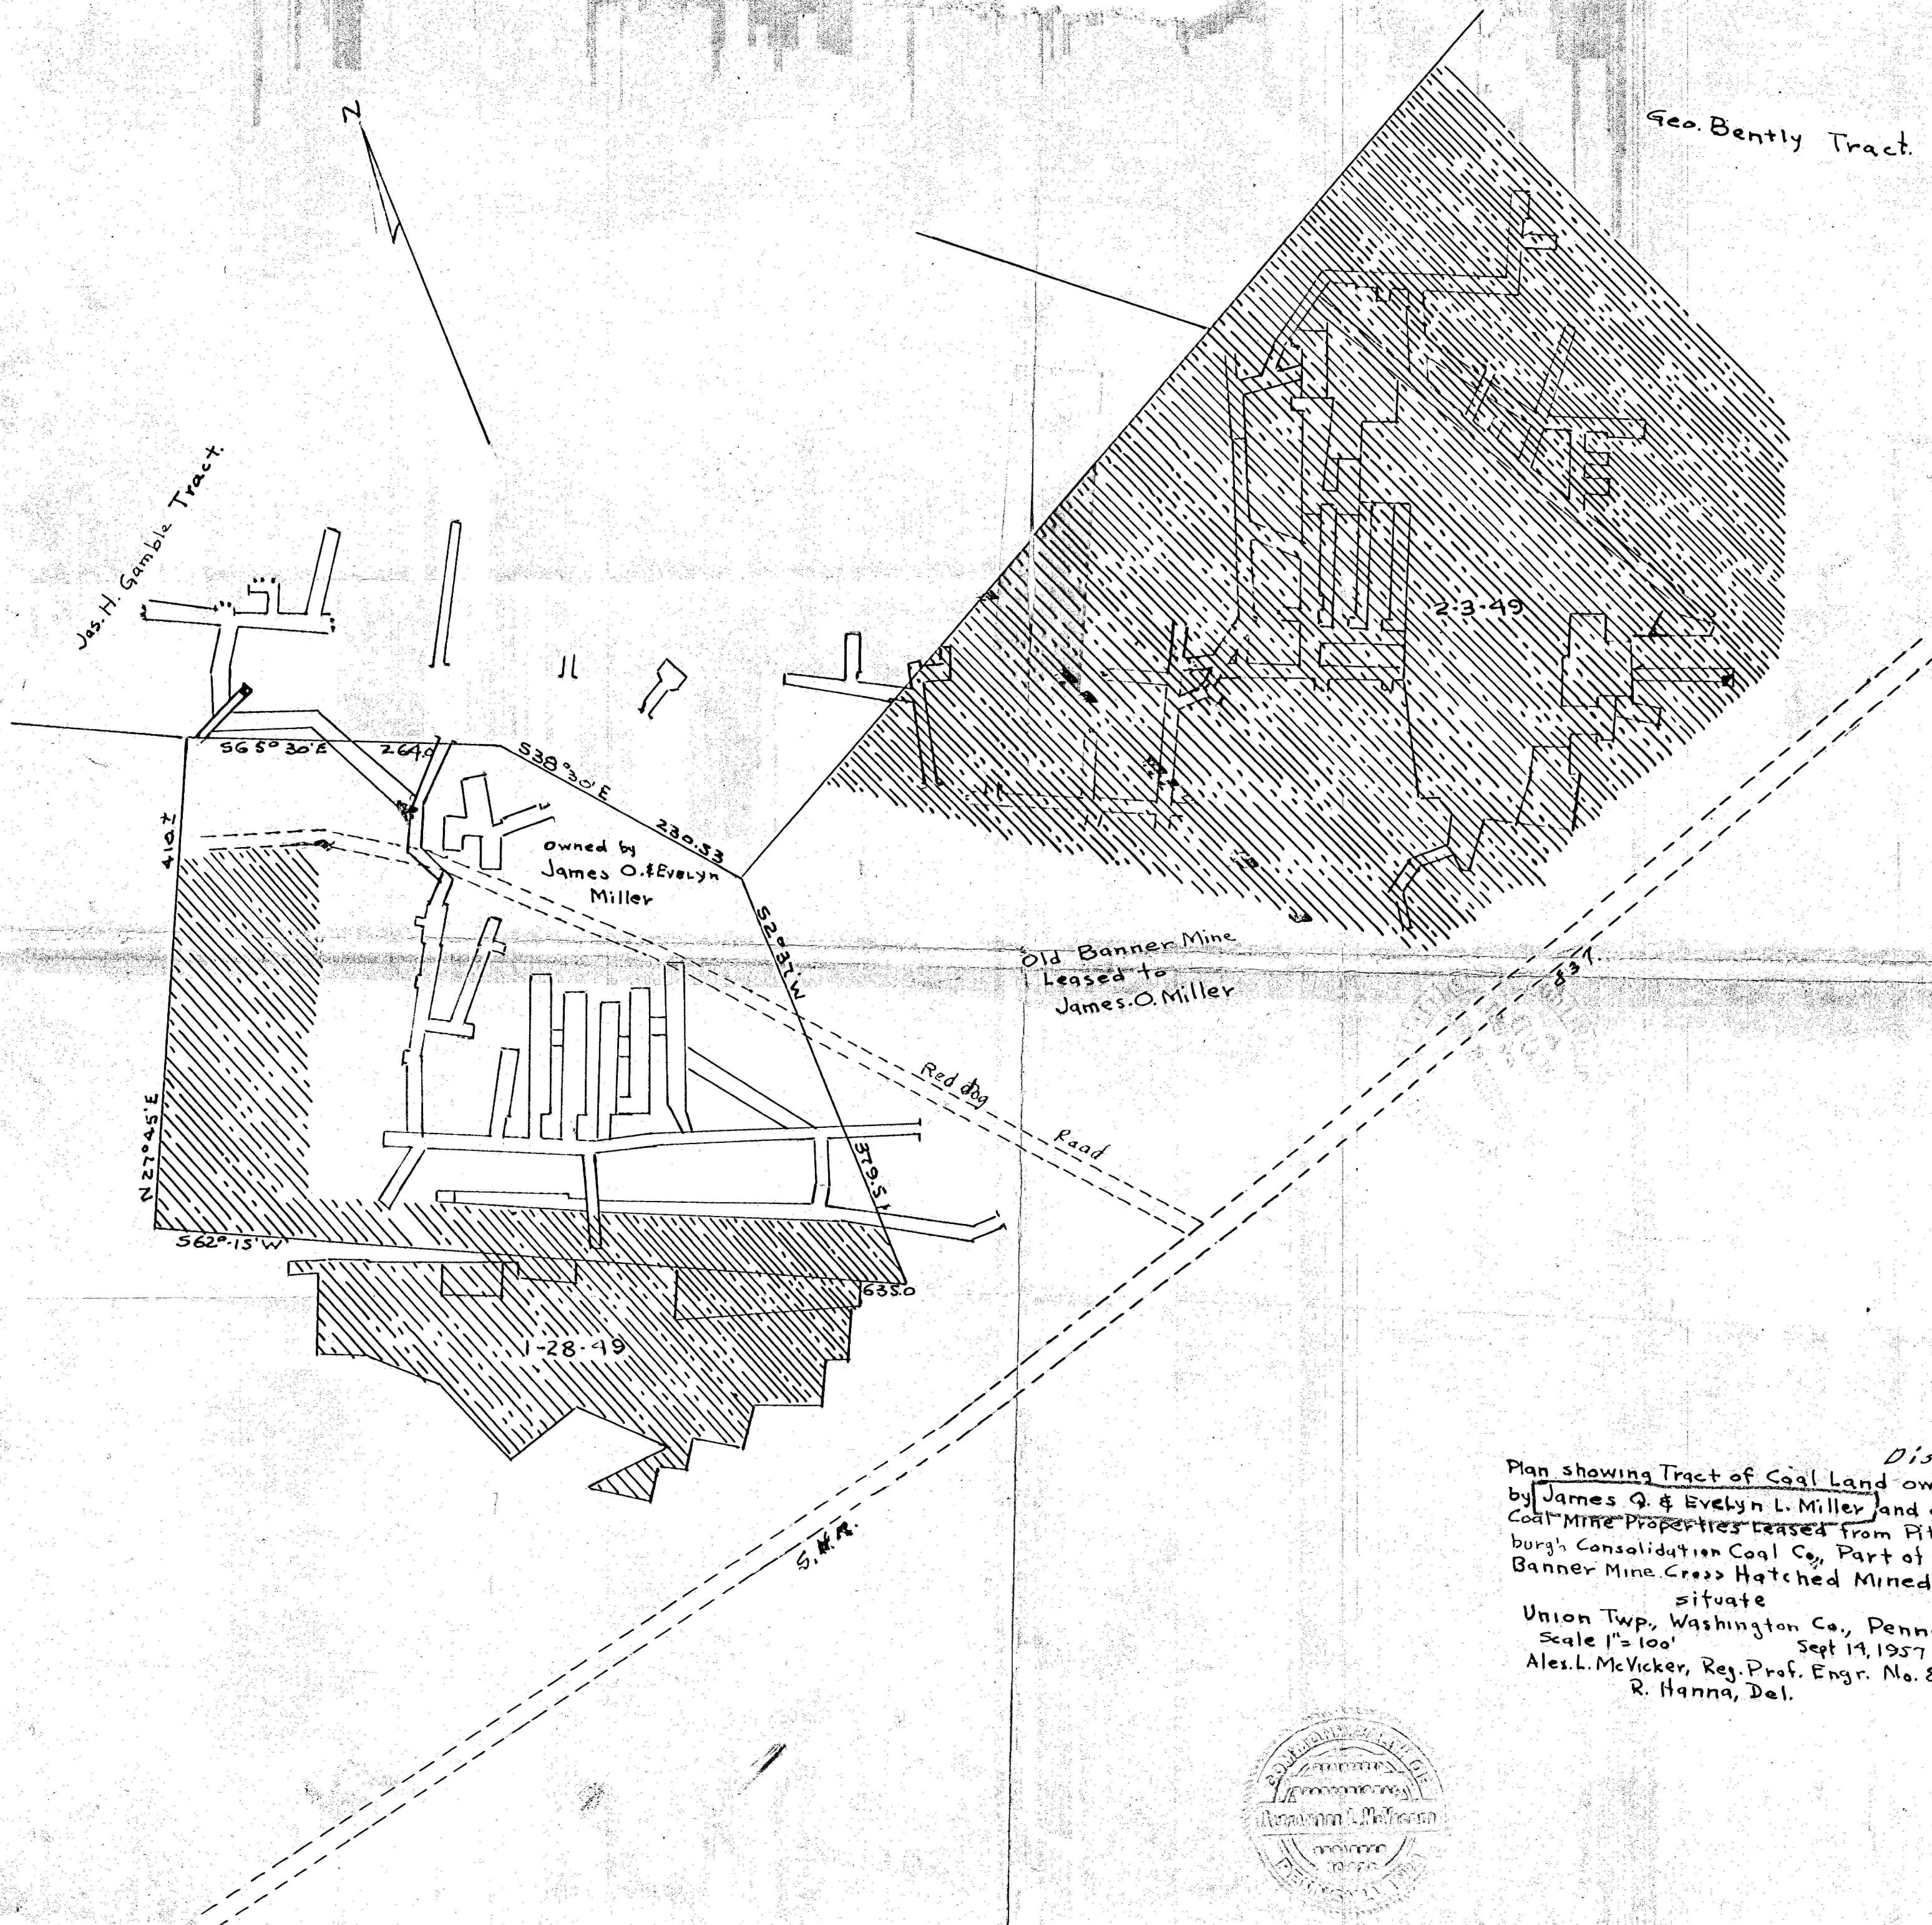