


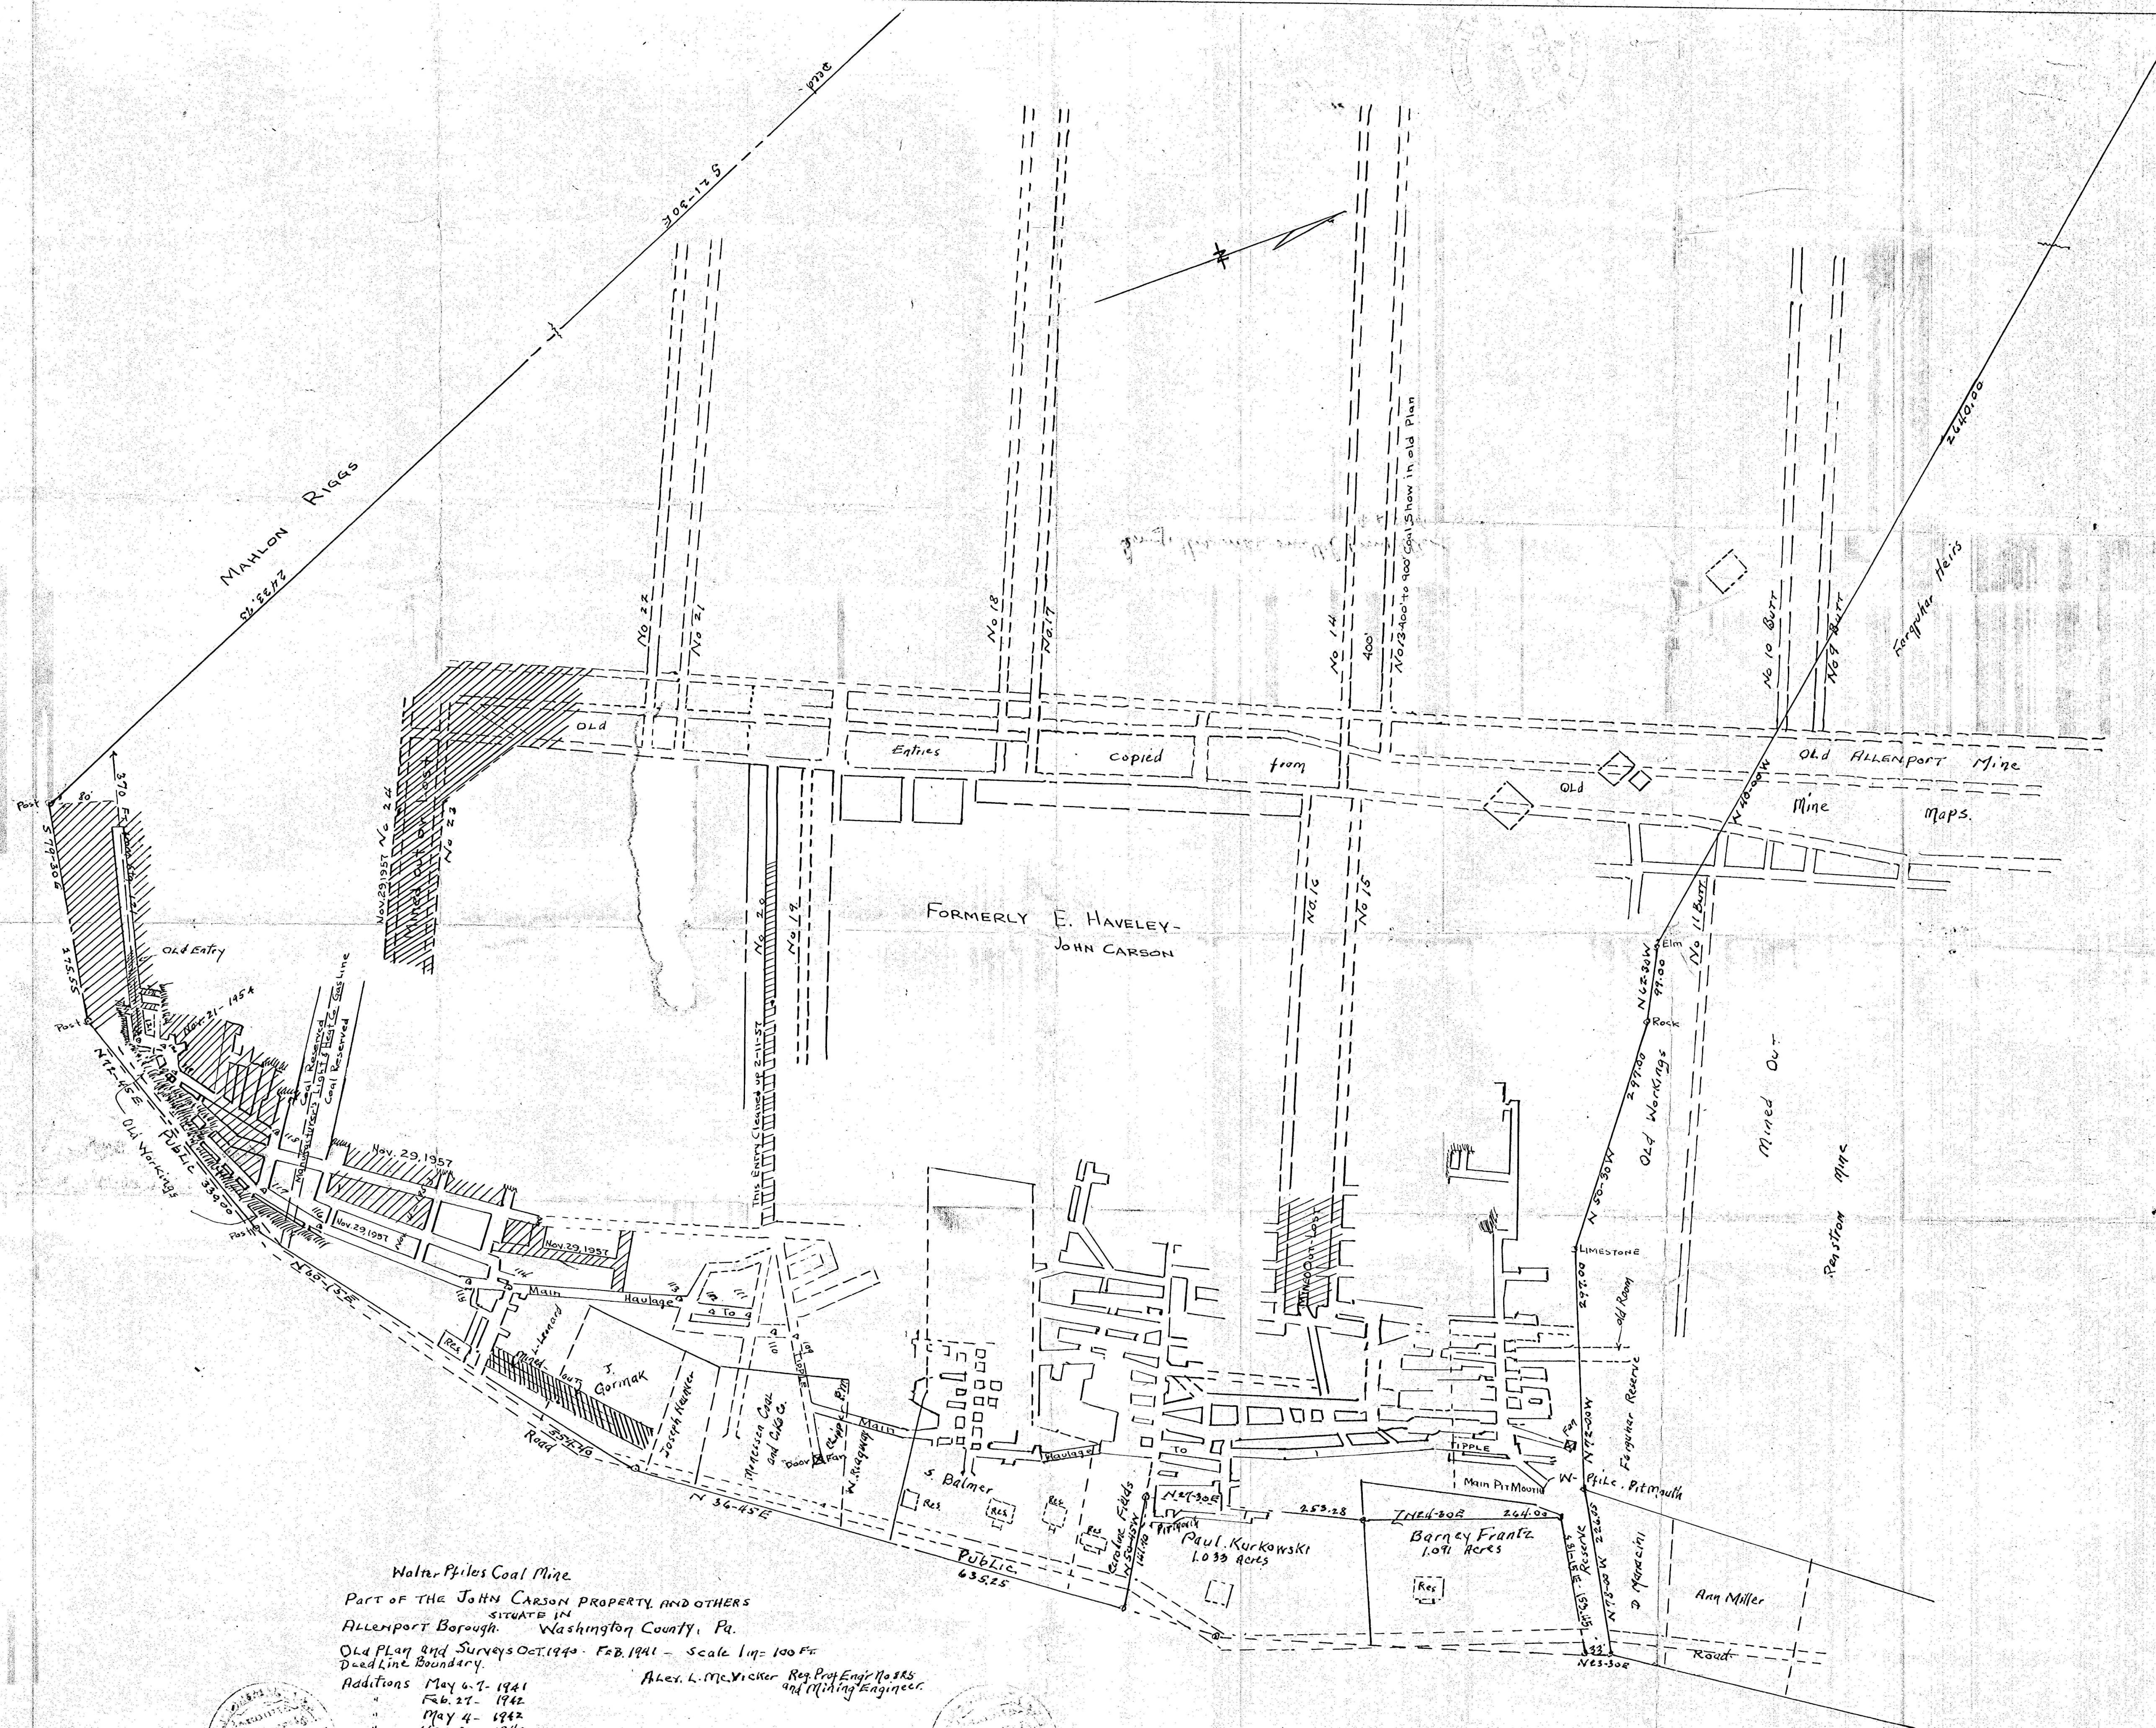

Walter Piles Coal Mine
 PART OF THE JOHN CARSON PROPERTY AND OTHERS
 SITUATED IN
 ALLENPORT BOROUGH, WASHINGTON COUNTY, PA.
 OLD PLAN AND SURVEYS OCT. 1940 - FEB. 1941 - Scale 1 in. = 100 ft.
 DEED LINE BOUNDARY.
 Additions May 6-7-1941 Alex. L. McVicker Reg. Prof. Engr. No. 885
 " Feb. 27-1942 and Mining Engineer.
 " May 4-1942
 " Nov. 21-1942
 " Jan. 17-1948
 " Nov. 3-1951
 " Jan. 21-1953
 " 10-7-67-8-494 11th 1959 - New Tracing and Map.
 " 4 Alterations Nov. 23, 1957 Showing Mine Workings as they now are.
 Attempt to being Made to get back to old Main Entry,
 Stumps & Pillars.
 Alex. L. McVicker, Prof. Civil & Mining Engr.
 R. Hanna, Del.