

HARMON COAL CO.

HARMON COAL CO.

N

HOWARD NEAL

LUCILLE STURGEON

KUNSEMAN

CECILENE UPPER
FITTING COAL

MAIN

NO. 1




























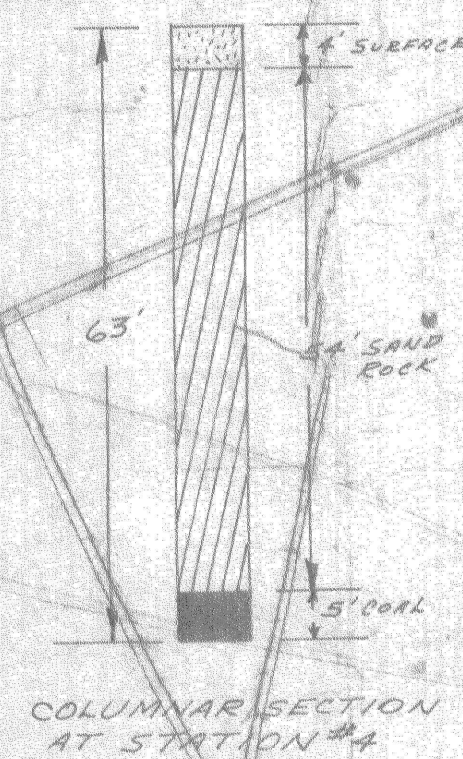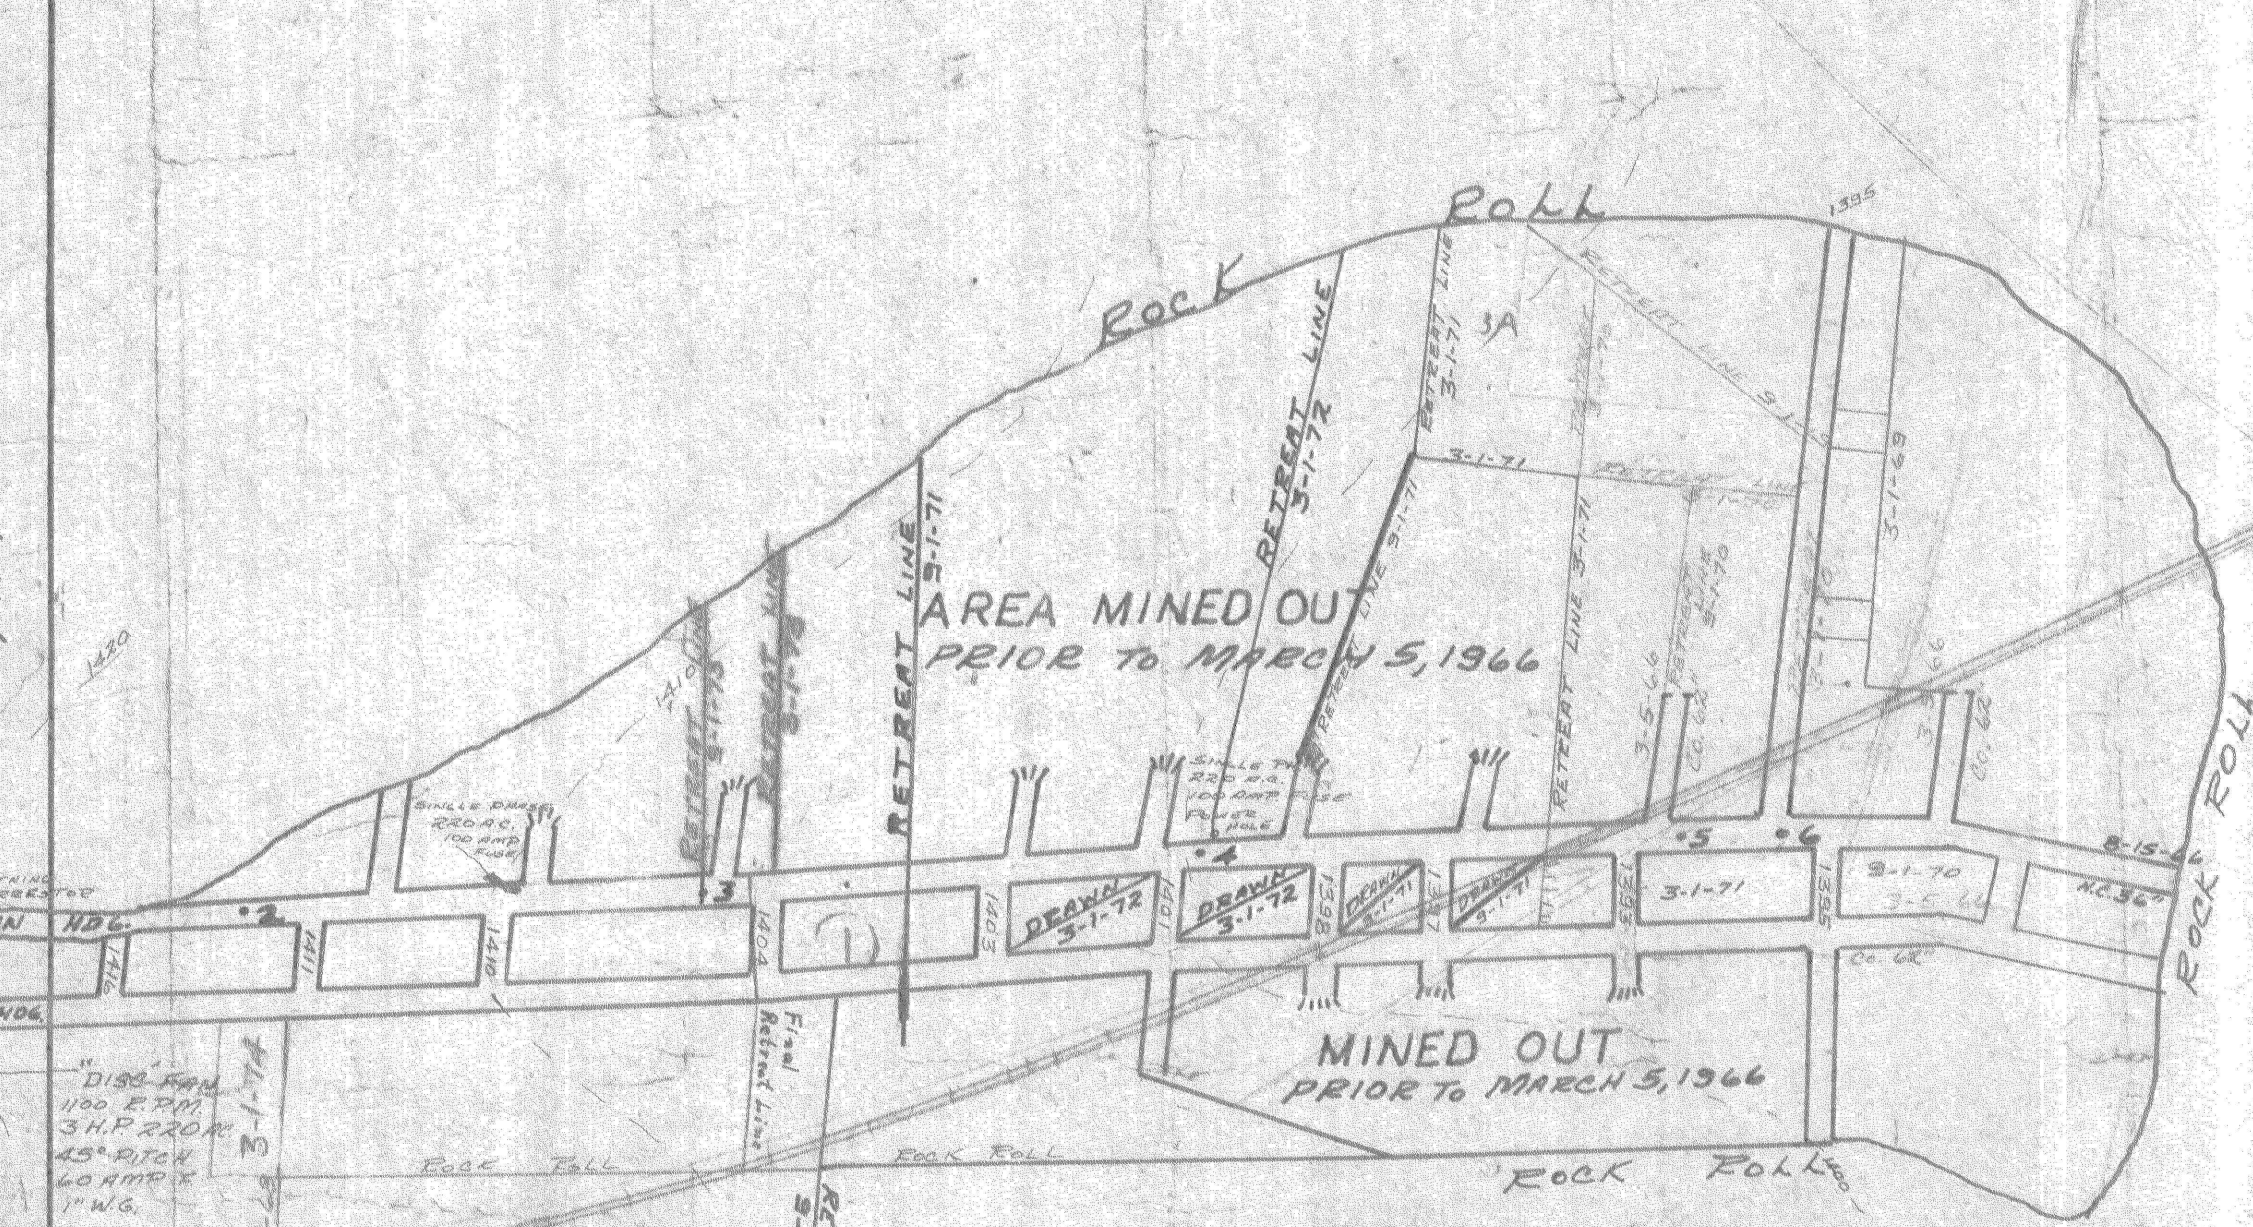

Mc GREGOR COAL CO.

This is to certify that this is
a true & correct copy to best of my
knowledge,
W. Irvin Bullers

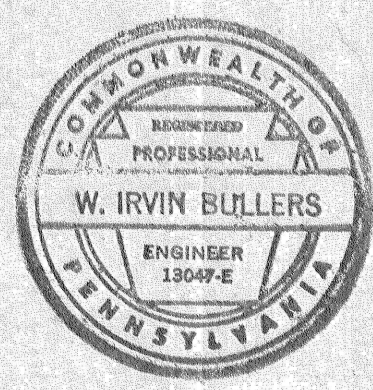

MINE MAP FOR
HAROLD E. BROCIUS
REDBANK TWP, ARMSTRONG CO.
PENNSYLVANIA
MARCH 5, 1966
REV. 10-8-66
6-22-73
9-15-75
3-11-76
10-8-76
12-1-79
Final Map 3-20-85

WILLIAM GETST

EMERSON REICHARD

#366
6-16-99
C.C.