


MEC
3/10/24

HARPER WHITELEY COAL CO.

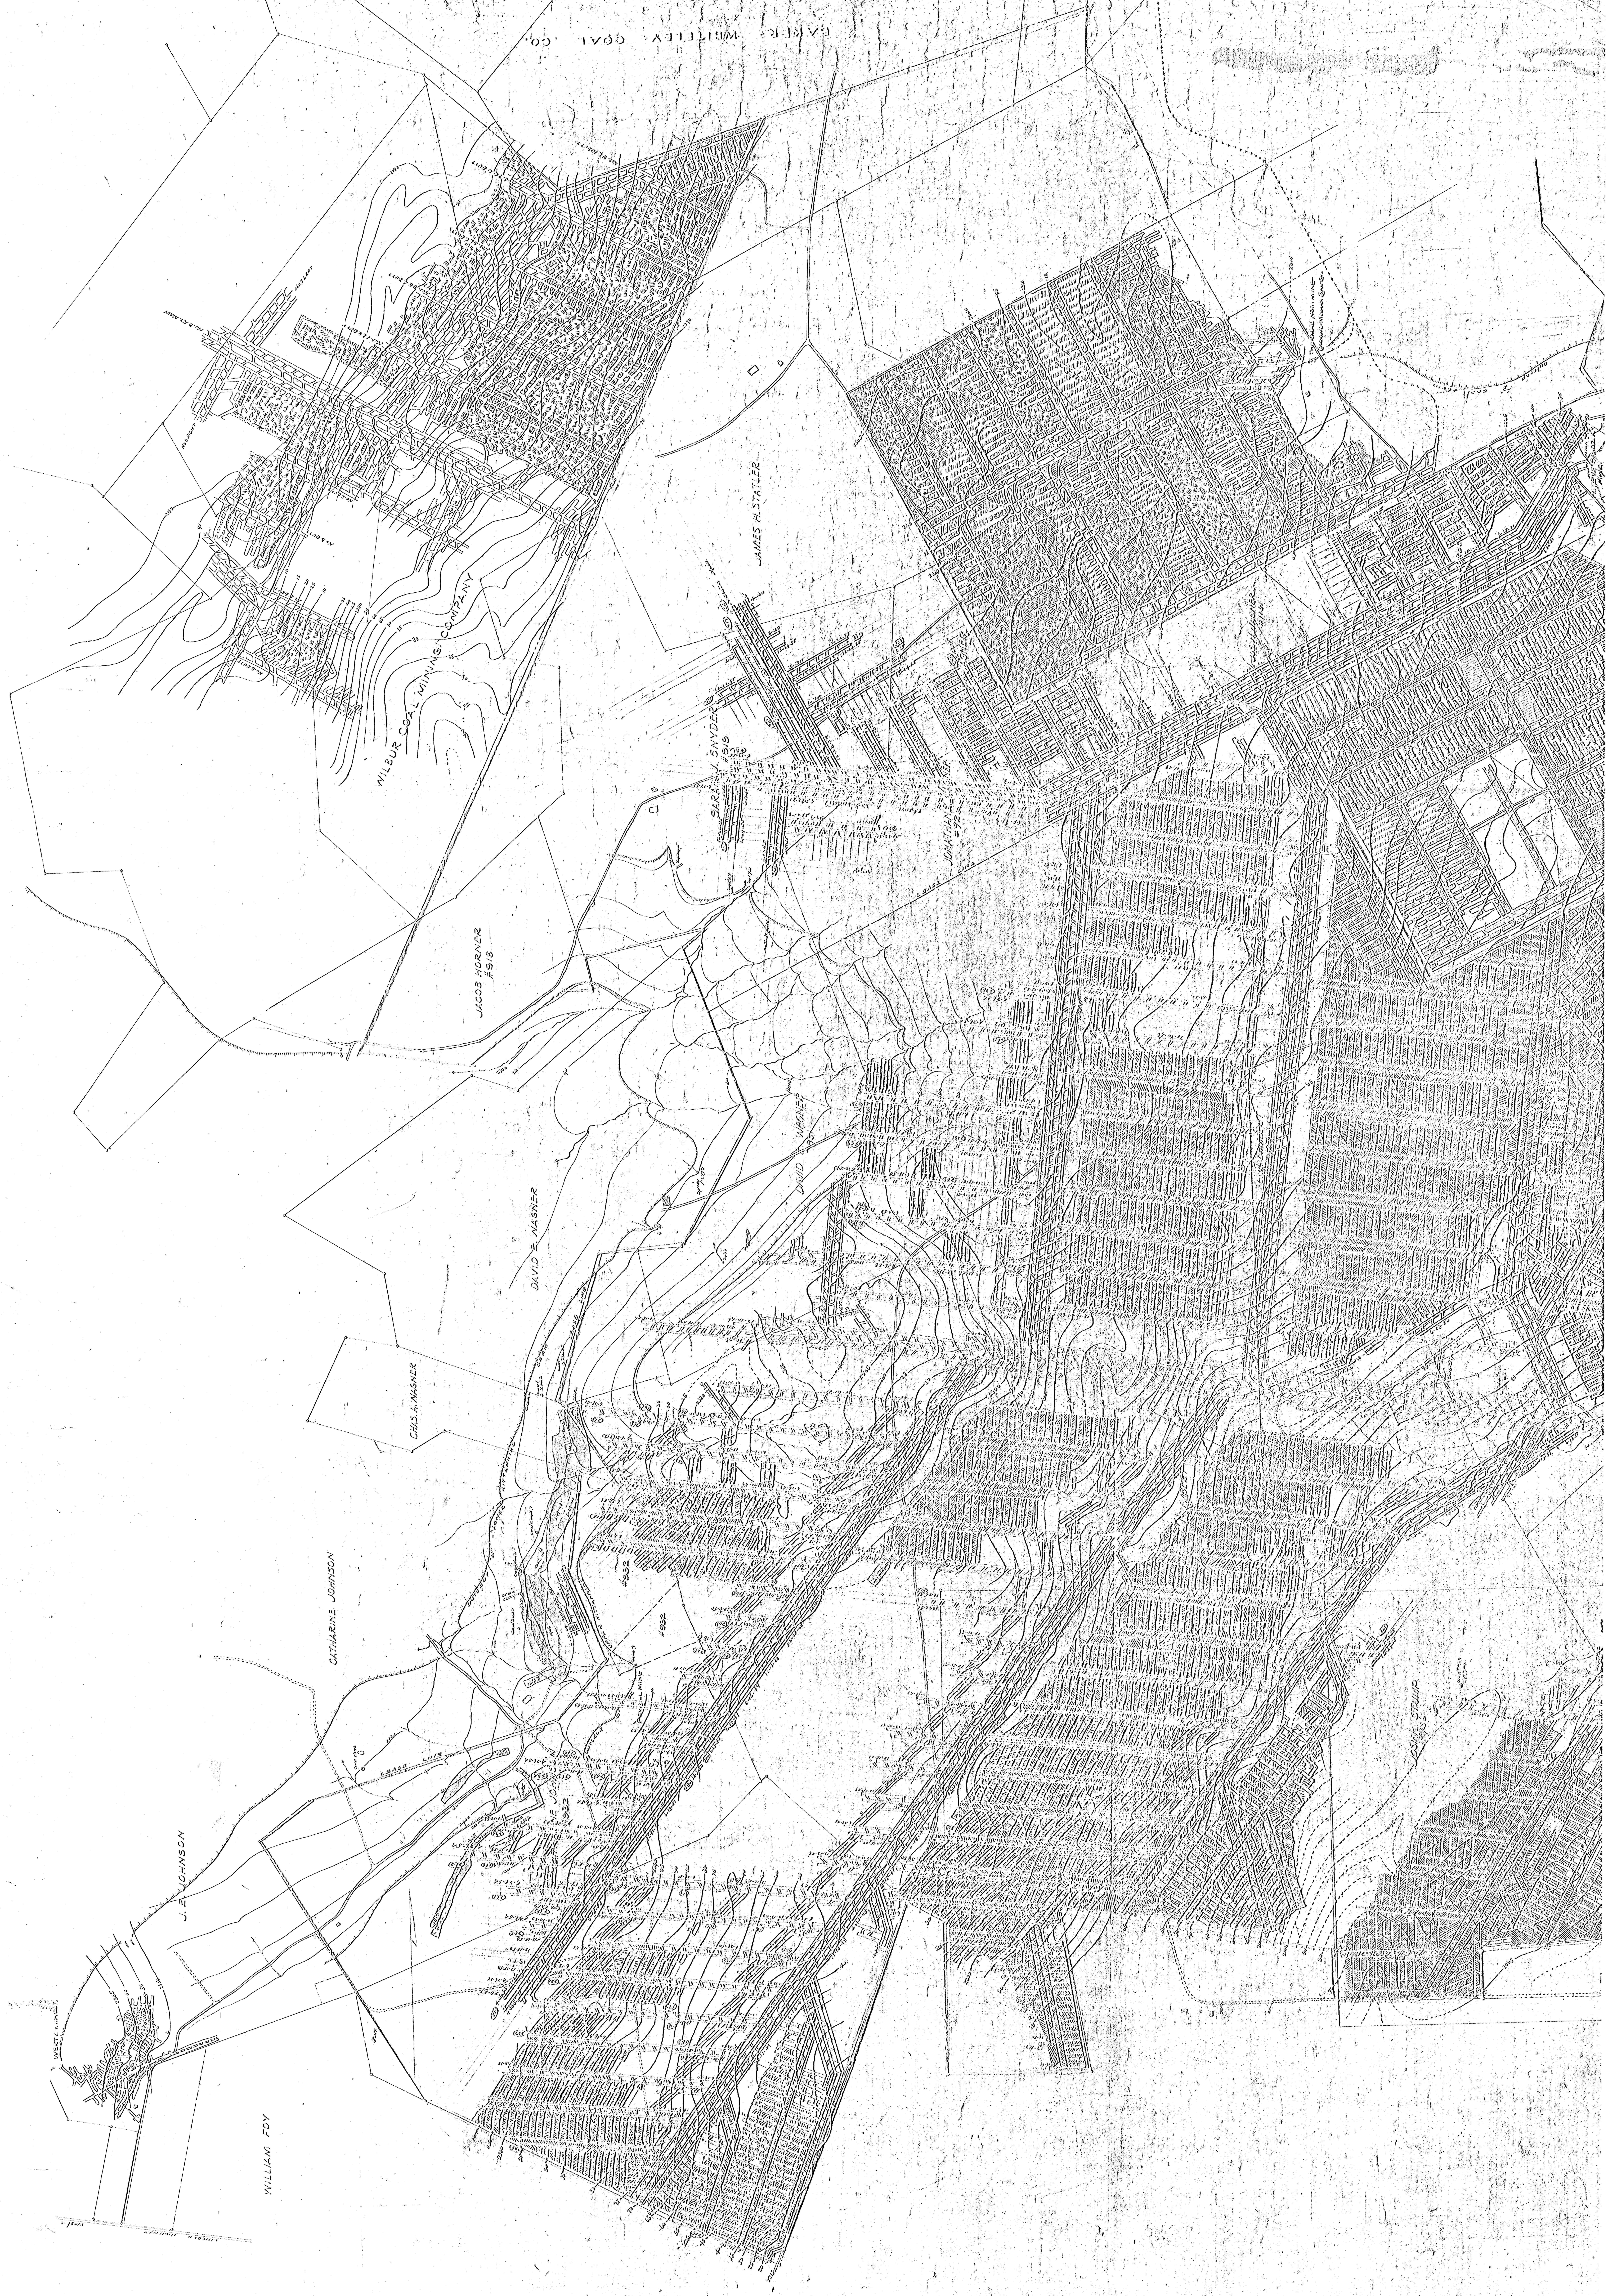

MASS.

1/2

+