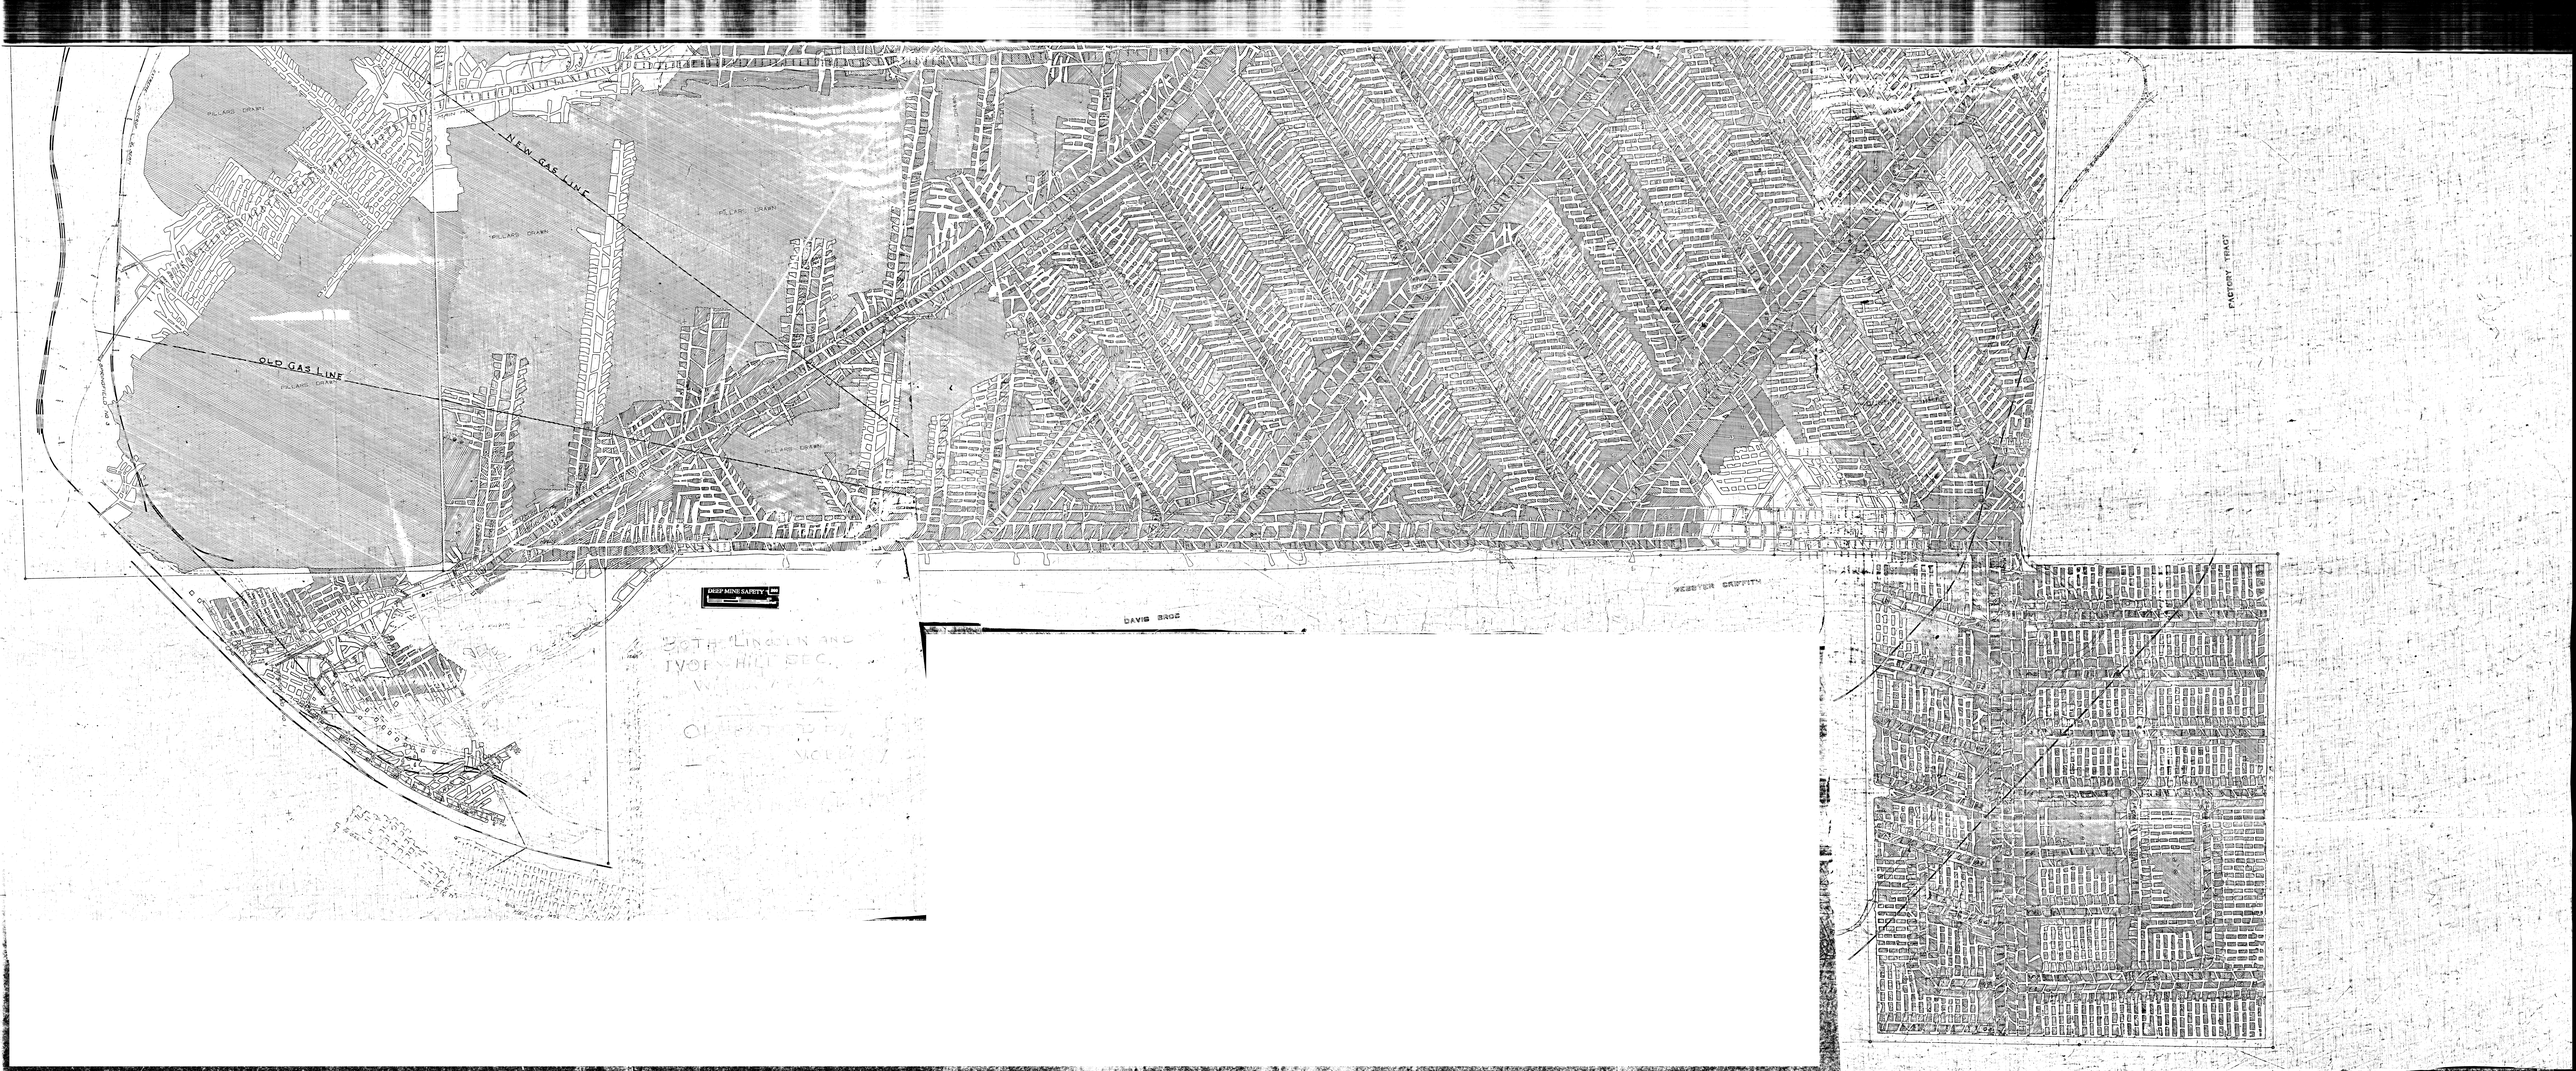
NEW GAS LINE
OLD GAS LINE
PILLARD DRAIN
DEEP MINE SAFETY
DAVIS BROS
WEBSTER GRIFFITH
FACTORY TRACT