


C C TRUITT

C C TRUITT

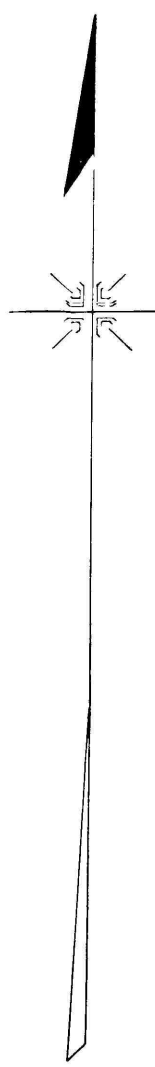

As per report
of Coal Co
Survey No. 1

COAL MINE WORKINGS
OF
P A & K M SHOEMAKER
MADISON TOWNSHIP
ARMSTRONG COUNTY, PA
TURNER & SHANNON R S KITTANNING, PA
SCALE 1"=100

Inspector J A Ligon Lu 1