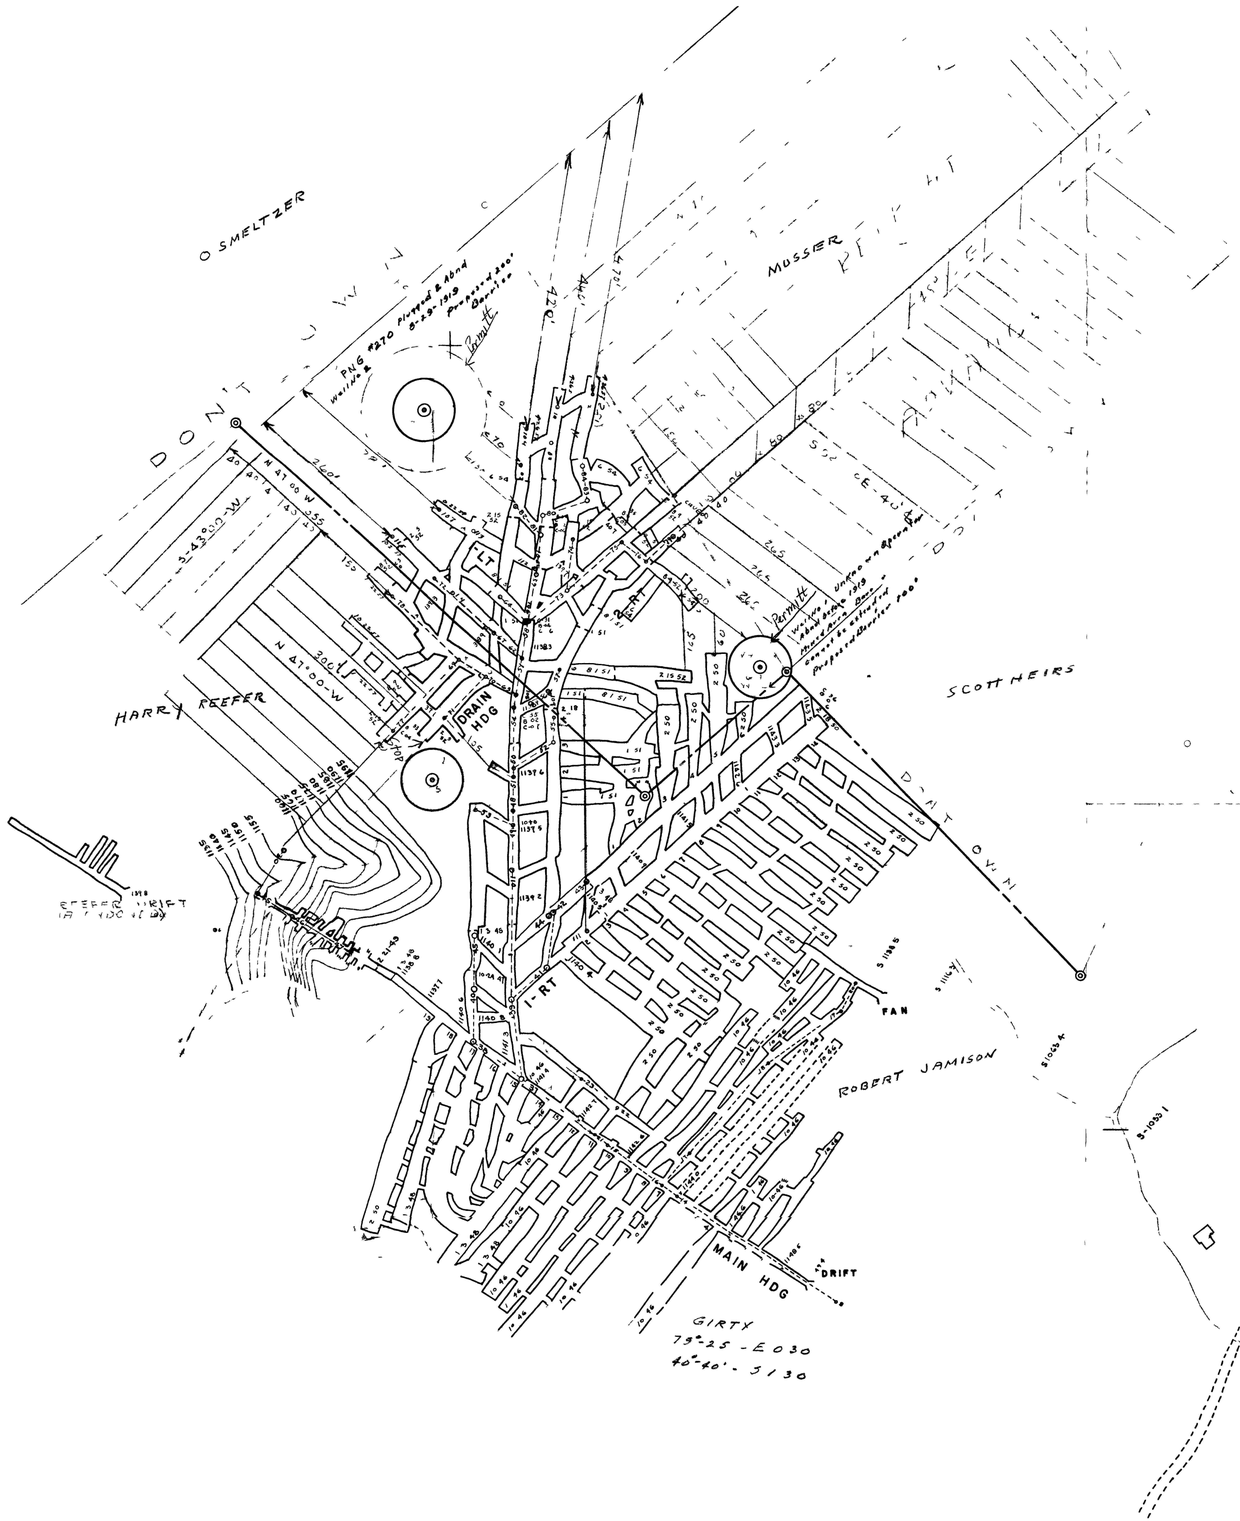

2 0 1957

2-91

2-91

wealth of Pennsylvania
& gas Division
Harrisburg - Pa

Gentlemen In closed is copy of map of Jamison Mine Located at Armstrong County, Dist Pa South Bend Twp Girty
Mine is being operated by Joseph Dobrosky Box 431 Avonmore, Pa
We are requesting Pillar Permit for two gas wells located on this map on the upper & lower Right hand Side Wells Marked Permit

Yours truly
Dobrosky Coal Co
Joseph Dobrosky

JOSEPH DOBROSKY
Box 431
AVONMORE, Pa

Straw & King Coal Co.
Jamison
Armstrong Co District 2
1956 Annual

Dobrosky Coal Co.
Jamison
Armstrong Co District 2
1957 Annual

KLAMAR COAL CO
JAMISON
ARMSTRONG CO
DISTRICT 2
1960 ANNUAL
Dist 2

MAP OF JAMISON MINE

B & M COAL CO

SOUTH BEND TWP ARMSTRONG CO PA.

SCALE 1 = 100

OPERATED BY DOBROSKY COAL CO.
Box 431, Avonmore, Pa.