



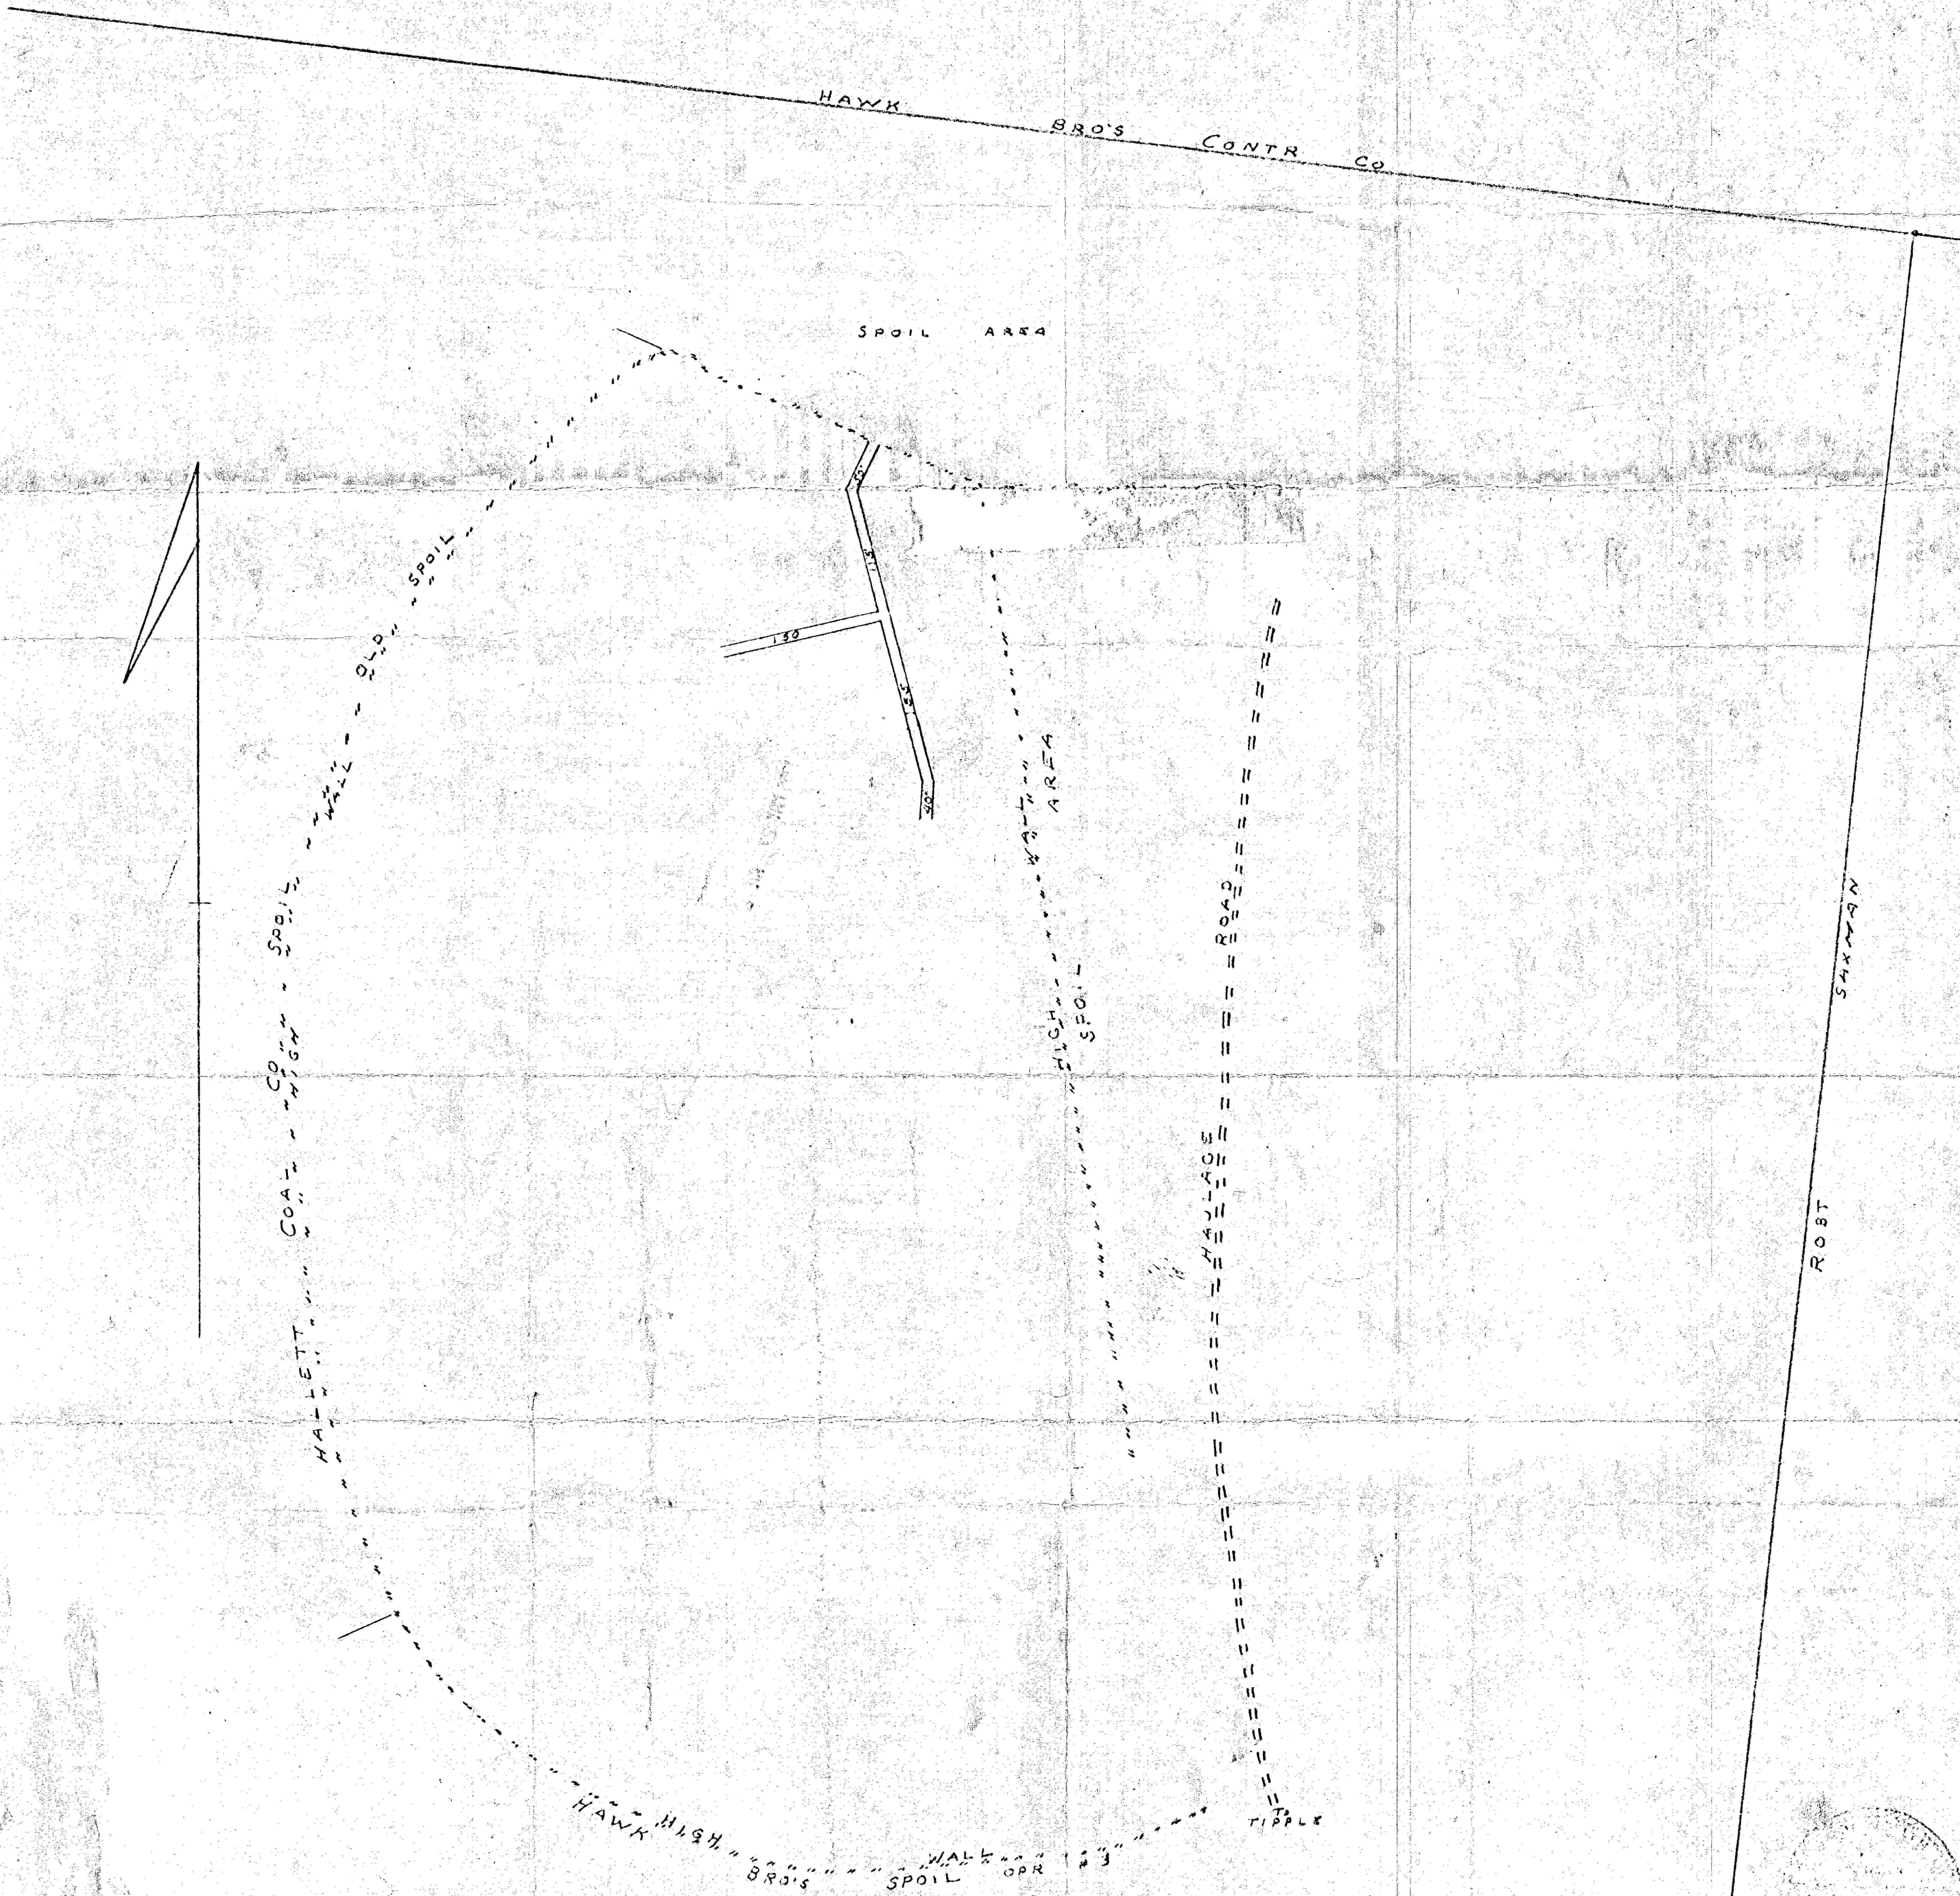

CHARLES E KIEHL MINE
 MAHONING TWP ARMSTRONG COUNTY PA
 SCALE 1 = 100' FEB 1 1958

*Charles E Kiehl
 Hawthorn Pa*

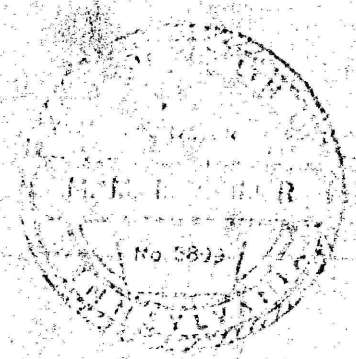

*Keihl Coal Co,
 Kiehl
 District 2.
 1957 Annual*

*McWilliams, Redbank Twp,
 15' Rural Valley*

Posted 6/24/1958