C.N. REESEMAN

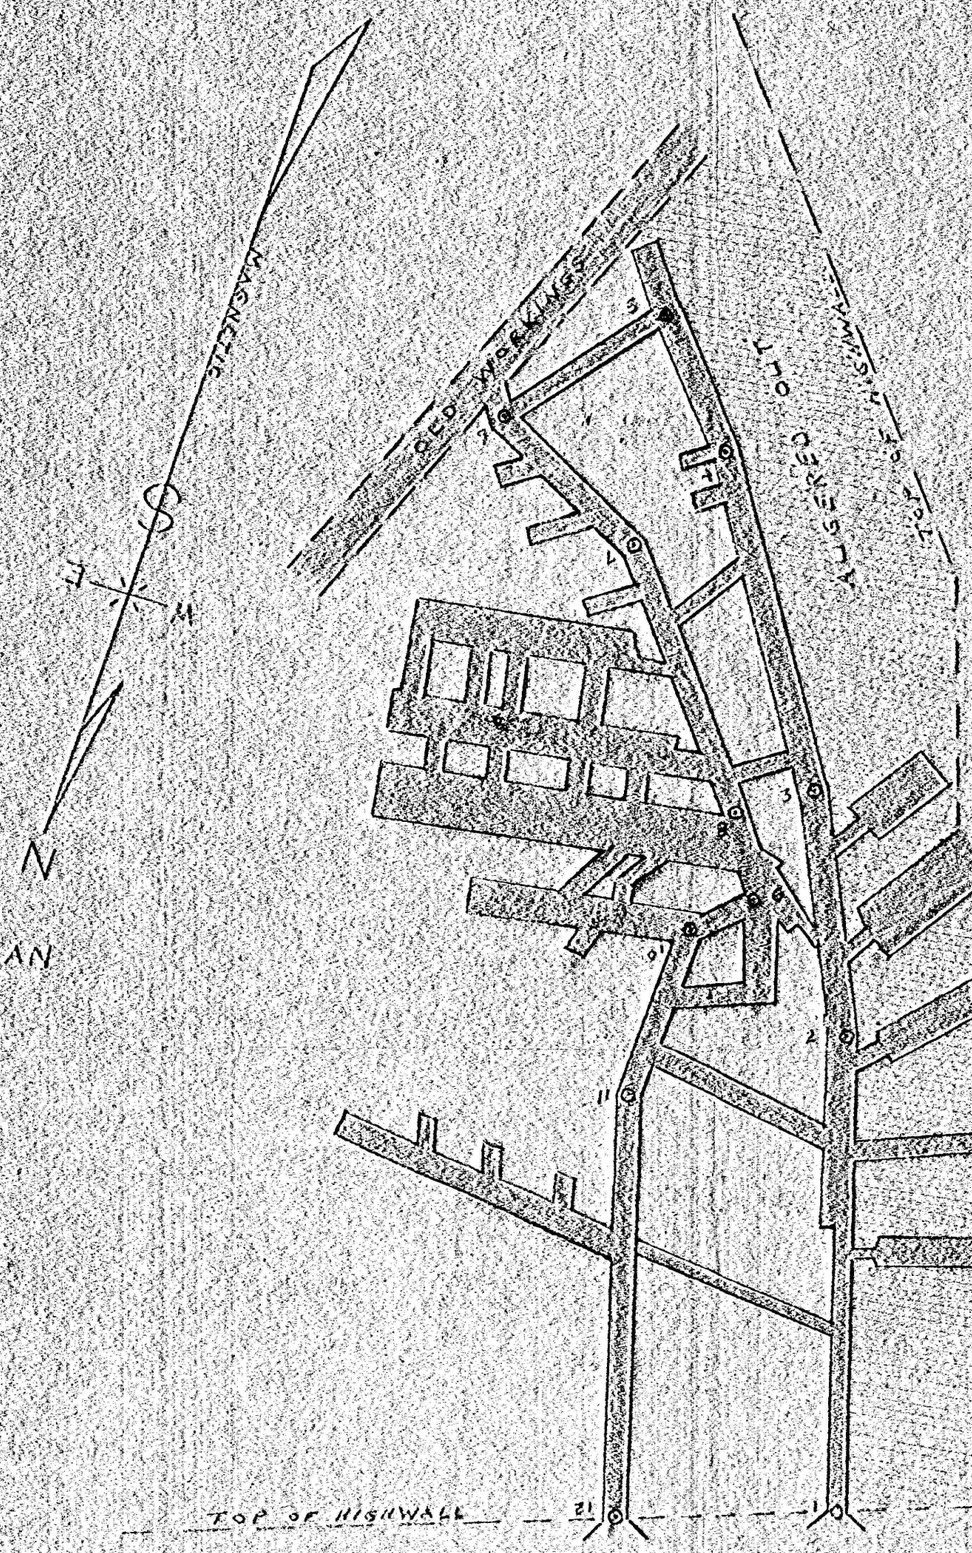

C.N. REESEMAN

C.N. REESEMAN

C.N. REESEMAN

SURVEY OF THE Nº 2 MINE OF THE
GRISSMAN COAL COMPANY
WAYNE TWP ARMSTRONG COUNTY PA.
SCALE: 1" = 50' DATE: 3-15-57

REGISTERED PROFESSIONAL ENGINEER No. 12451 PENNSYLVANIA

S. Schneeberger
Pa. 12451