


10

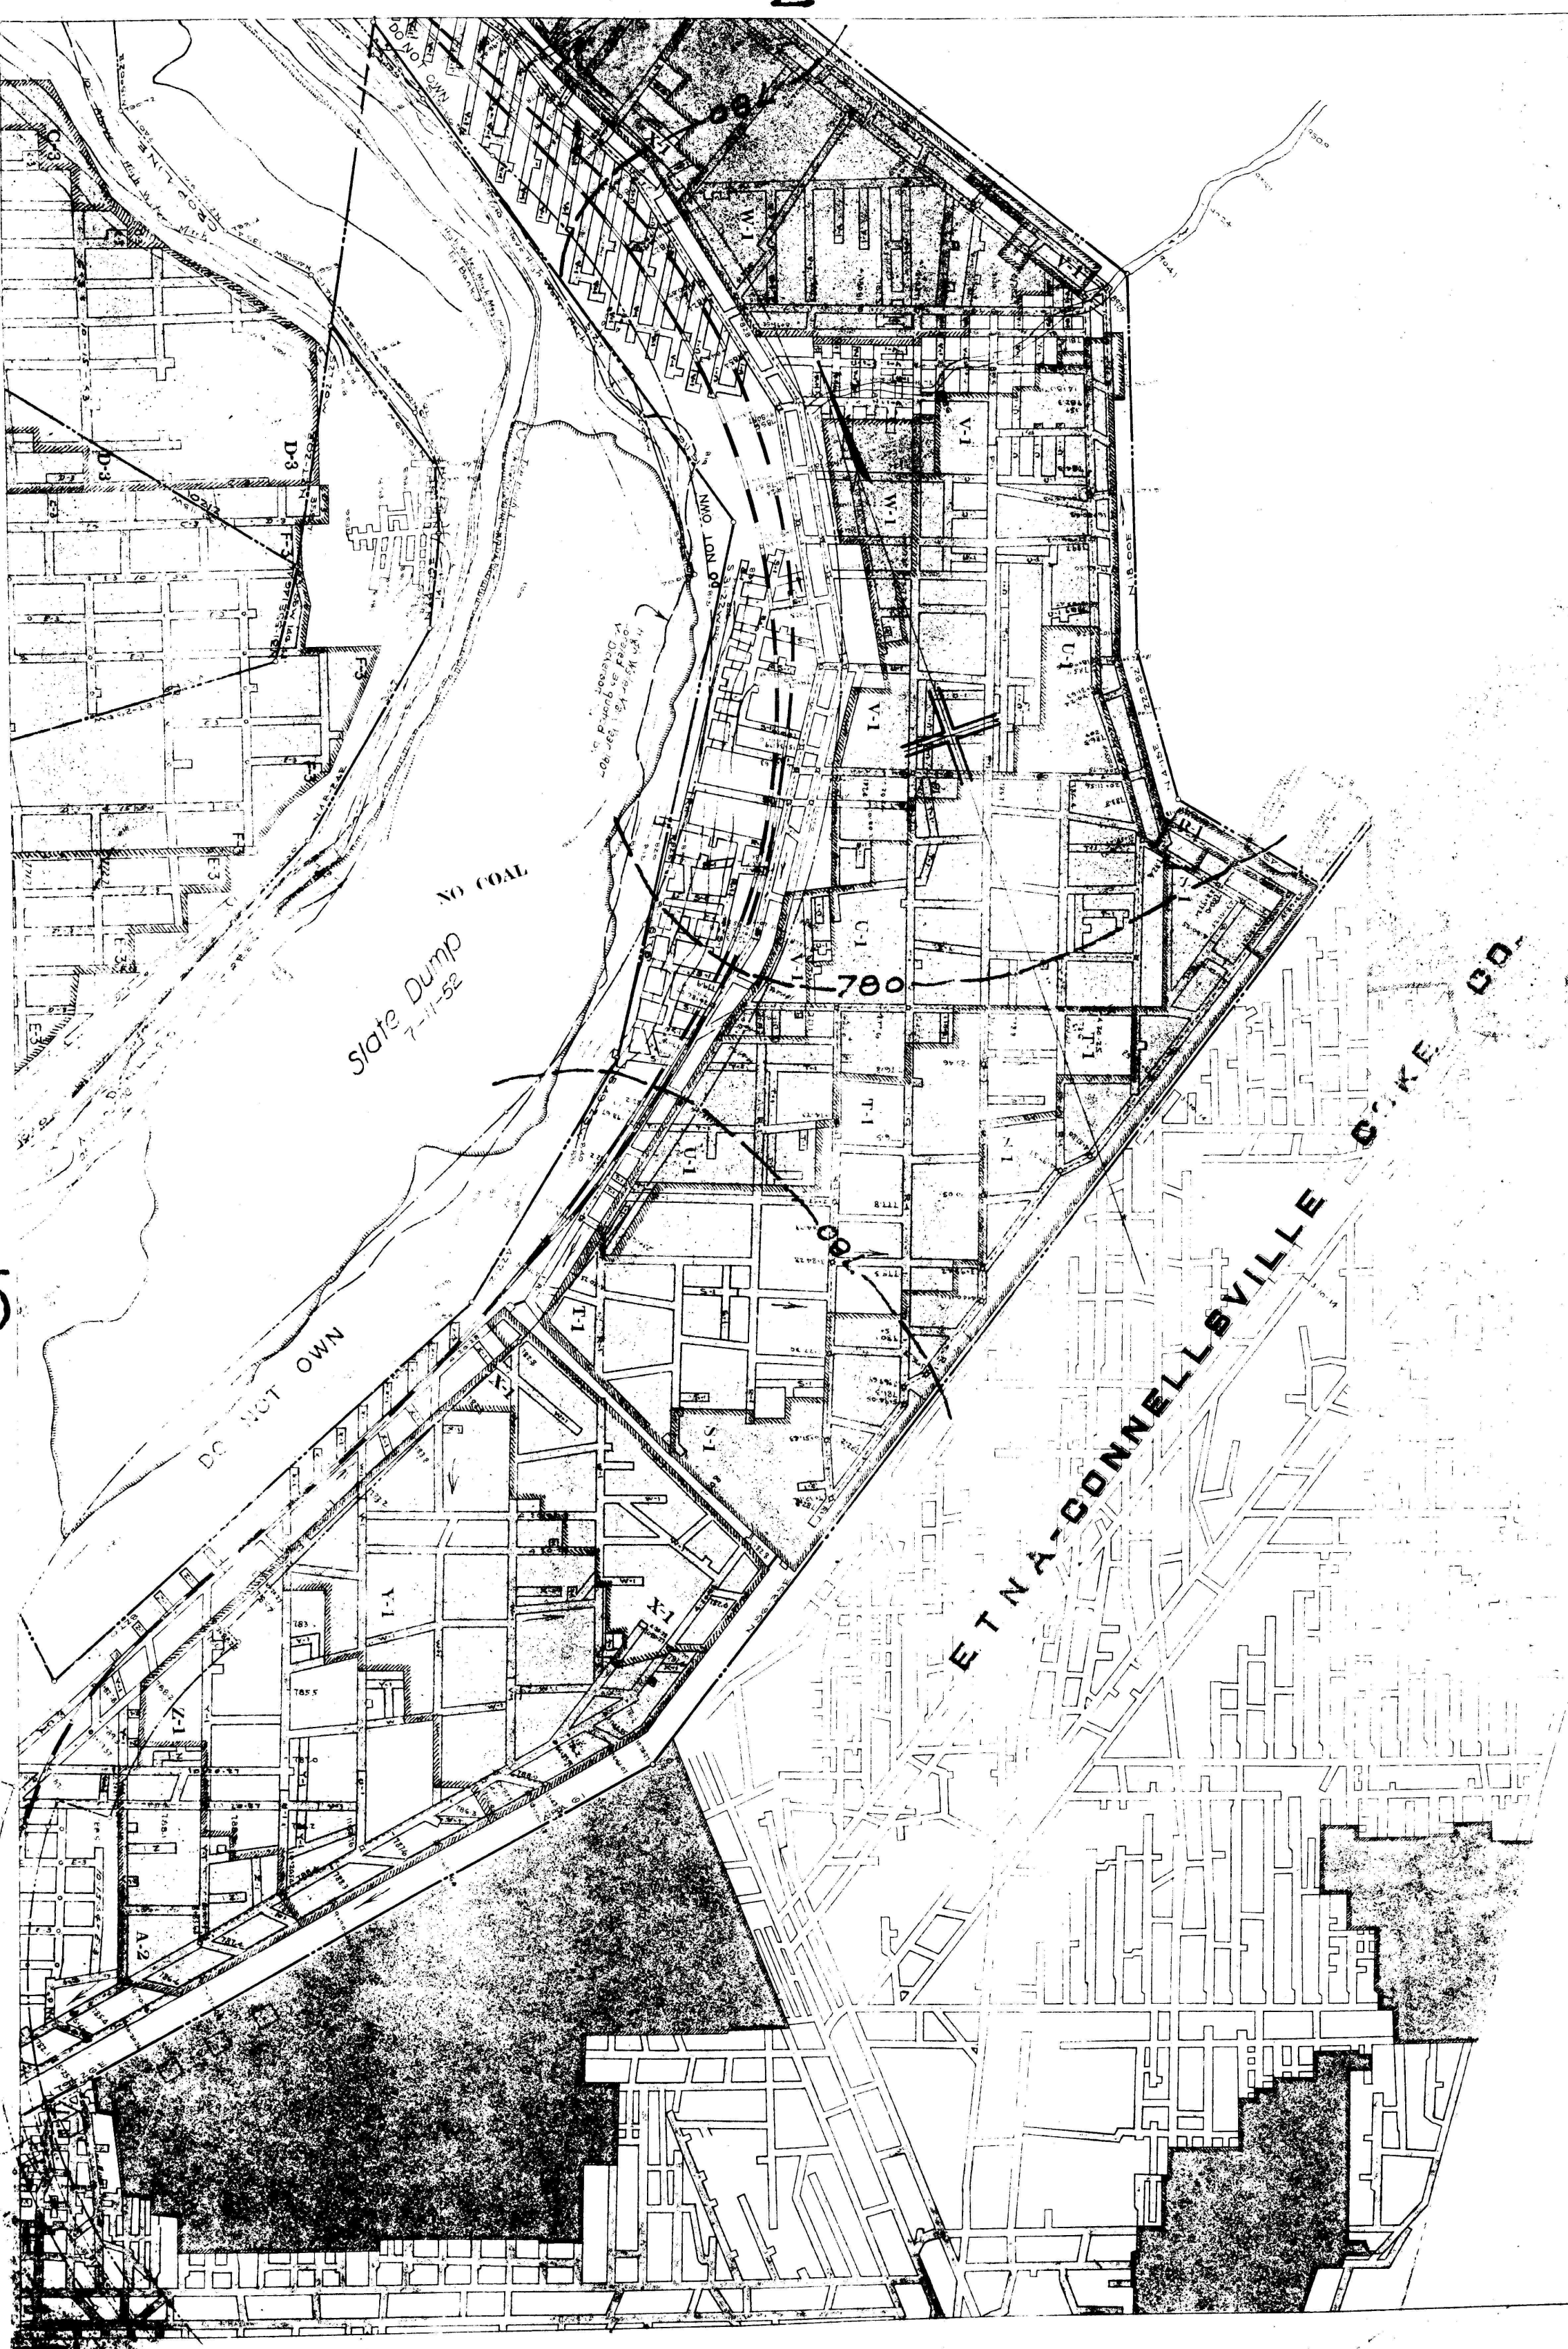

DEEP MINE SAFETY
100'