


DEEP MINE SAFETY
100
0 10 20 30 40 50 60 70 80 90 100

FIT TO 14
14

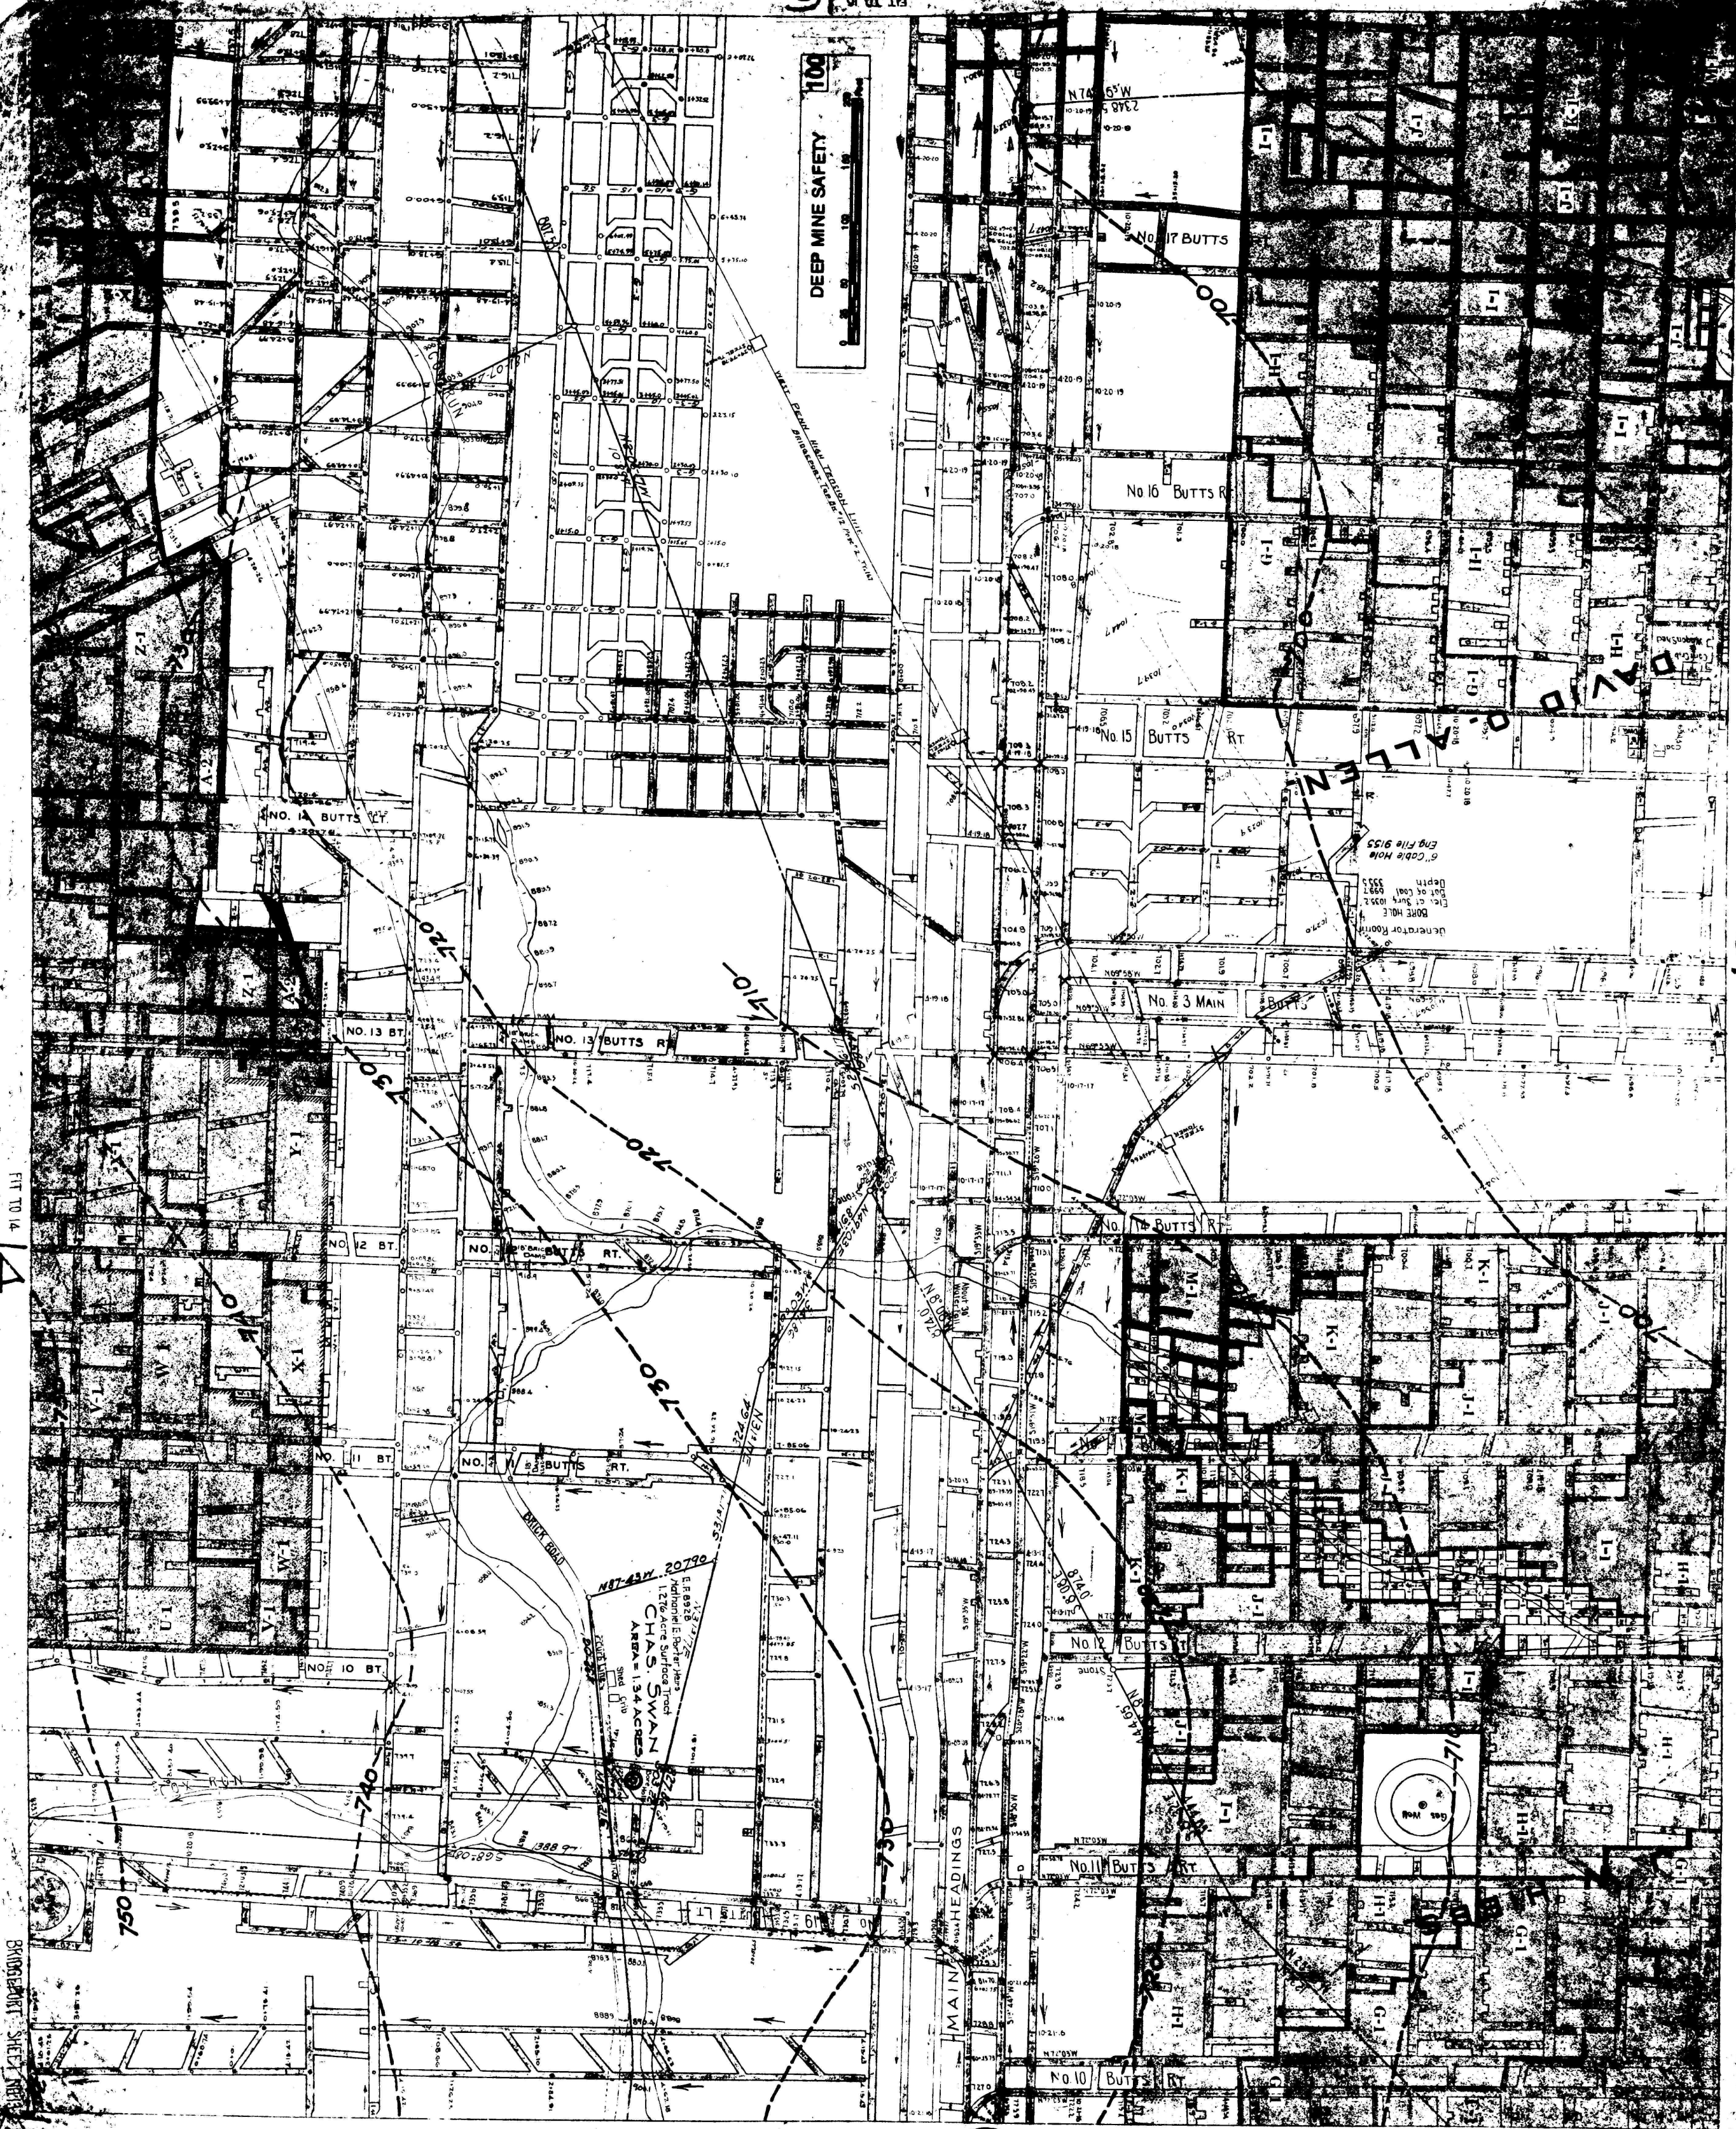

BRIDGEPORT SHEET AREA