


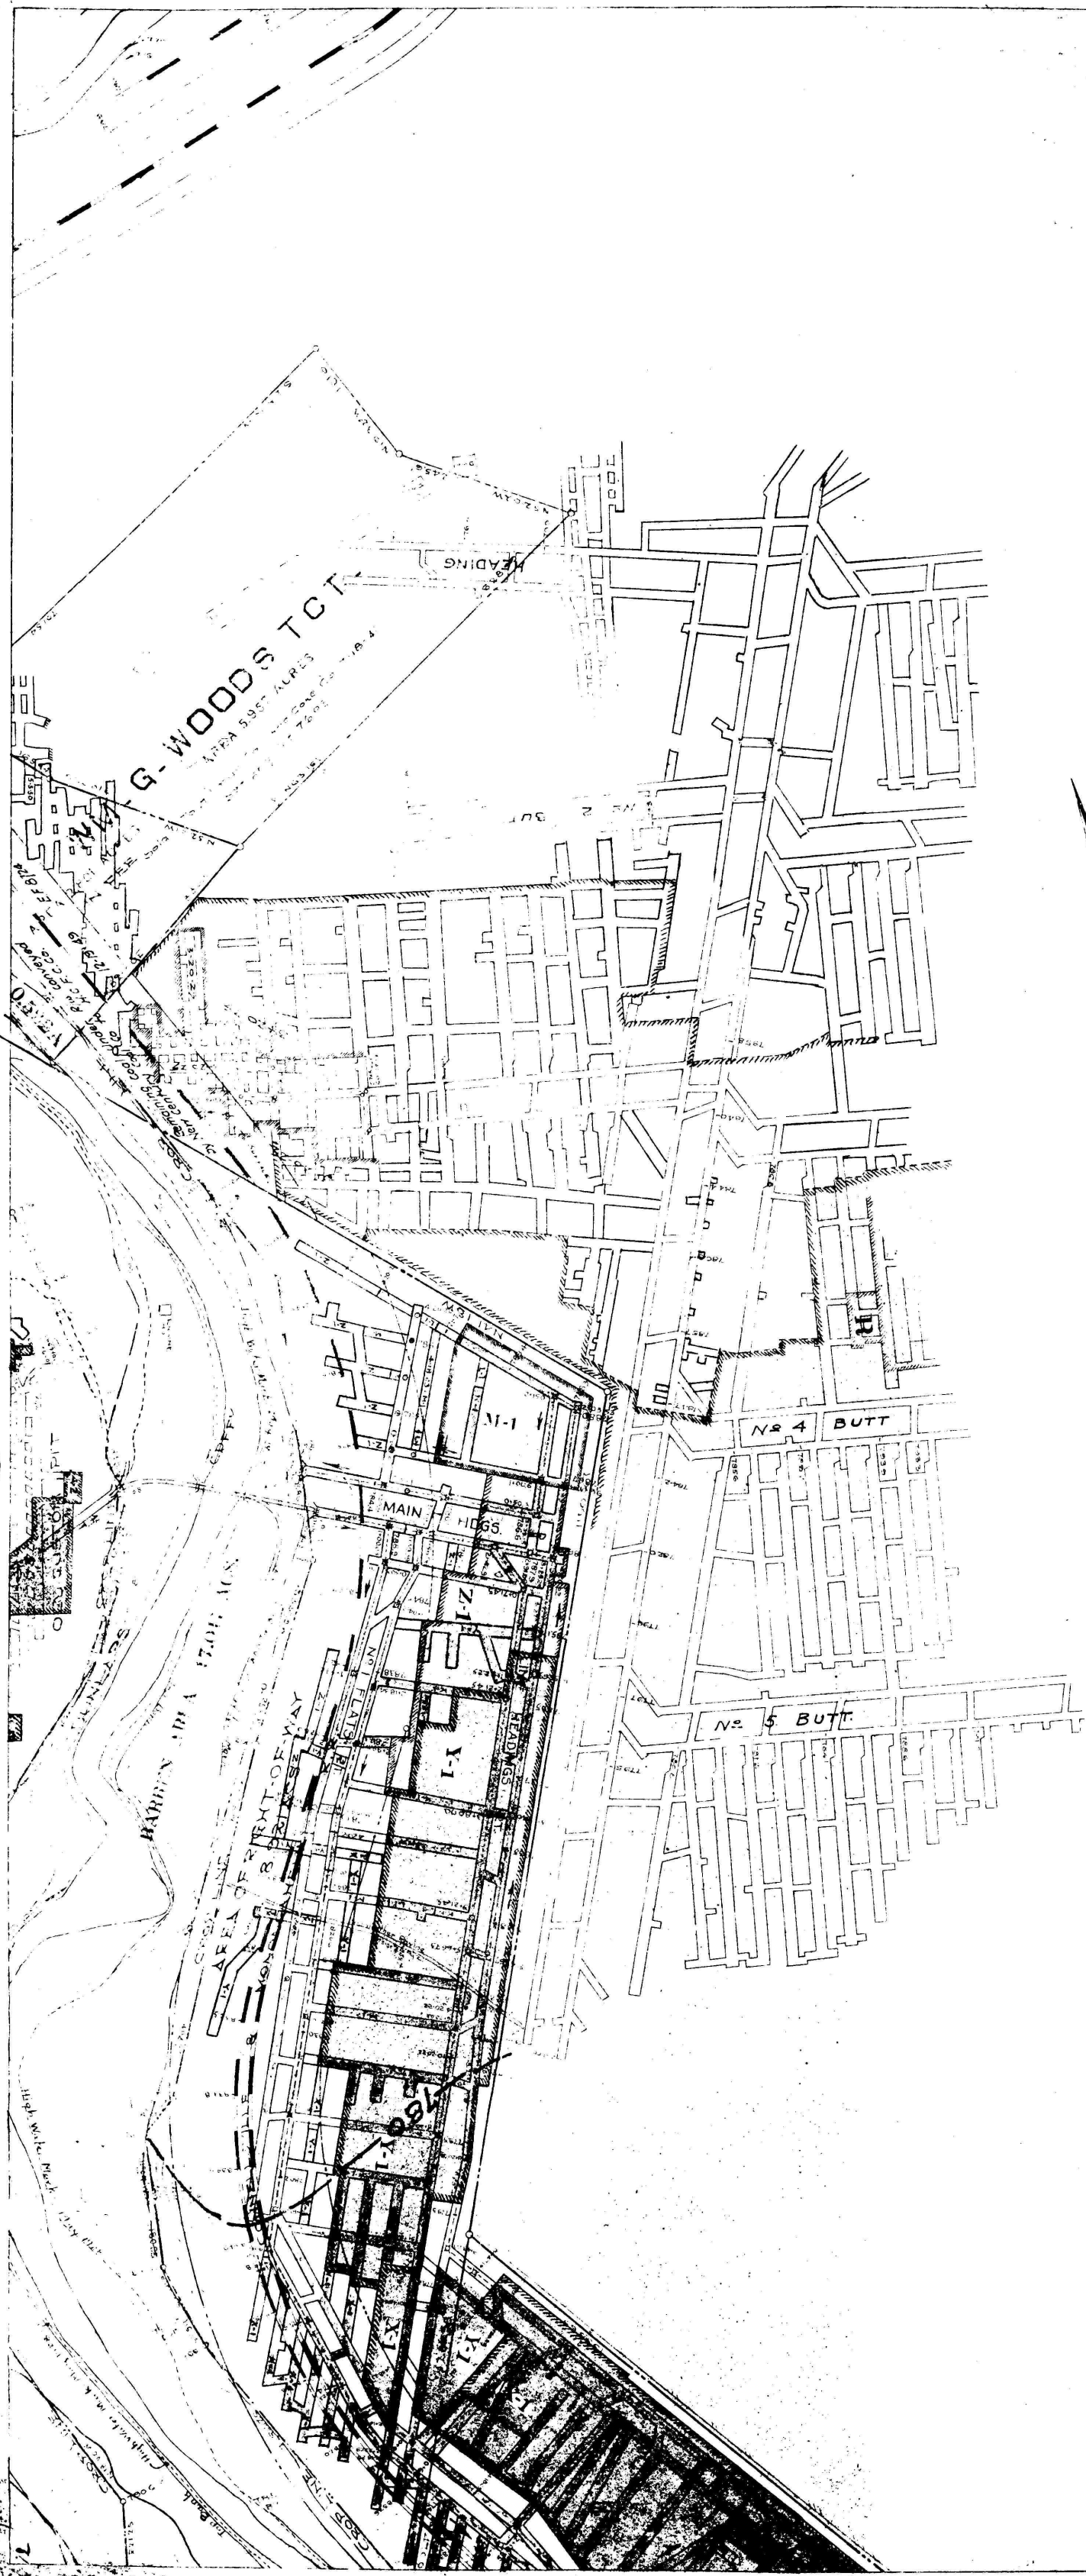

CENTURY COKE CO.

