


MINE MAP
J.K. SHERRY &
COAL MINE Dist. 2

Redbank Township, Armstrong County, Pa.

Scale 1" = 100' October 18, 1957

Walter J. Zimmerman Surveyor Engineer
Punxsutawney, Pa.

Sherry & Yarger Coal Co.,
S & Y
1956 Annual District 2

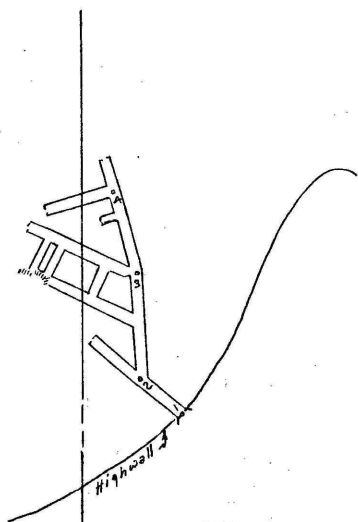

Geo. Ellenberger

Lameier Yarger

