


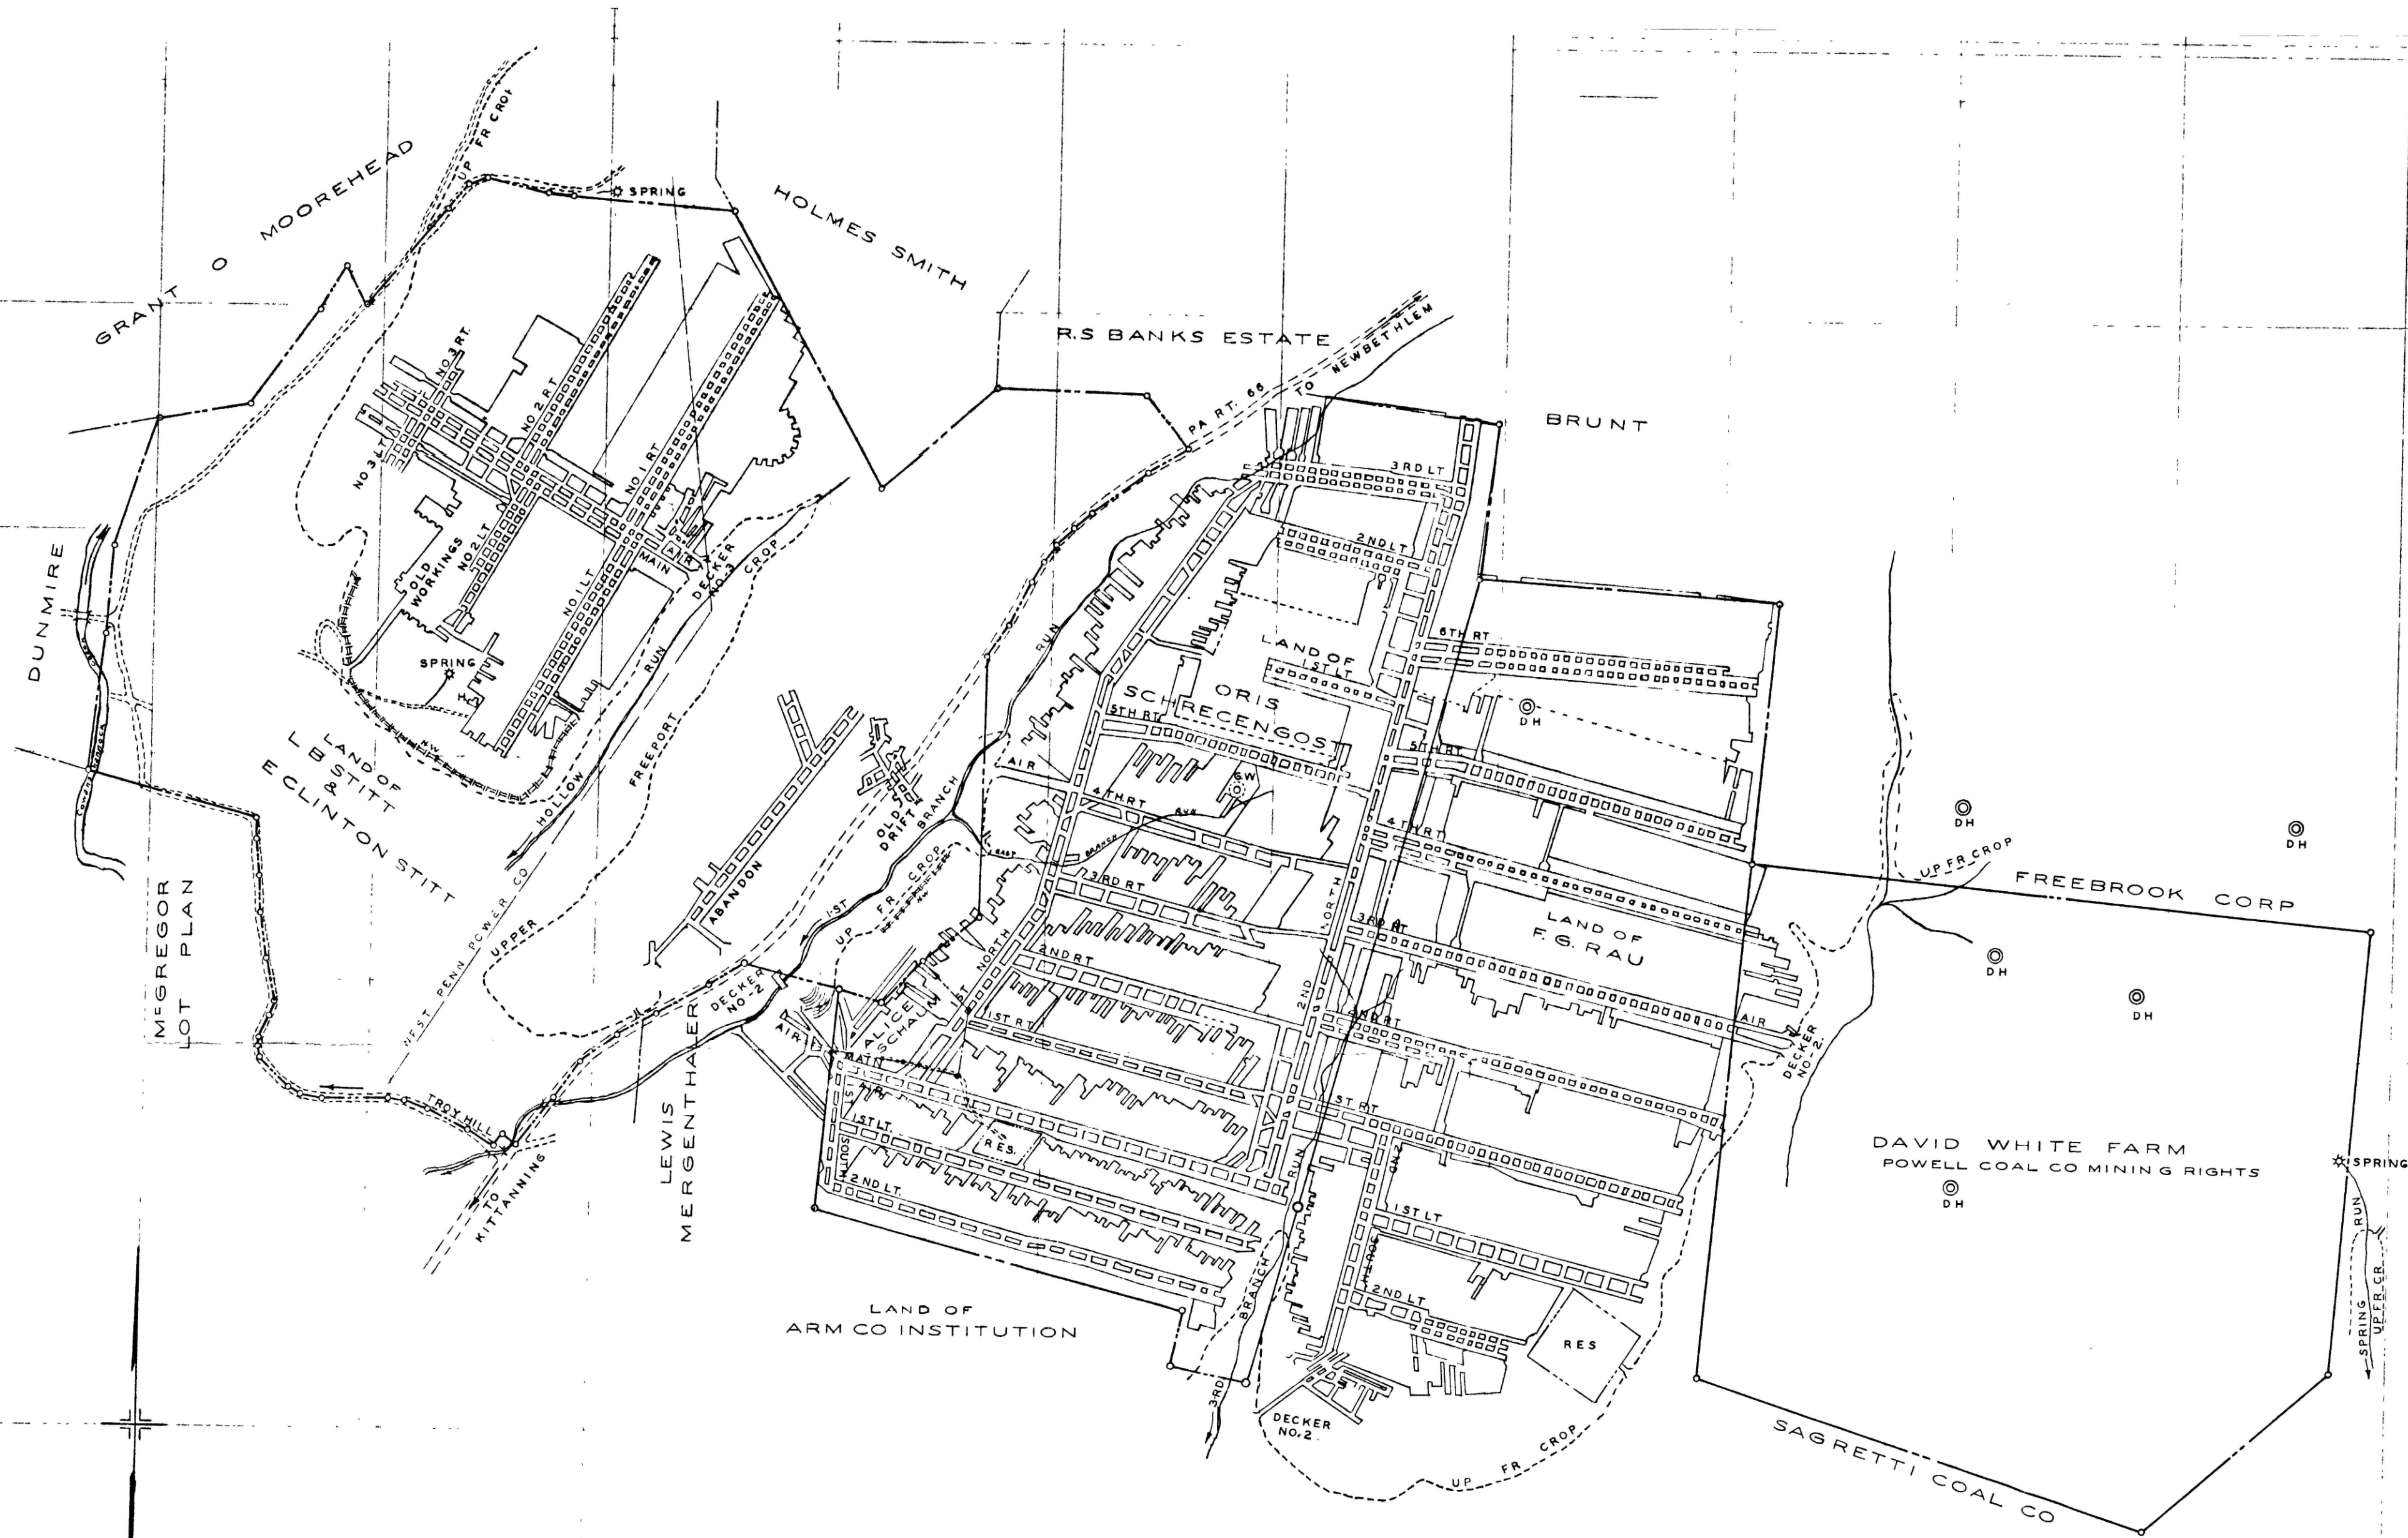

HIGHLAND COAL CO.
DECKER #2
RAYBURN TWP.
DISTRICT #2 1961

MAP
POWELL COAL CO.
DECKER NO. 2-3
RAYBURN TWP.-ARMSTRONG CO. PA.
SCALE 1"=400' FEBRUARY-18-1957