


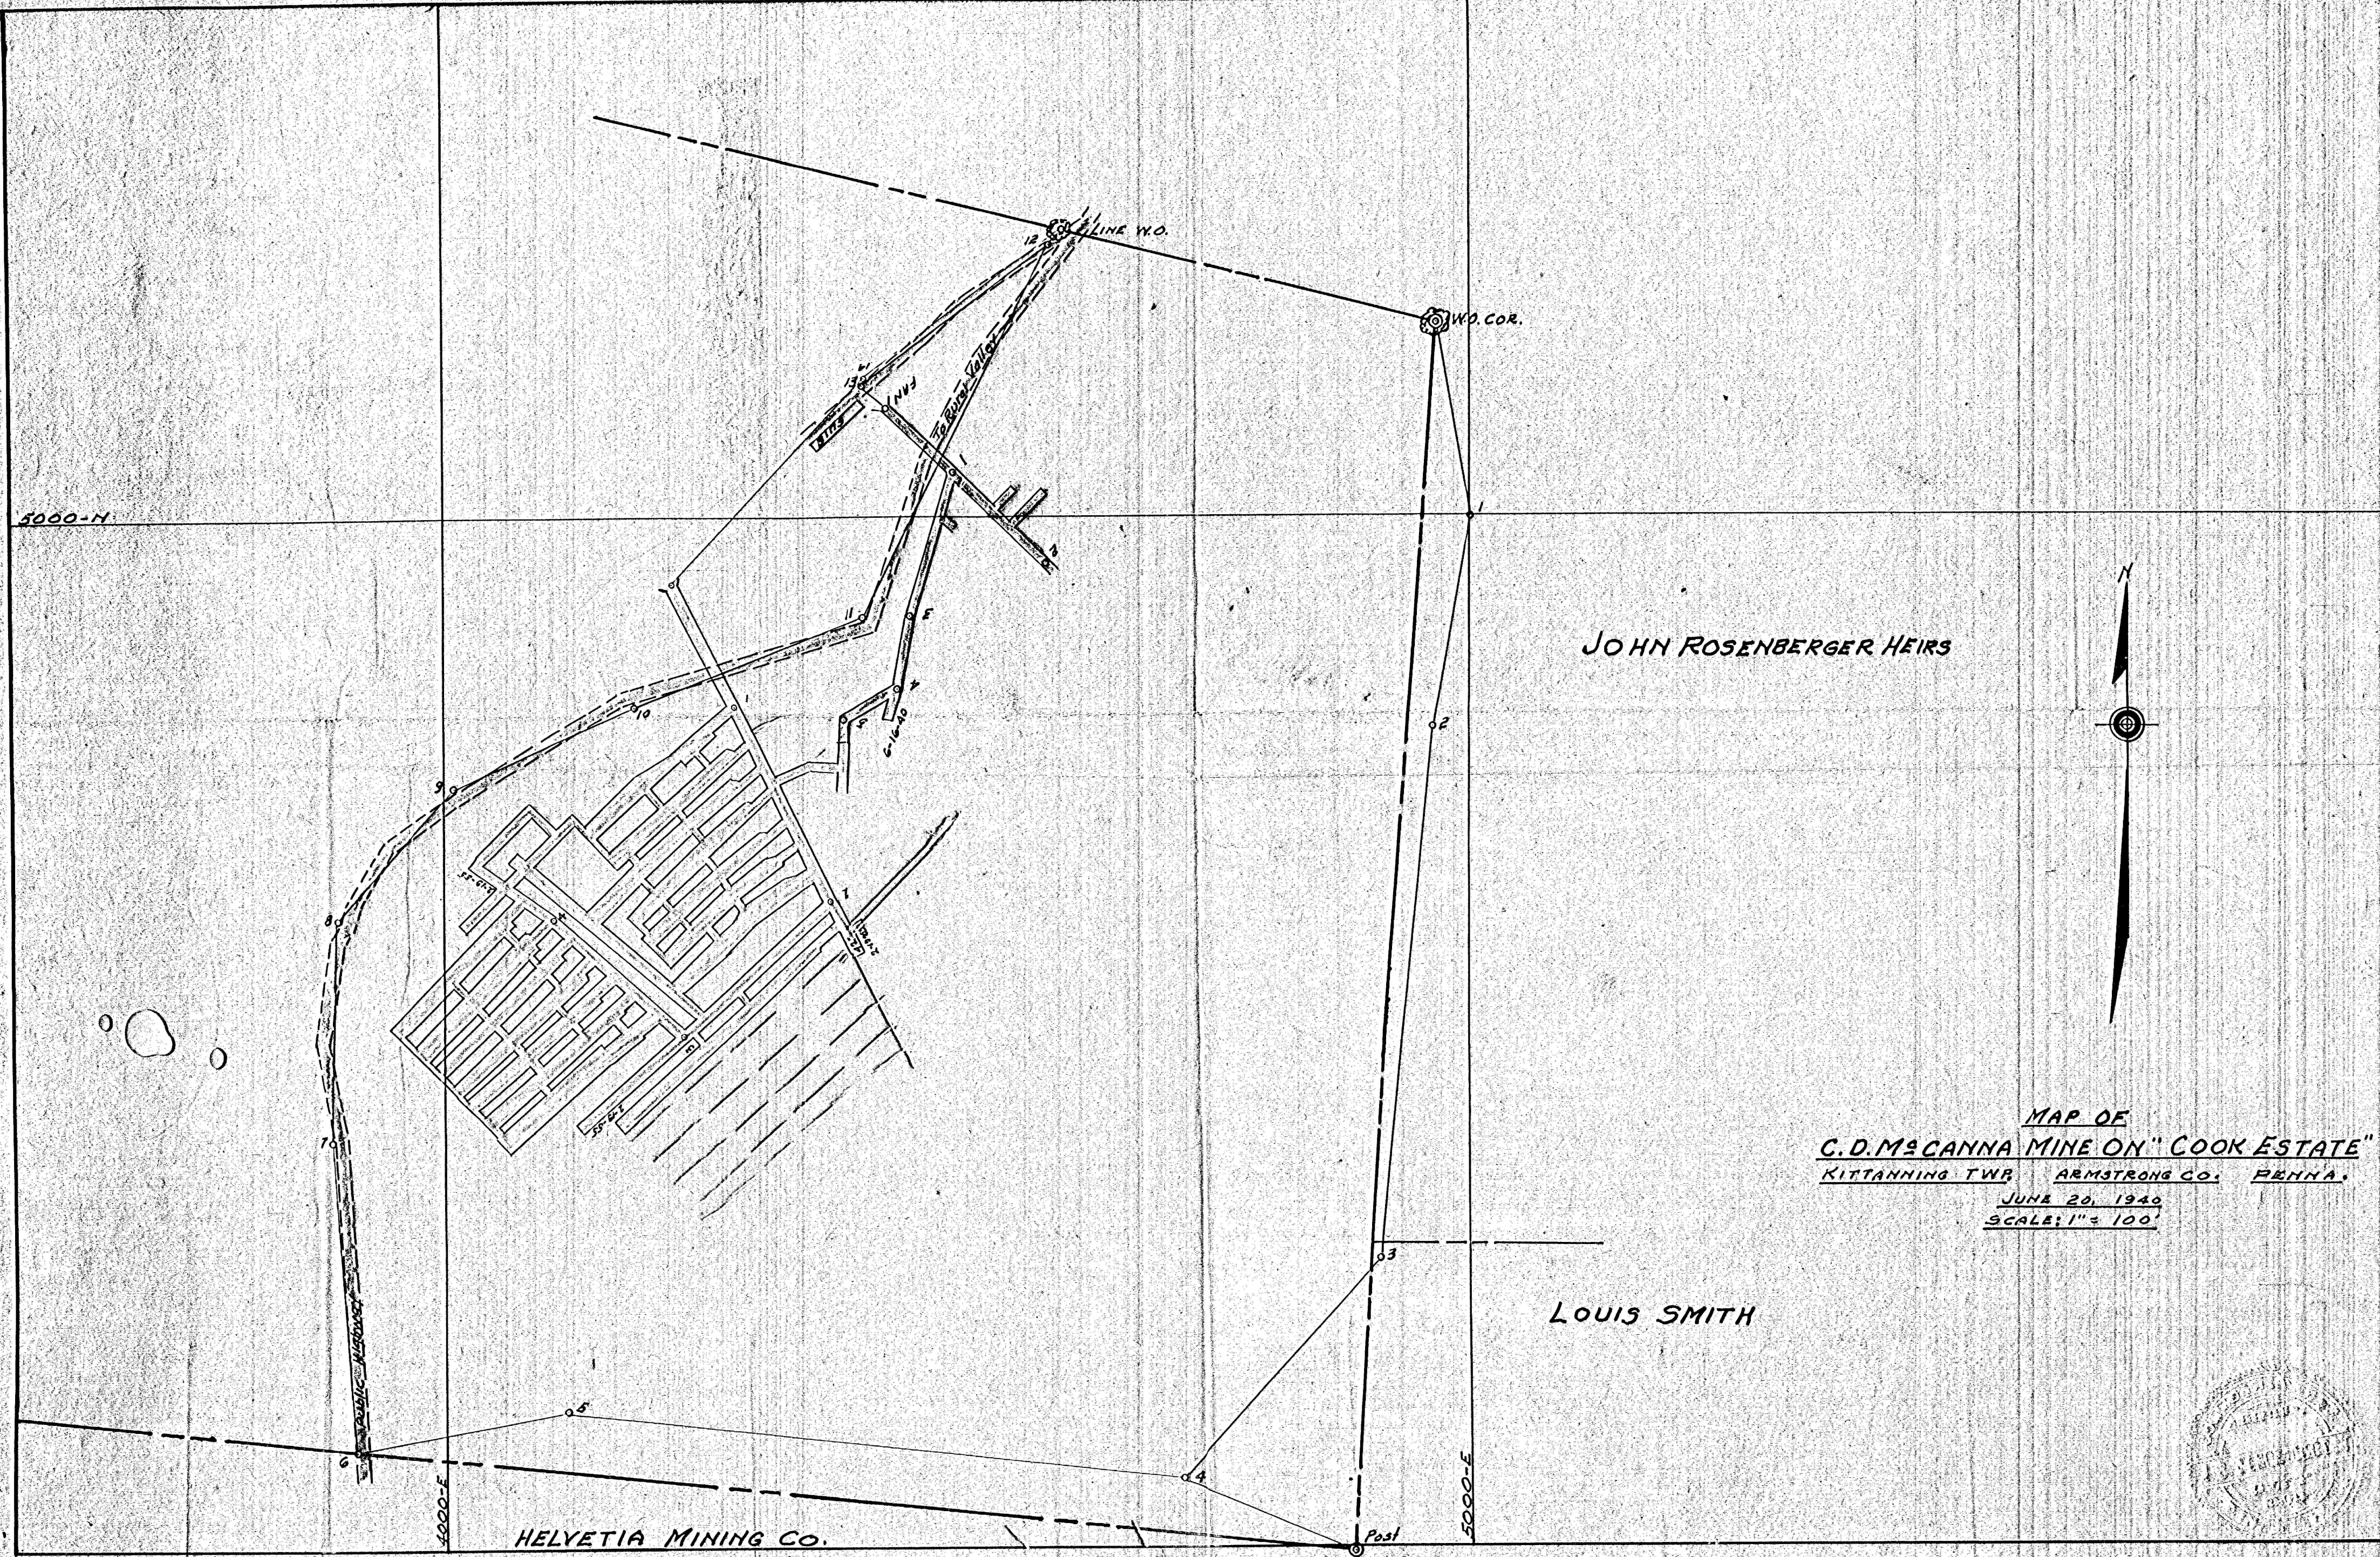

JOHN ROSENBERGER HEIRS

LOUIS SMITH

HELVETIA MINING CO.

MAP OF
C.D. McCANNA MINE ON "COOK ESTATE"
KITTANNING TWP. ARMSTRONG CO. PENNA.
JUNE 20, 1940
SCALE: 1" = 100'

