


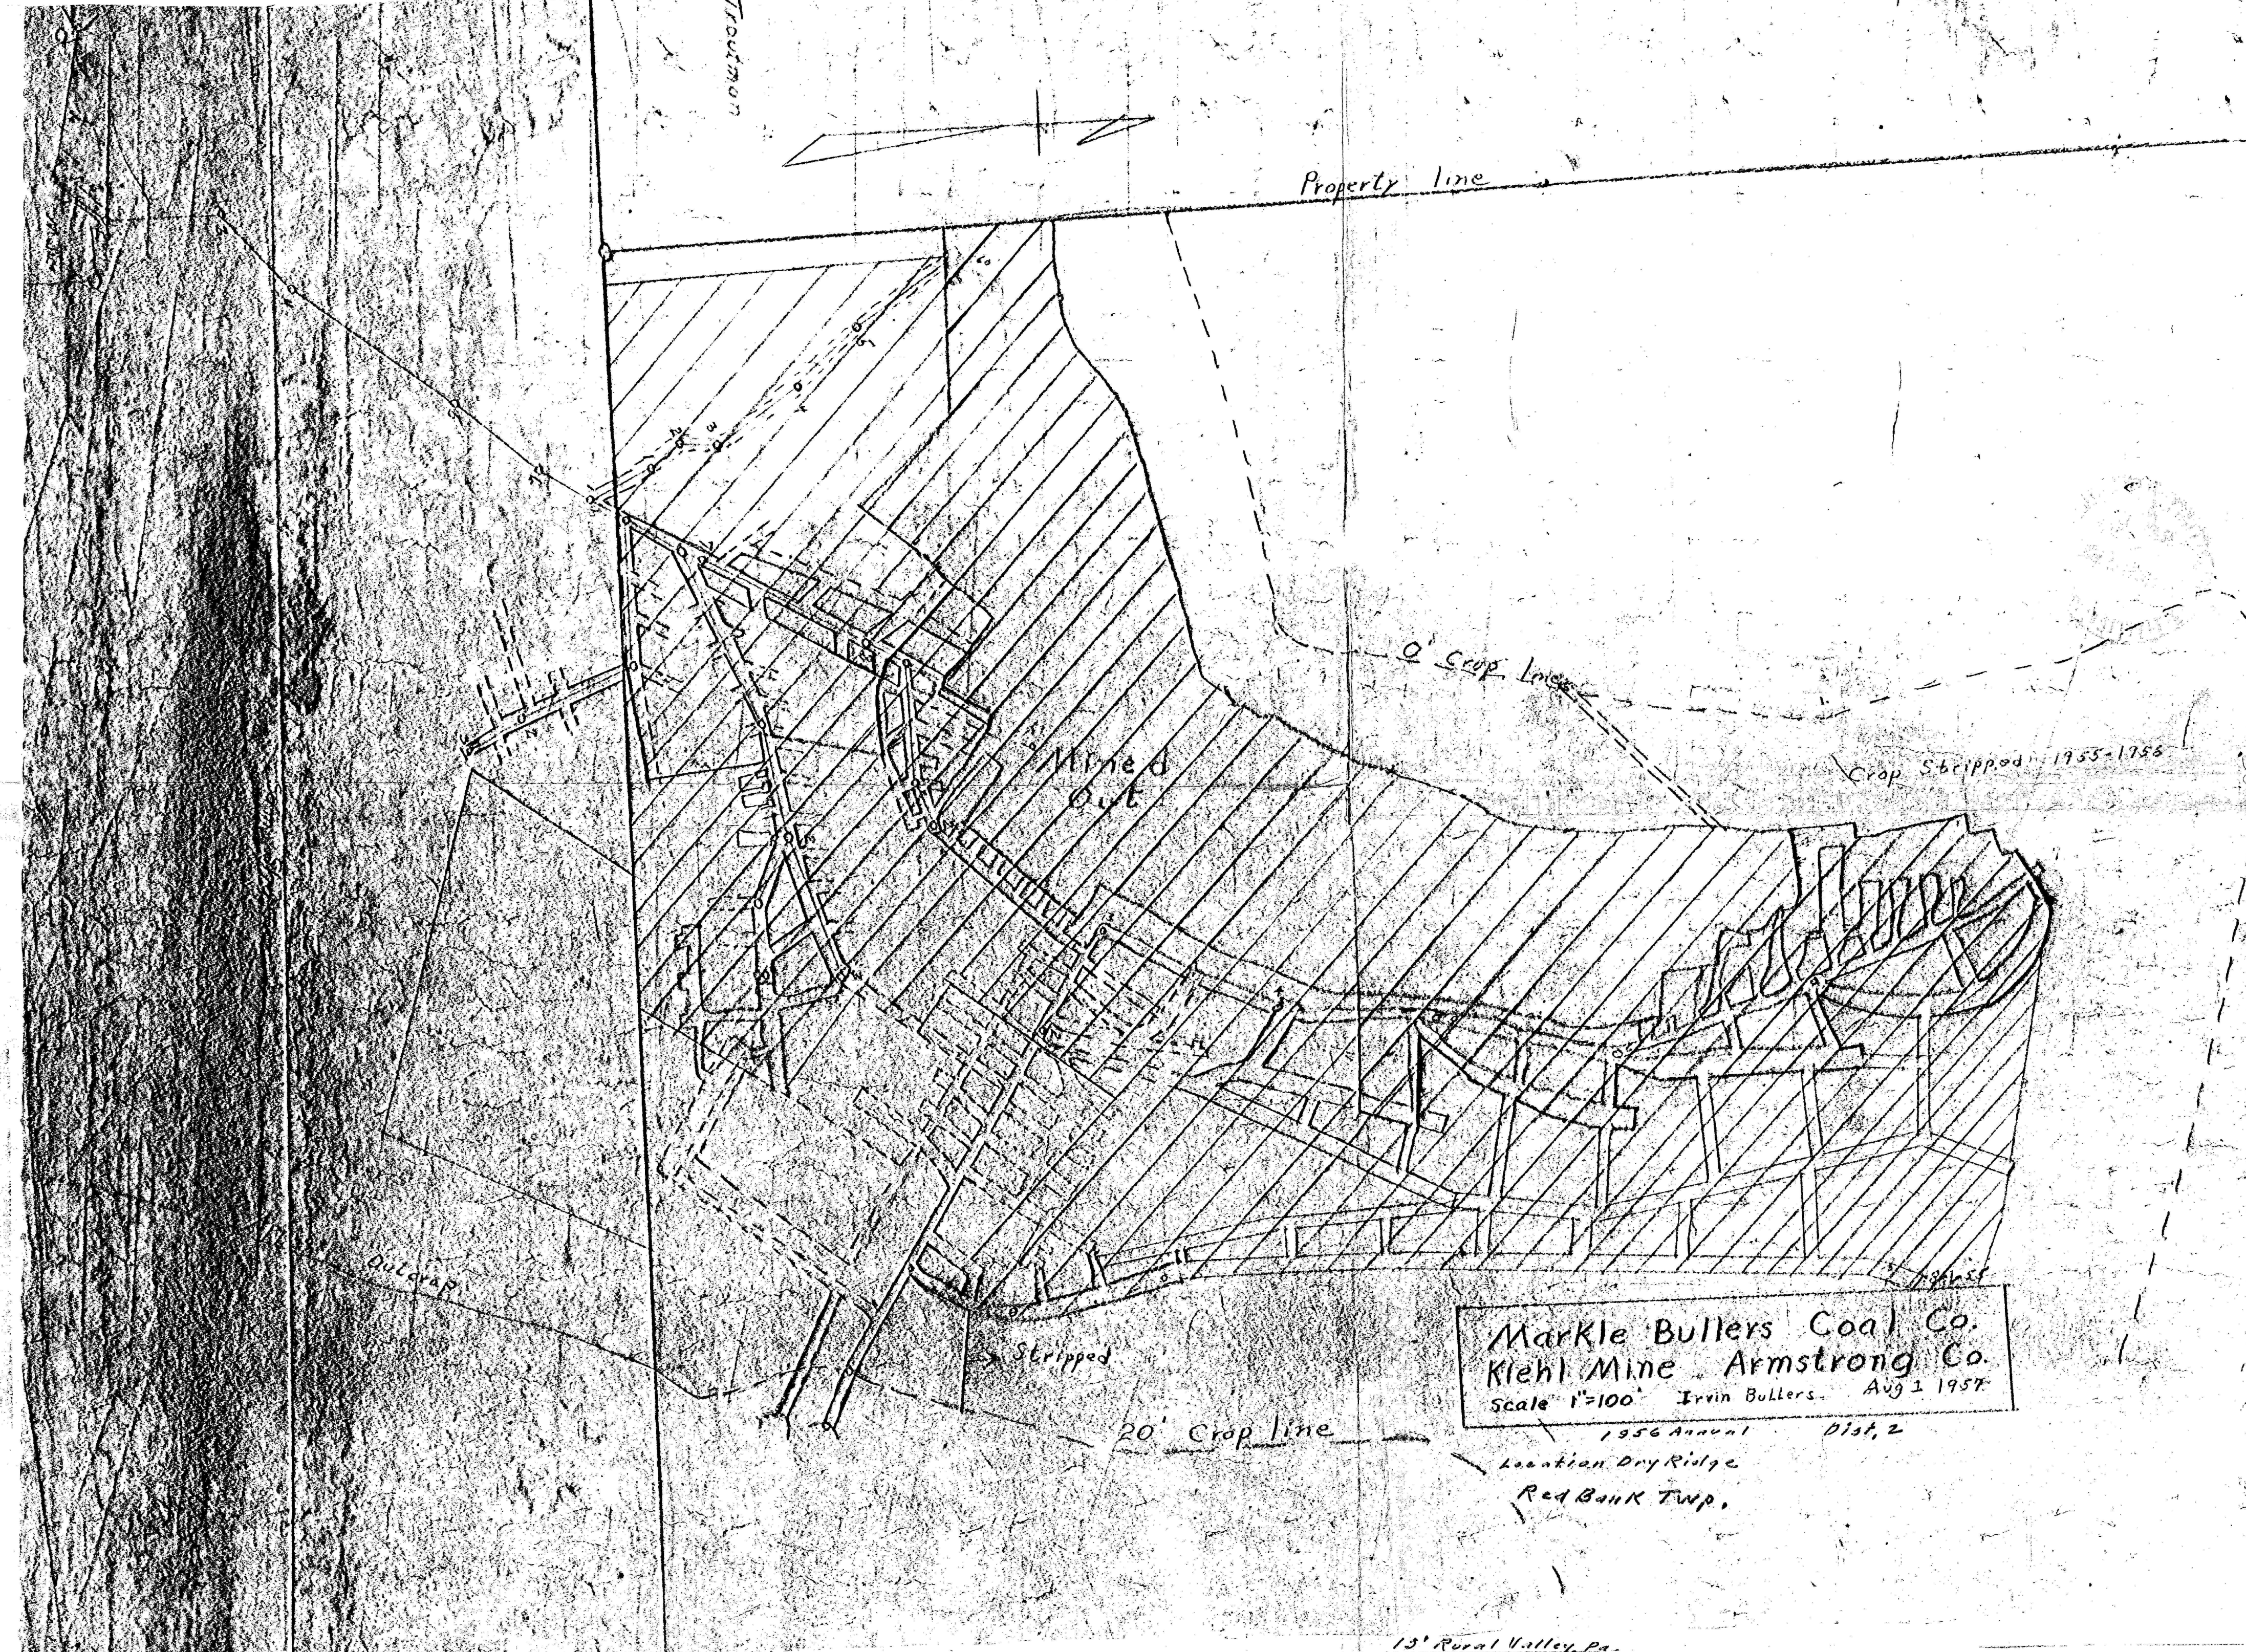

Markle Bullers Coal Co.
Klehl Mine Armstrong Co.
Scale 1"=100' Irvin Bullers. Aug 1 1957

1956 Annual Dist. 2
Leontian Dry Ridge
Red Bank Twp.

13 Rural Valley, Pa.