



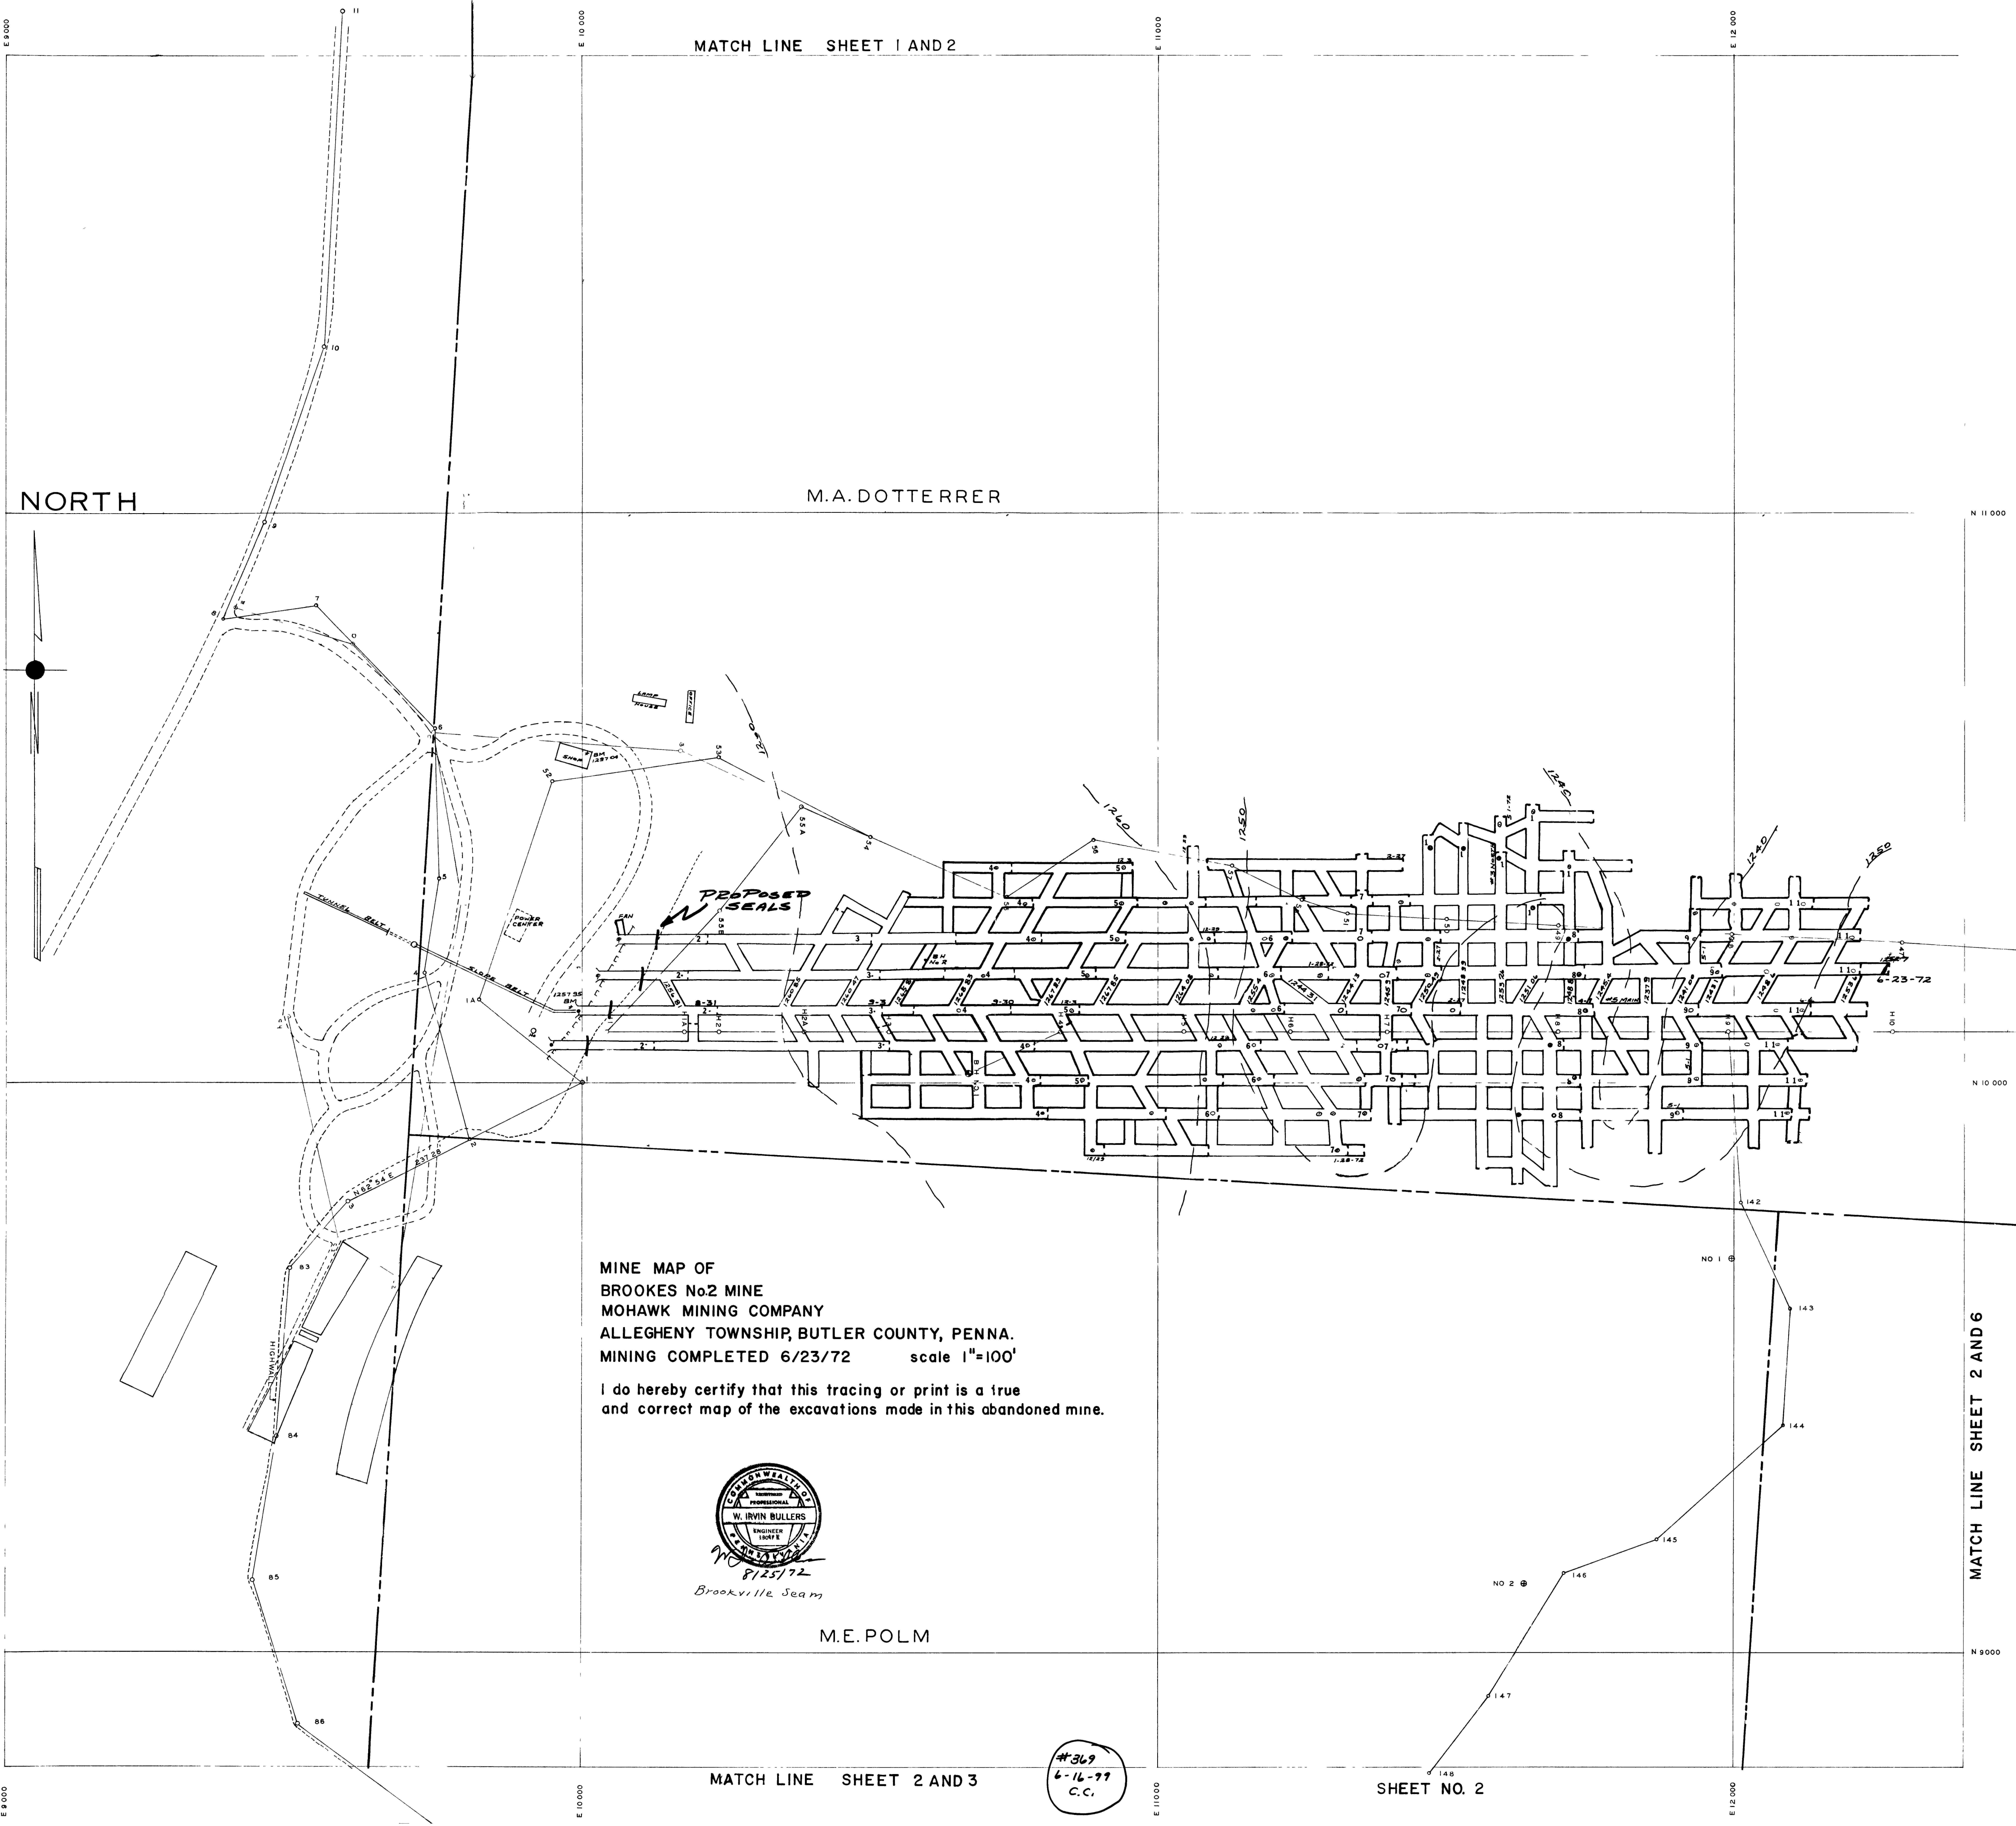

MINE MAP OF
BROOK'S No. 2 MINE
MOHAWK MINING COMPANY
ALLEGHENY TOWNSHIP, BUTLER COUNTY, PENNA.
MINING COMPLETED 6/23/72 scale 1"=100'

I do hereby certify that this tracing or print is a true
and correct map of the excavations made in this abandoned mine.

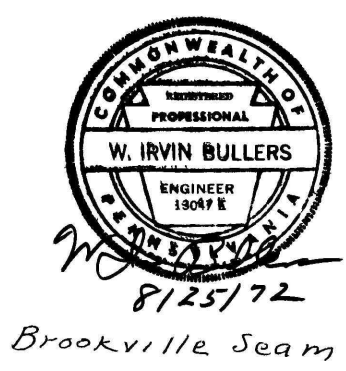

M.E. POLM

369
6-16-77
C.C.

MATCH LINE SHEET 2 AND 6