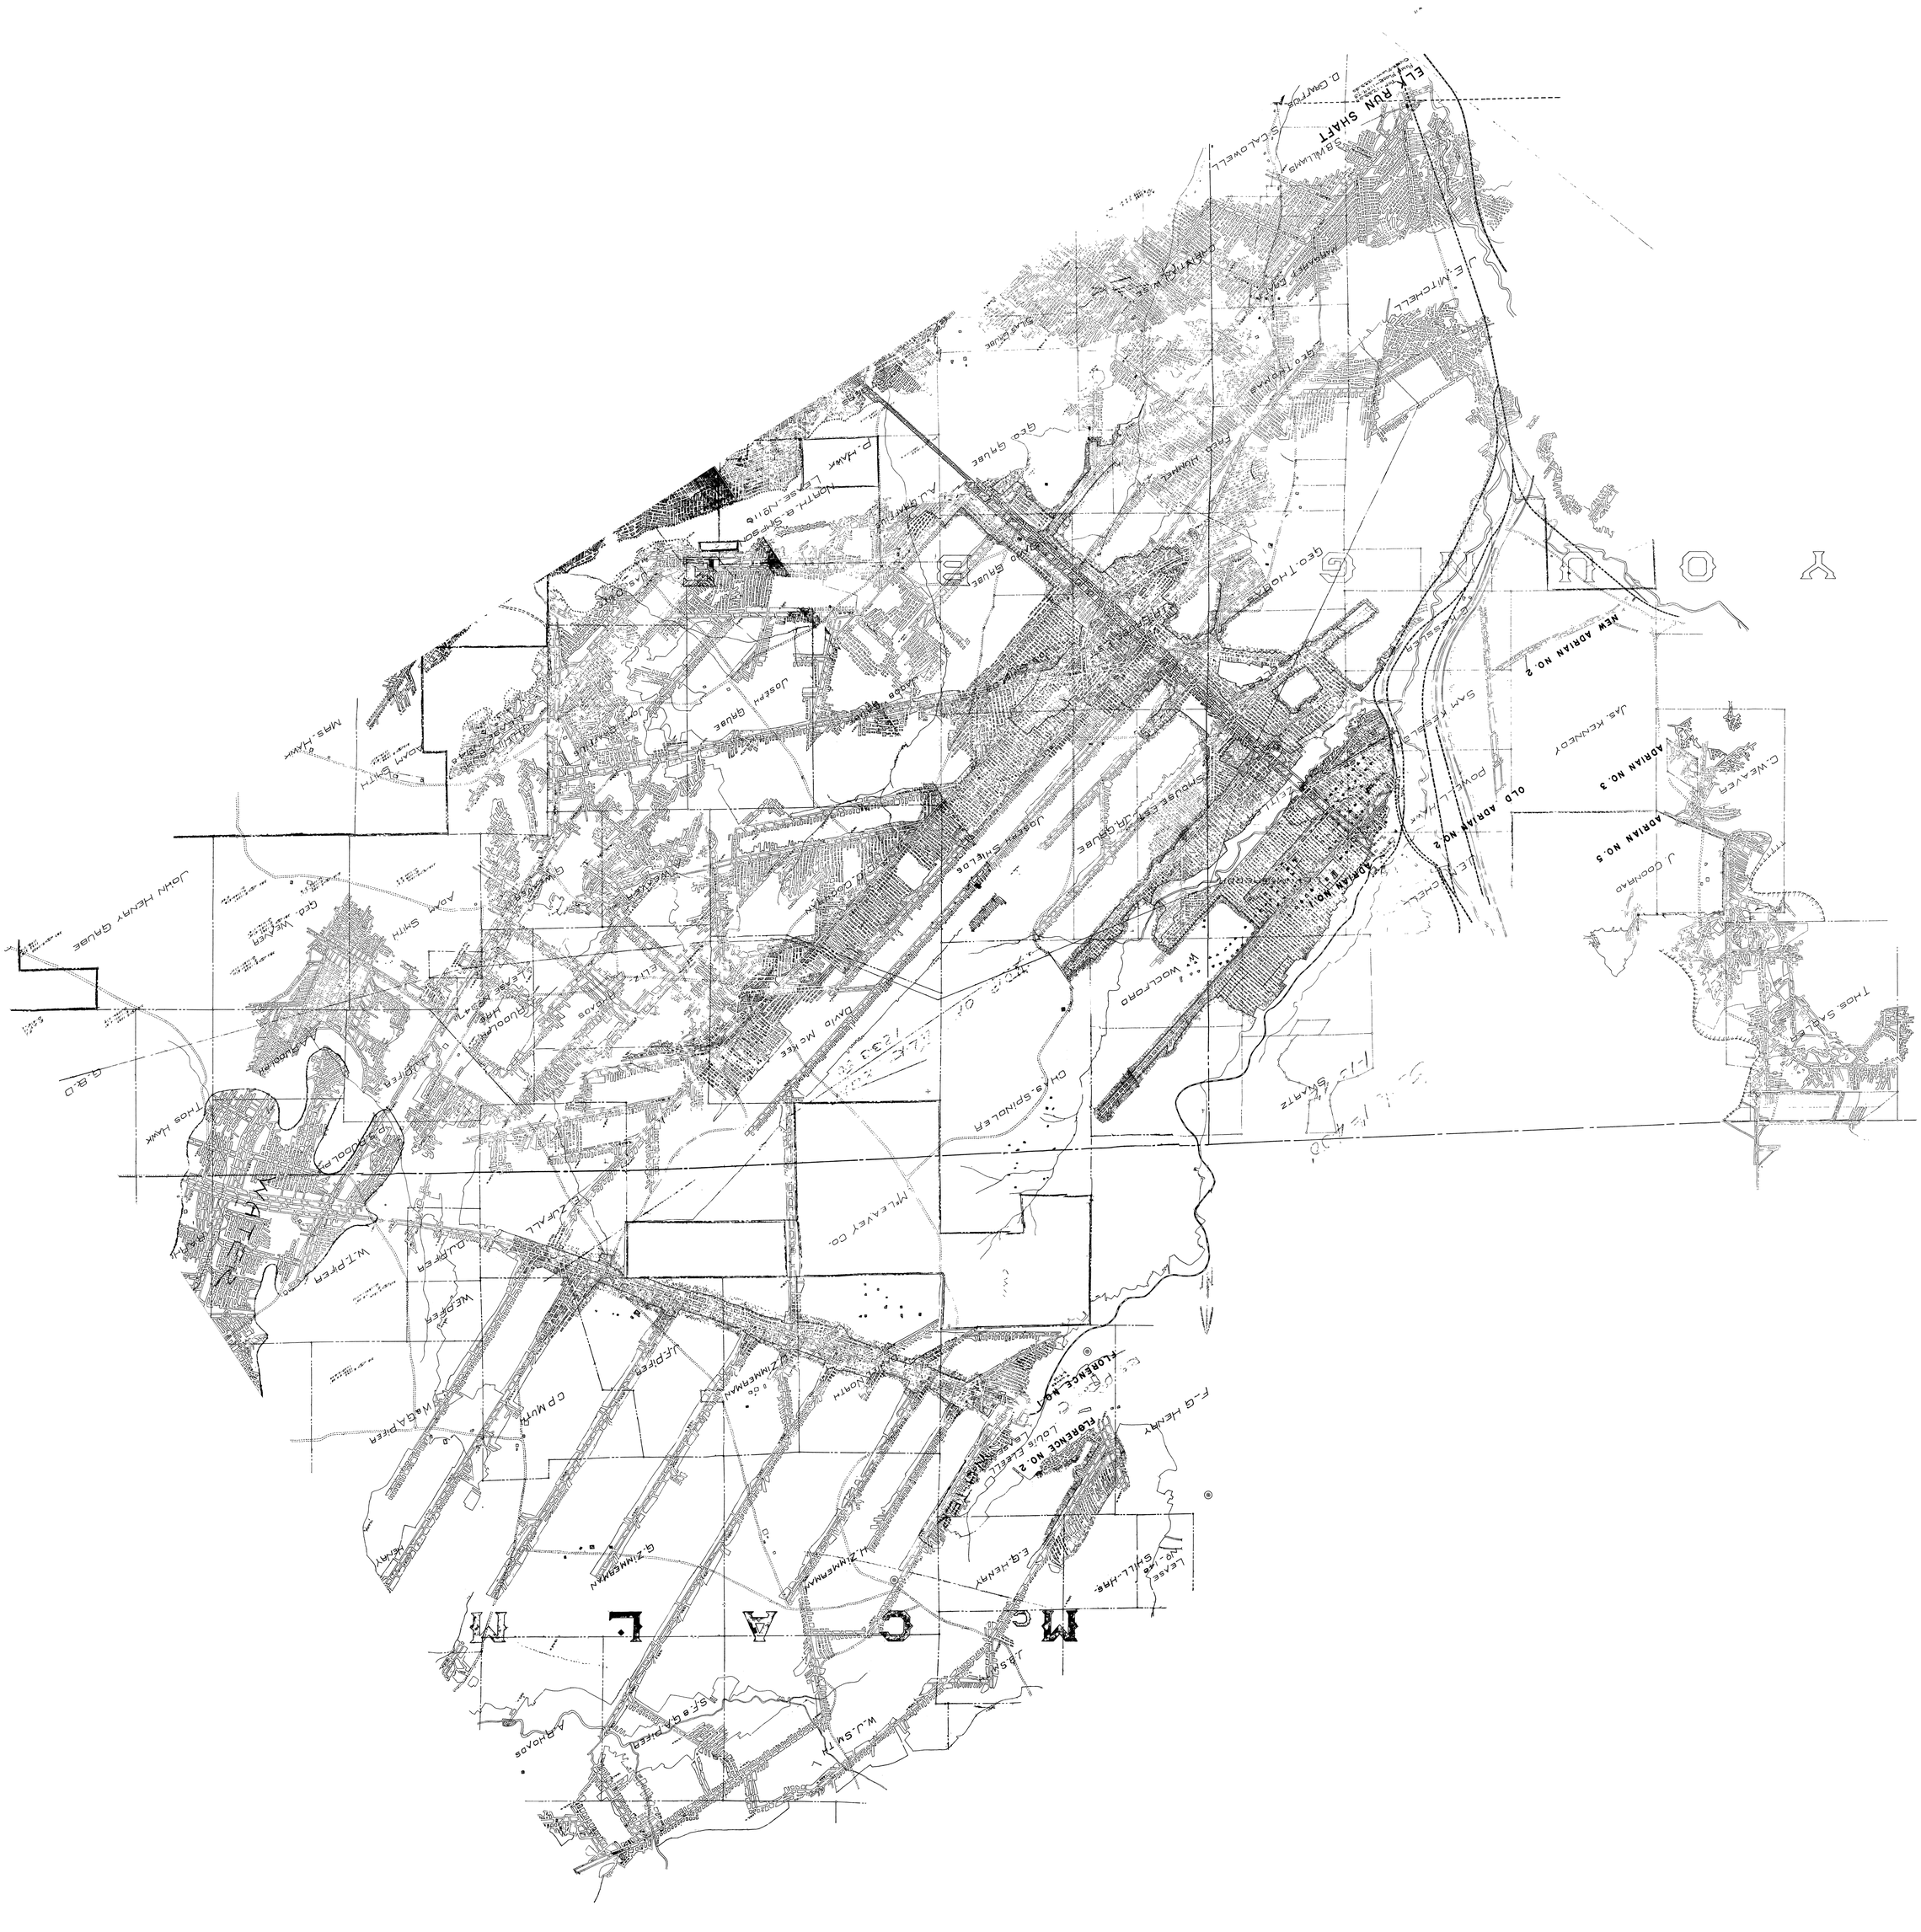
ELK RUN SHAFT
NEW ADRIAN NO. 2
OLD ADRIAN NO. 2
ADRIAN NO. 3
ADRIAN NO. 5
ADRIAN NO. 1
FLORENCE NO. 2
FLORENCE NO. 1
