


ELDER HEIRS

L. CROYLE

ALLEGHENY INDUSTRIES INC.

ELDER HEIRS

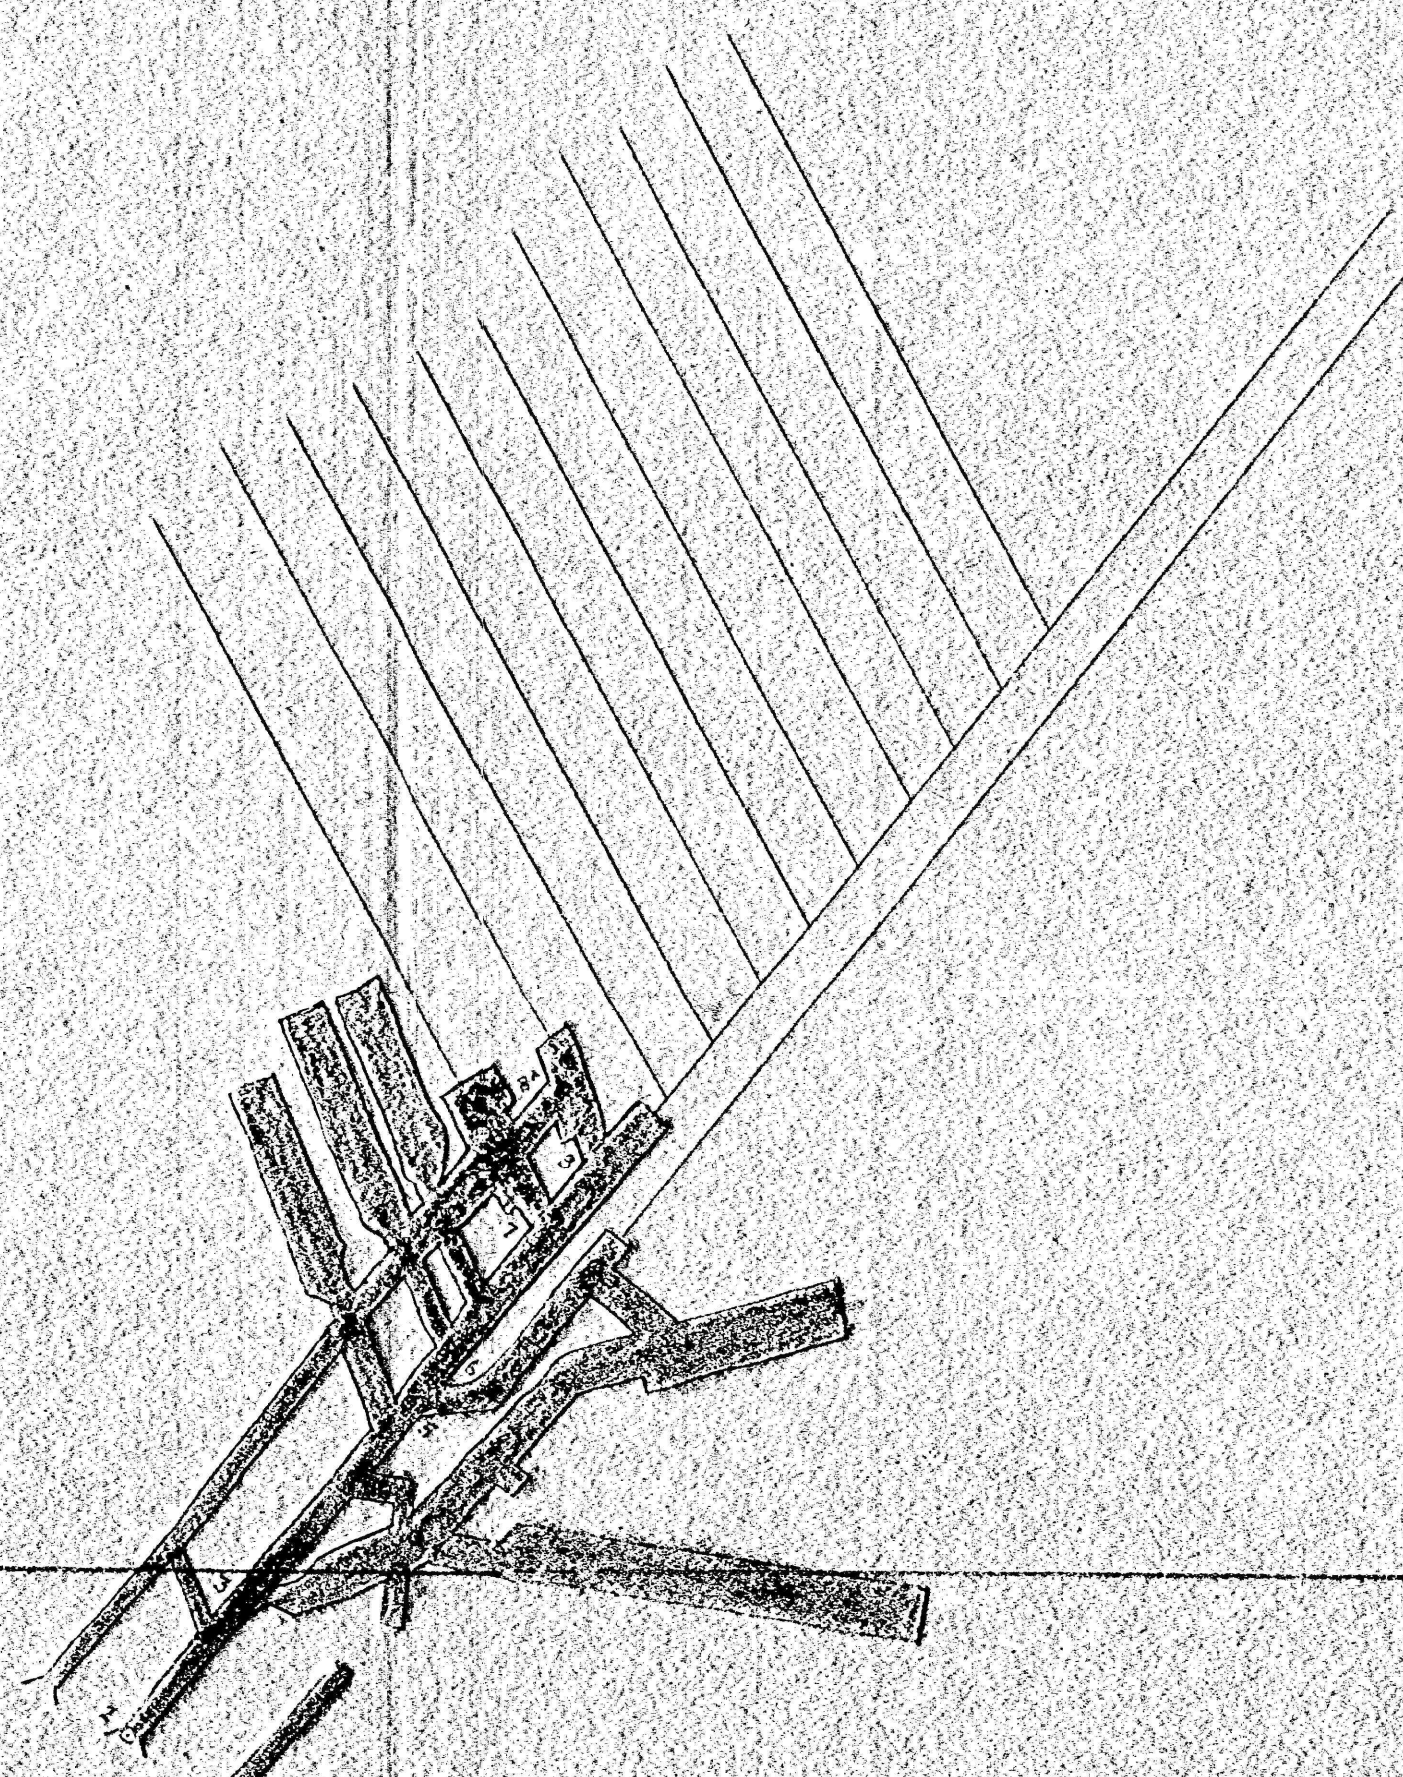

BRADY FOX

◇ TIPPLE

UPPER FREEPORT WORKINGS
WILLIAM SCHAWL COAL CO.

BOGGS TWP. ARMSTRONG CO. PA.

SCALE: 1" = 100' DATE: 10-1-57

