


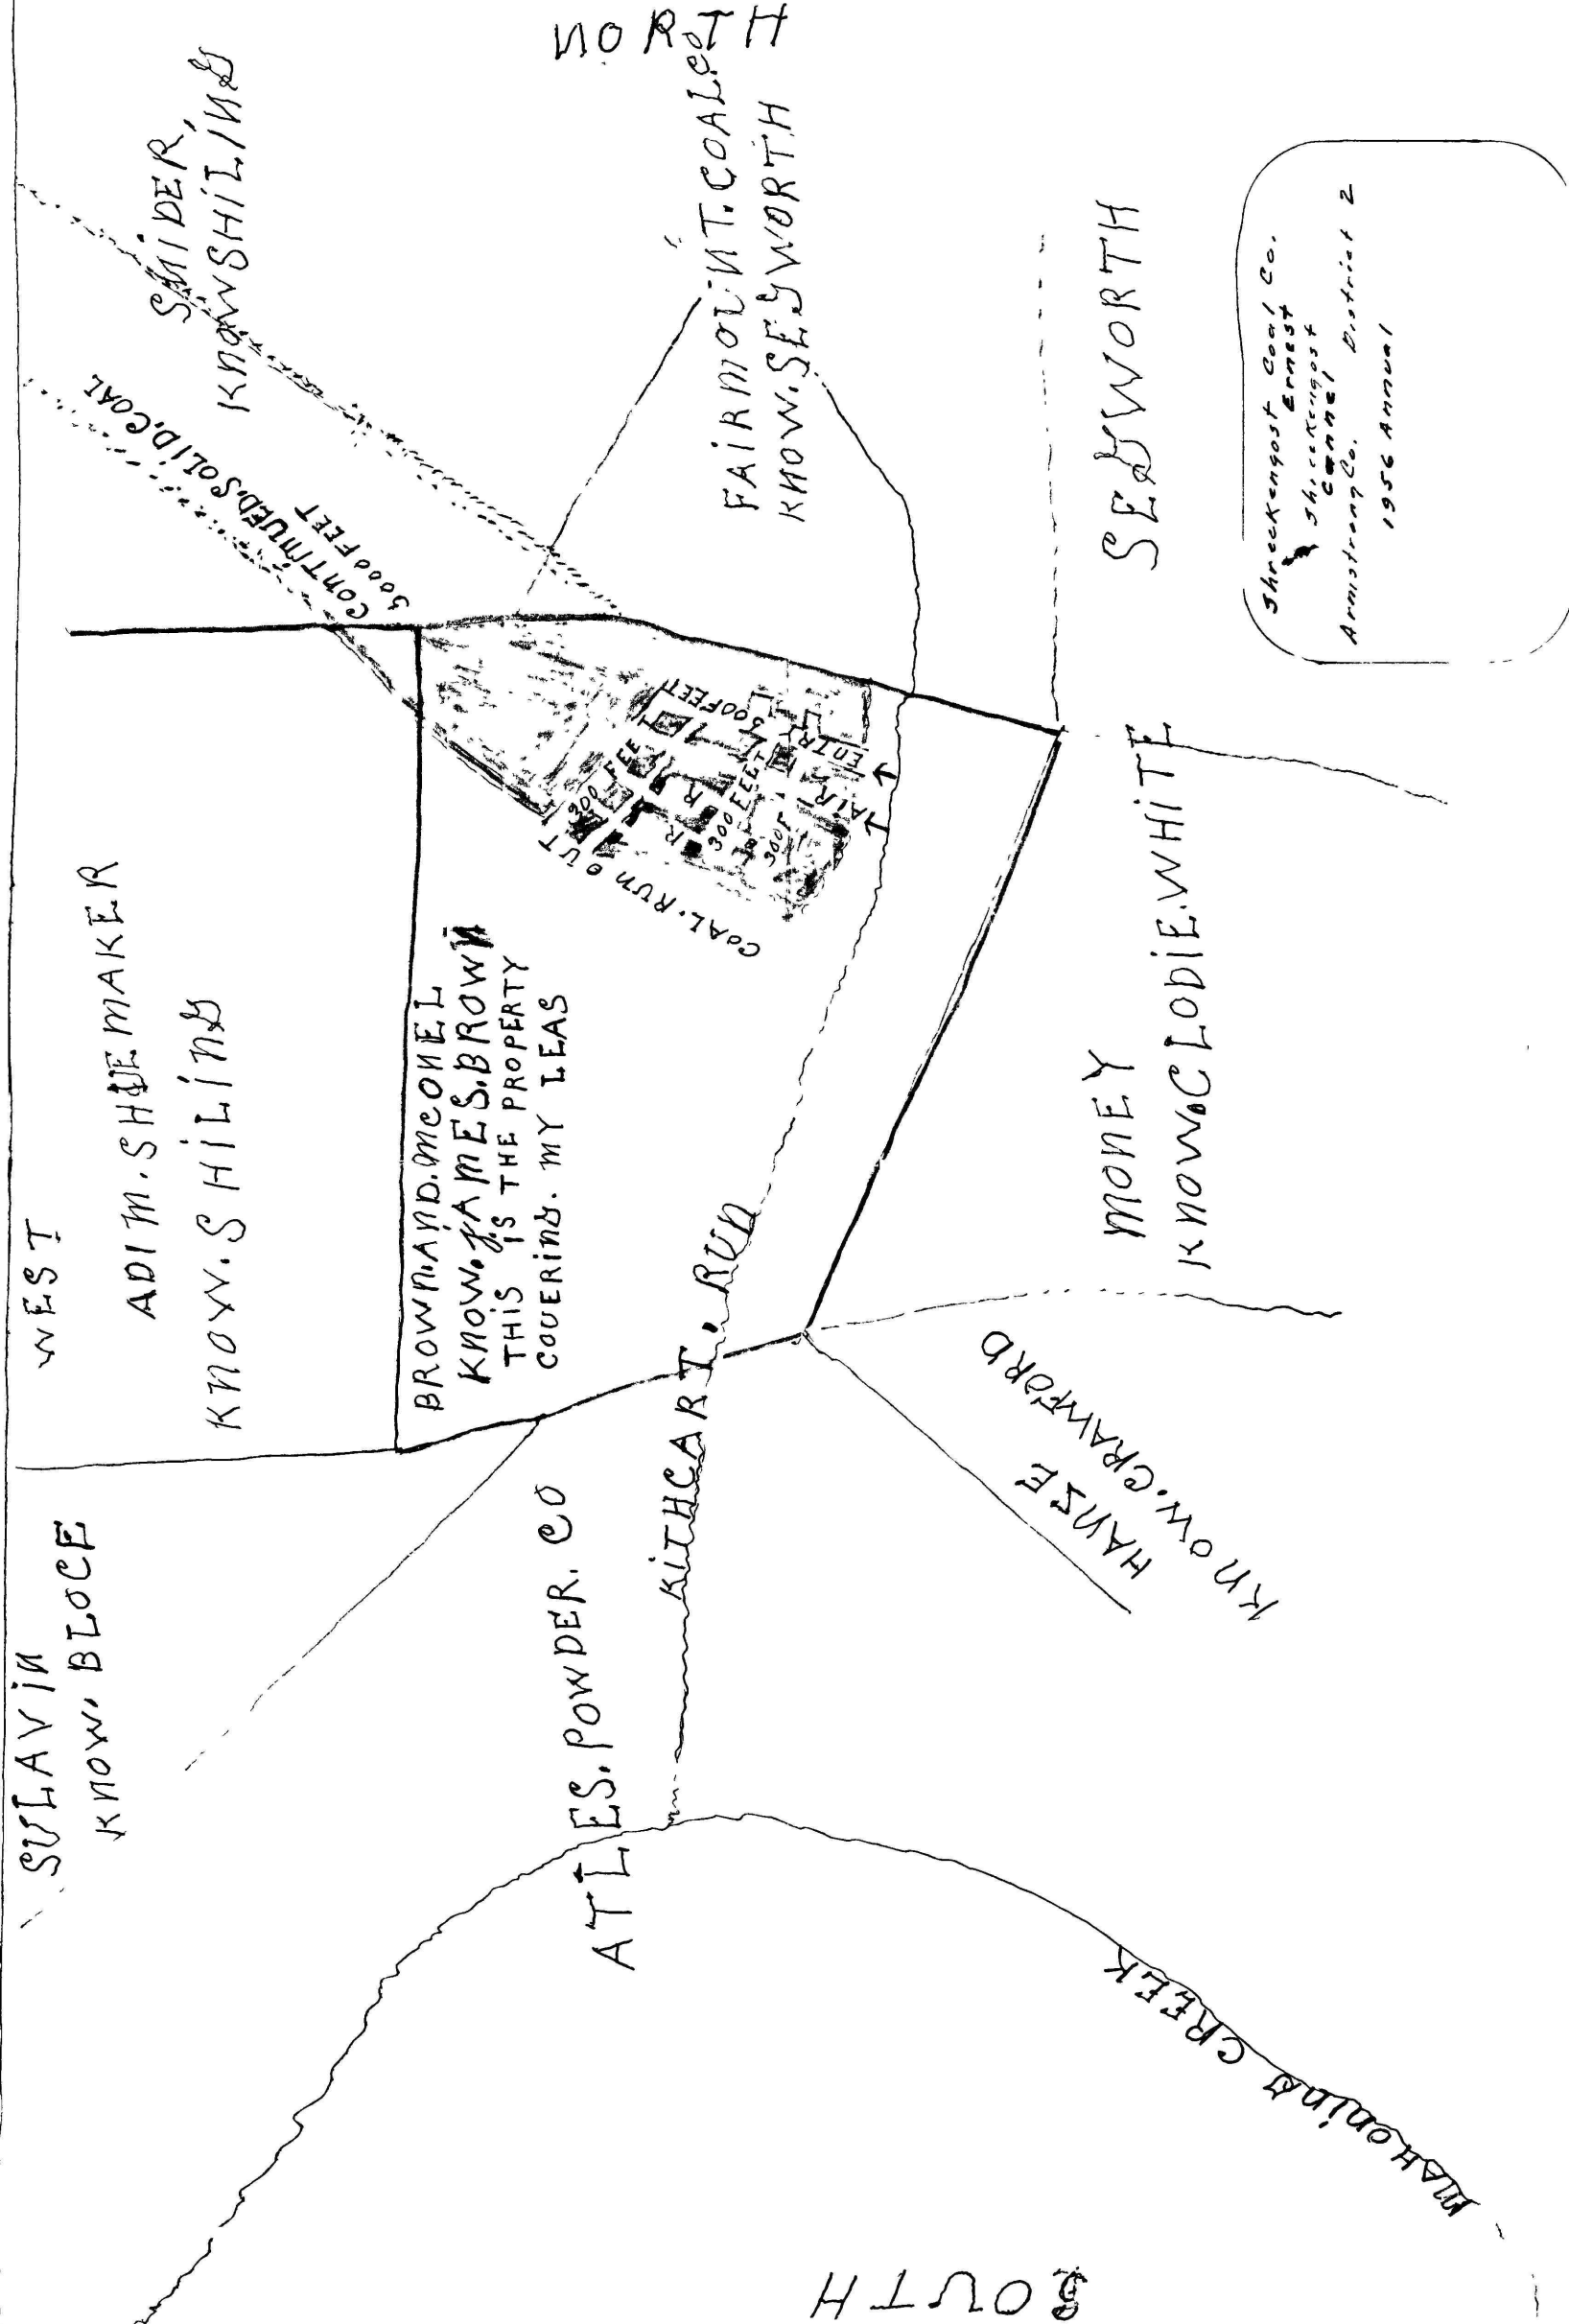

Shreckengost Coal Co.
Shreckengost Ernest
Shreckengost Ernest
Armstrong Co. District 2
1956 Annual

ERNEST SHRECKENBOST CANNEL MINE covers with of seam is 4 to 8 hundred feet wide 12 feet high
THIS. PROPERTY. ISS. IN. MAHONING TOWNSHIP. ARMSTRONG CO

EAST